



MS # 555

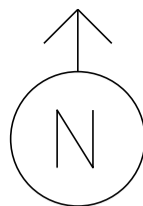

MOBIL STATION

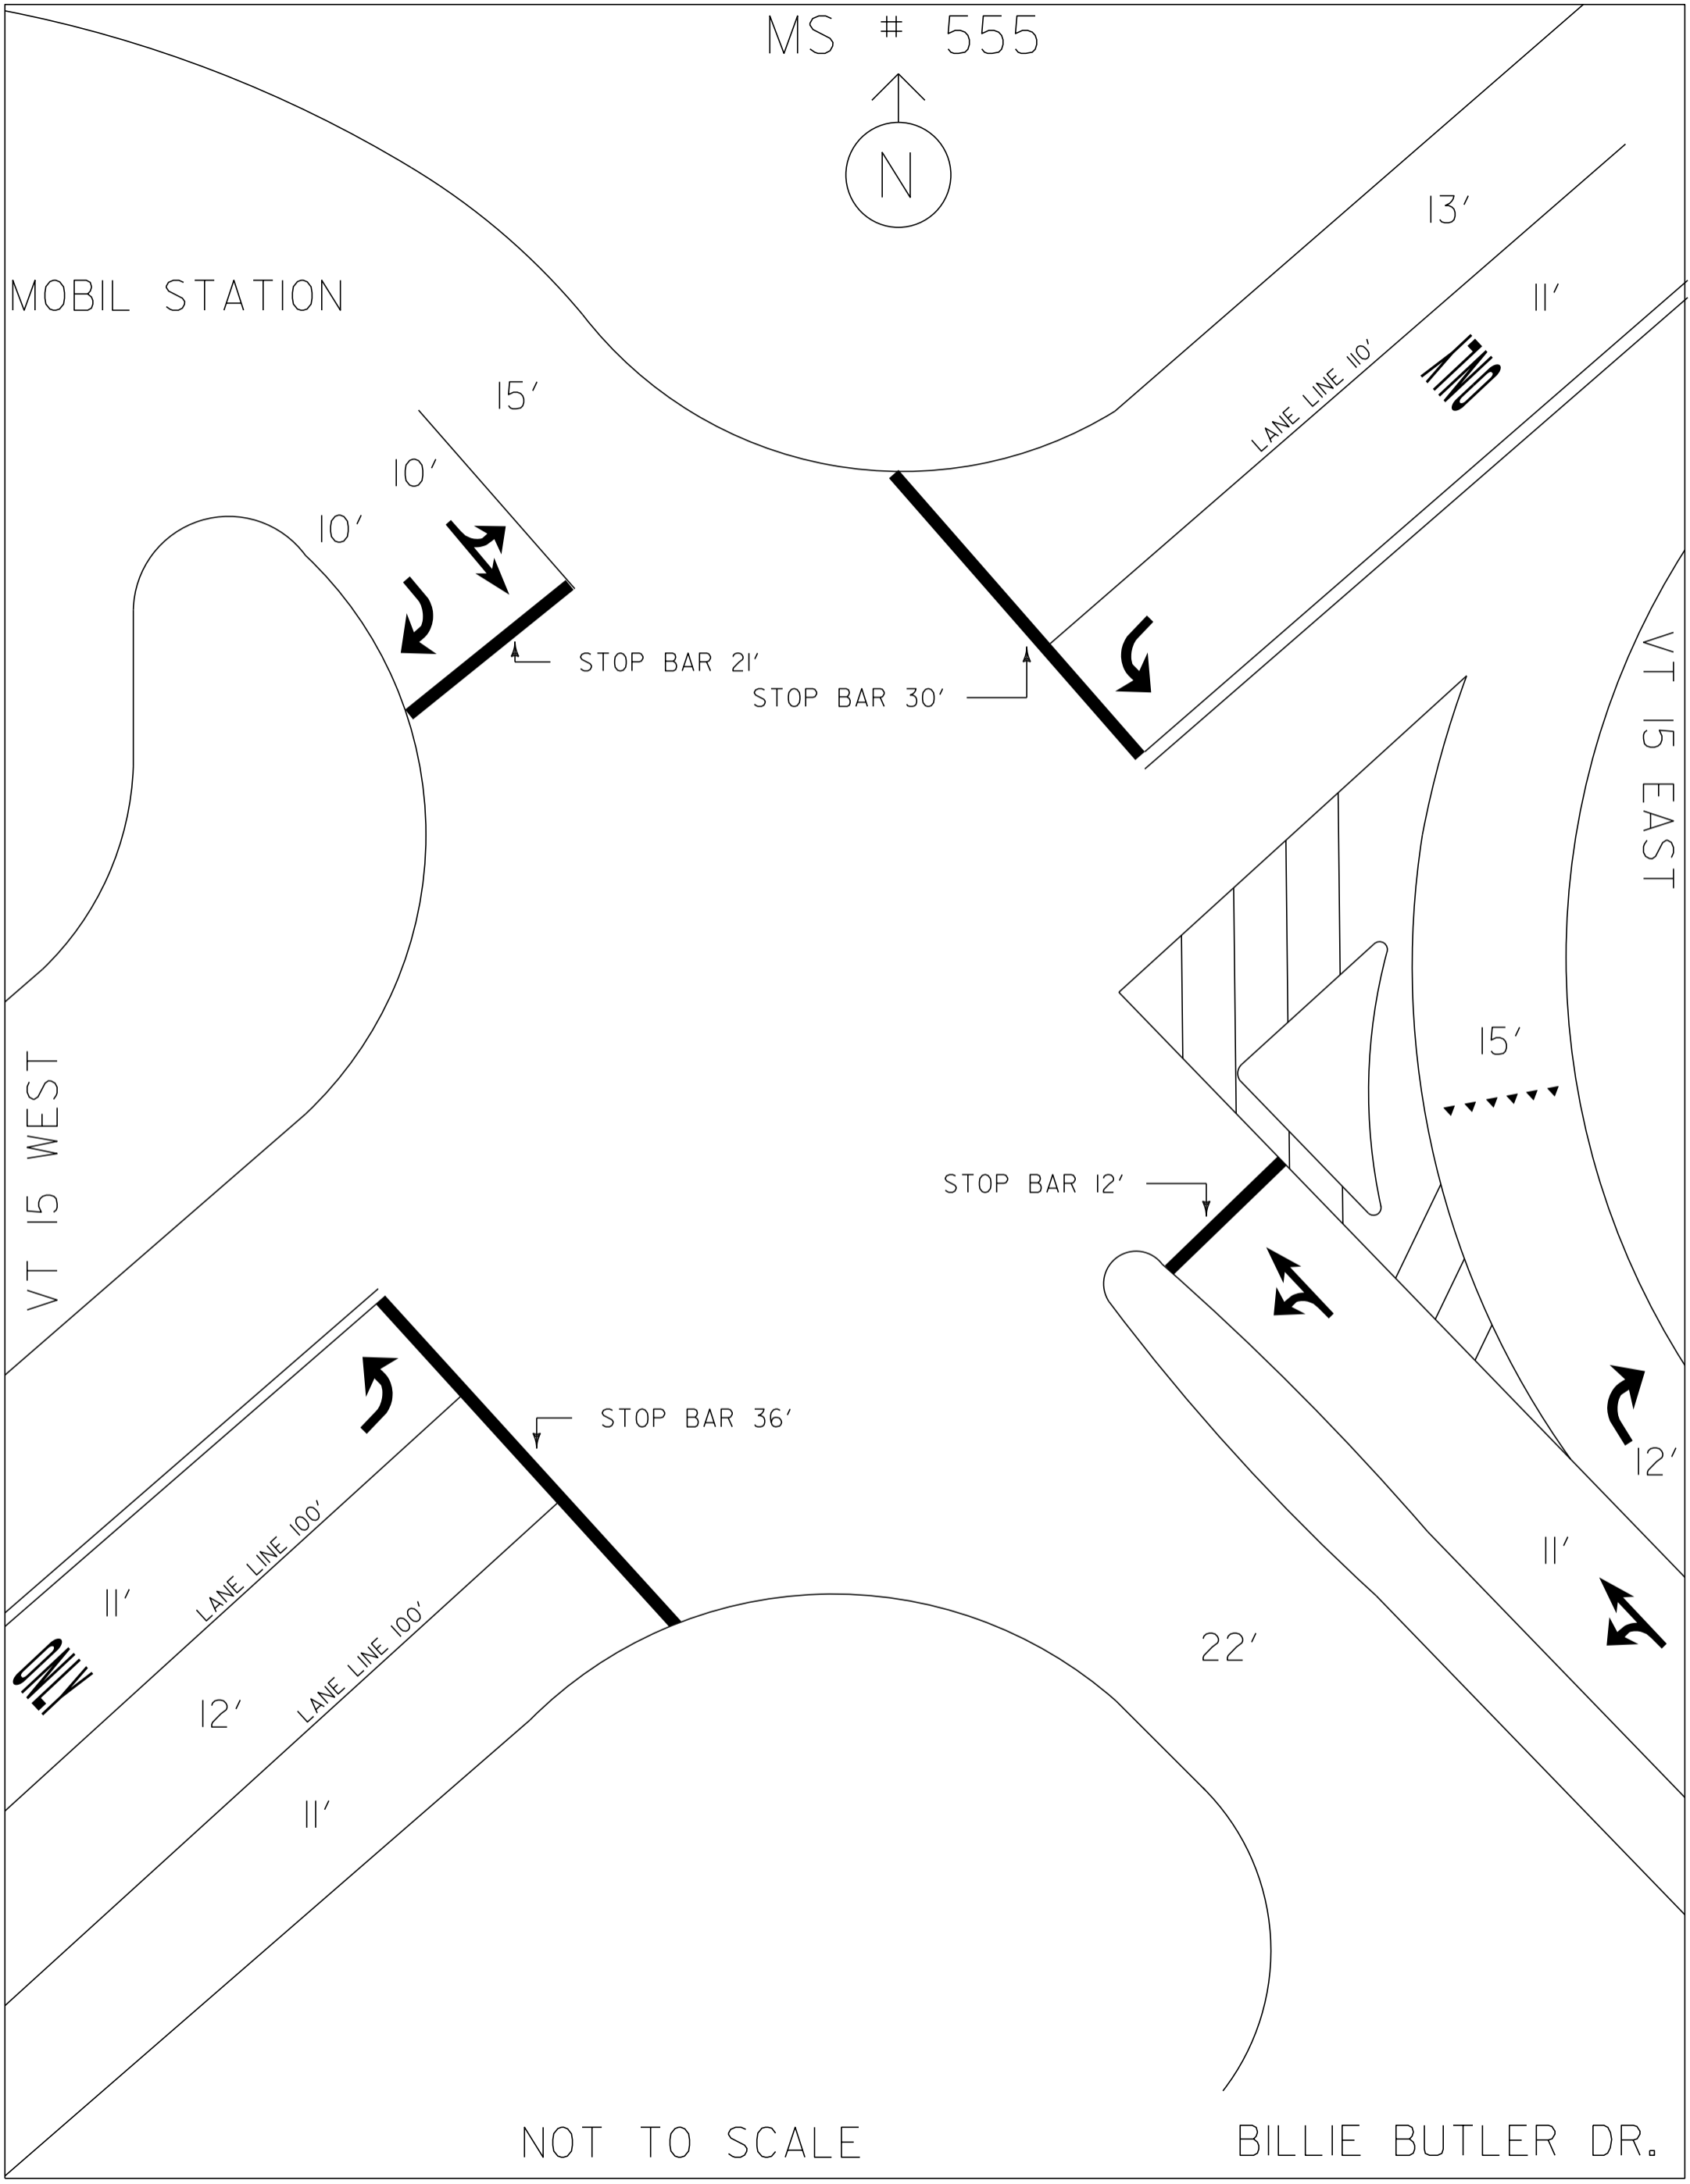

VT 15 WEST

VT 15 EAST

LANE LINE 100'

LANE LINE 100'

LANE LINE 100'

BILLIE BUTLER DR.

NOT TO SCALE

STOP BAR 21'

STOP BAR 30'

STOP BAR 36'

STOP BAR 12'

ONLY

ONLY