


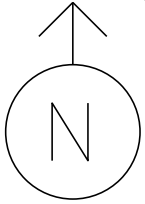 


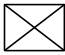

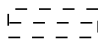


MS # 564




VT 289 EAST
OFF RAMP

-  CONTROL BOX
-  LOOP DETECTION
-  STANCHION
-  ROADWAY SIGN
-  = 
-  = 

VT 117 WEST

VT 117 EAST

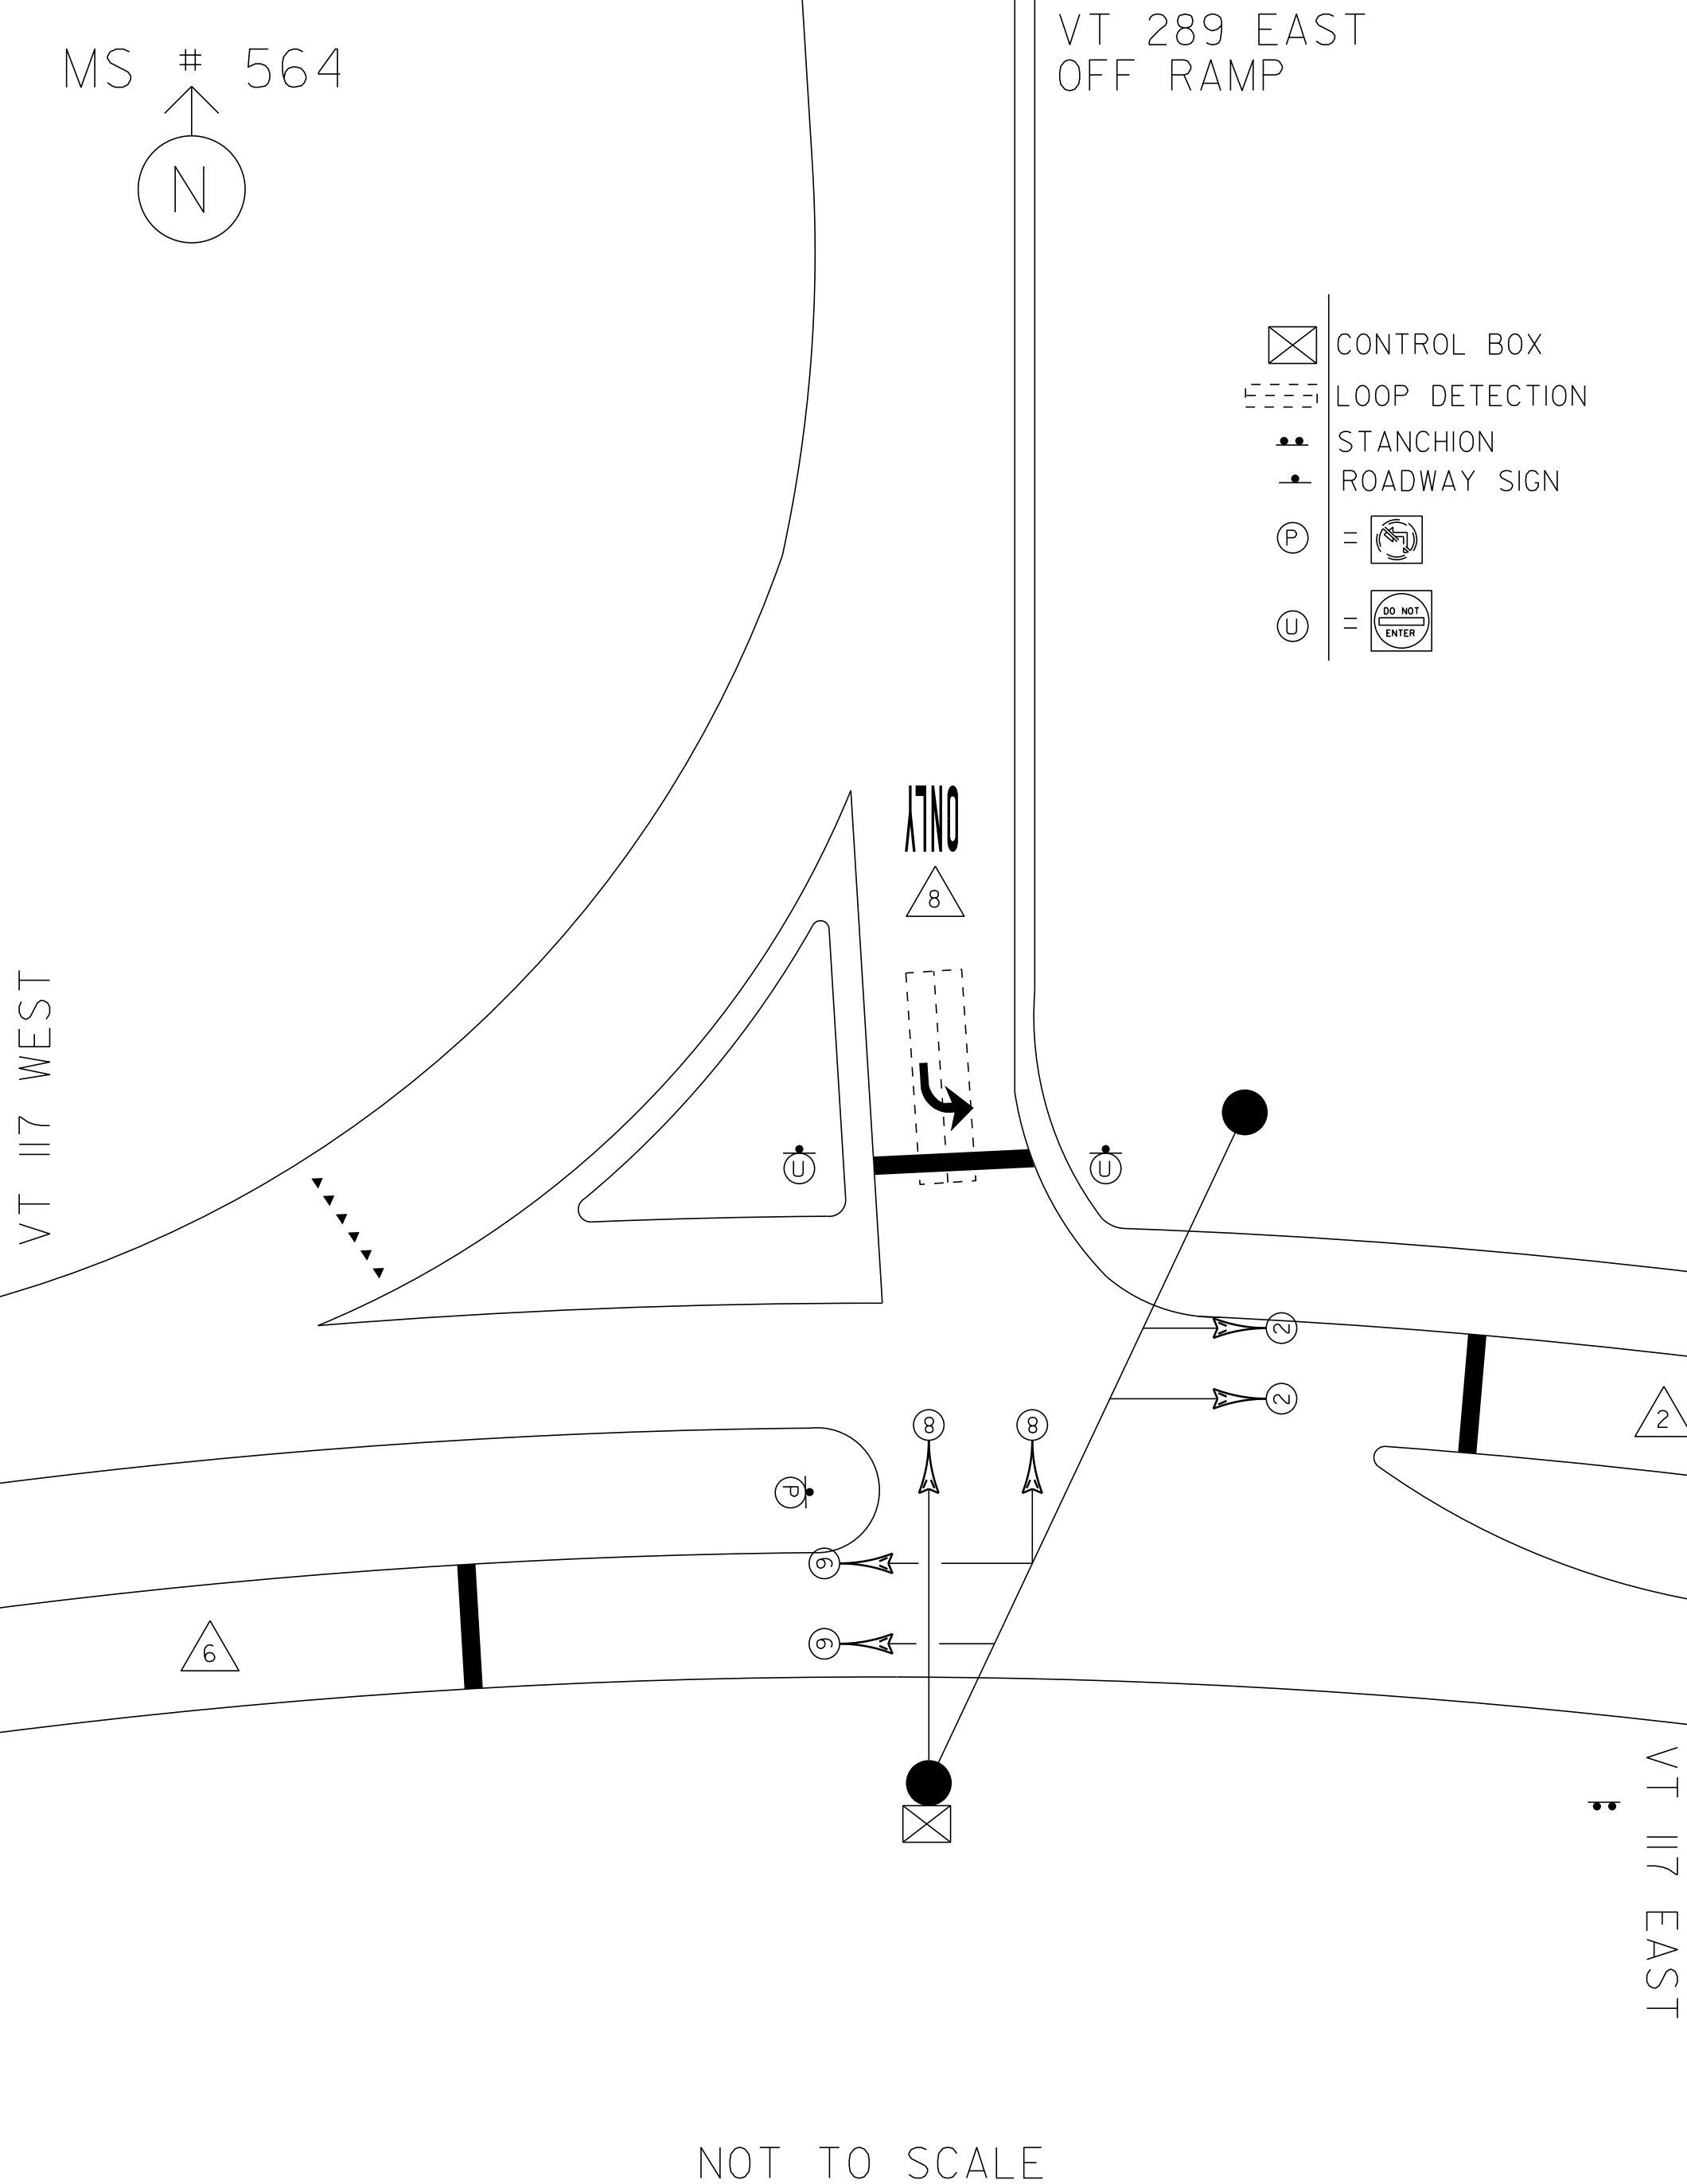

NOT TO SCALE