



MS # 565

US 2 WEST

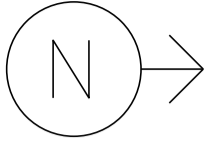

HARVEST LANE

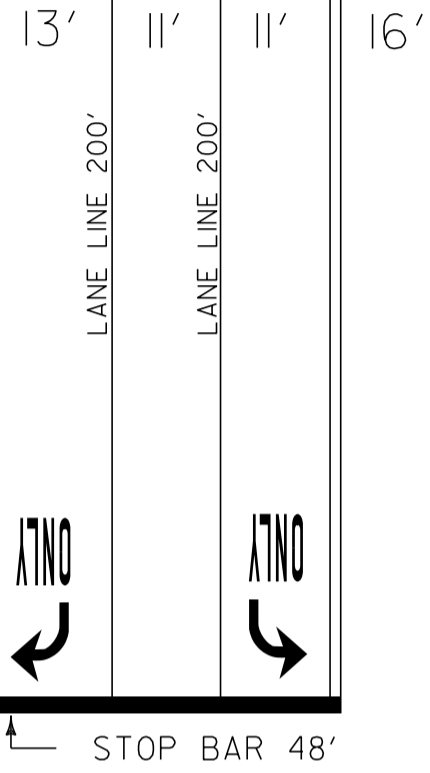

16'

STOP BAR 22'

11'
LANE LINE 215'

STOP BAR 11'

11'

STOP BAR 13'

CROSSWALK 54'

11'
LANE LINE 40'
11'


12'

BLAIR PARK

CROSSWALK 50'

STOP BAR 23'

16'

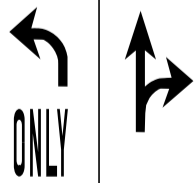

LANE LINE 120'

11'

12'

US 2 EAST