


MS # 575



VT 116 NORTH


12'

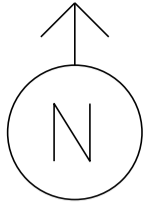

STOP BAR 12'

ONE WAY STREET

CROSSWALK 78'

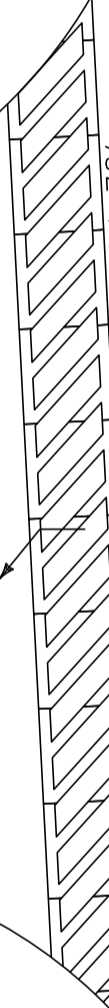

STOP BAR 25'

STOP BAR 16'

CROSSWALK 17'



15'


LANE LINE 75'



11' ONLY

11' ONLY

CROSSWALK 50'

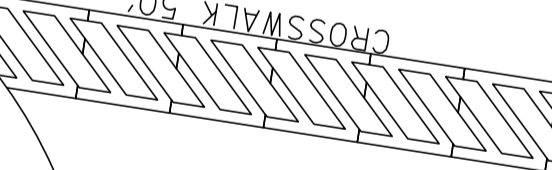

STOP BAR 13'



12'

CHARLOTTE RD.

VT 116 SOUTH

NOT TO SCALE