


MS # 578

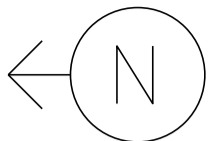

US 2 EAST

11' 11' 11'

LANE LINE 205'

ONLY




STOP BAR 24'

SIMONS

12'

12'

STOP BAR 18'

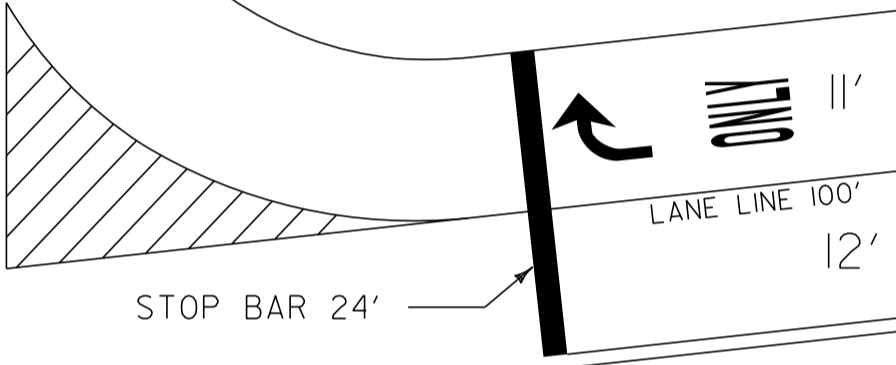

11'

LANE LINE 100'

12'

STOP BAR 24'

12'

MAPLE TREE PLACE

STOP BAR 22'



ONLY

LANE LINE 100'

US 2 WEST

12'

11'

11'

NOT TO SCALE