
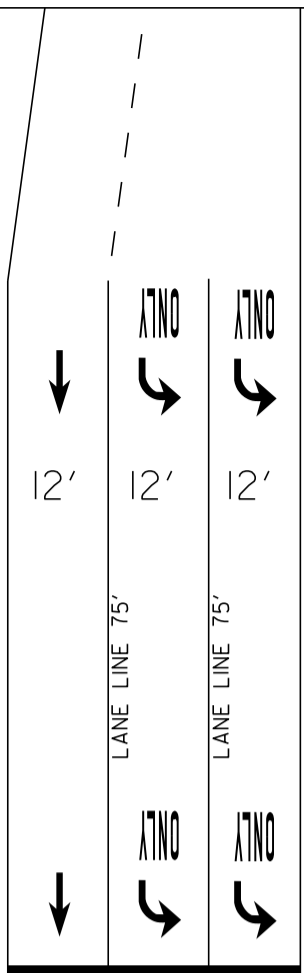


US 7 NORTH

MS # 804

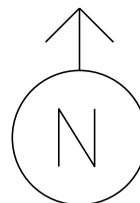

STOP BAR 22'

STOP BAR 22'

STOP BAR 22'

12'

12'

12'



US 7 SOUTH

NOT TO SCALE

VT 207 NORTH

YIELD

LANE LINE 75'

LANE LINE 75'

ONLY

ONLY

