


12-16-2011  
RADAR DETECTORS

WHITE - SOUTH  
PURPLE - EAST  
BLUE - NORTH  
RED - WEST

RADAR STOP BAR DETECTION SENSOR

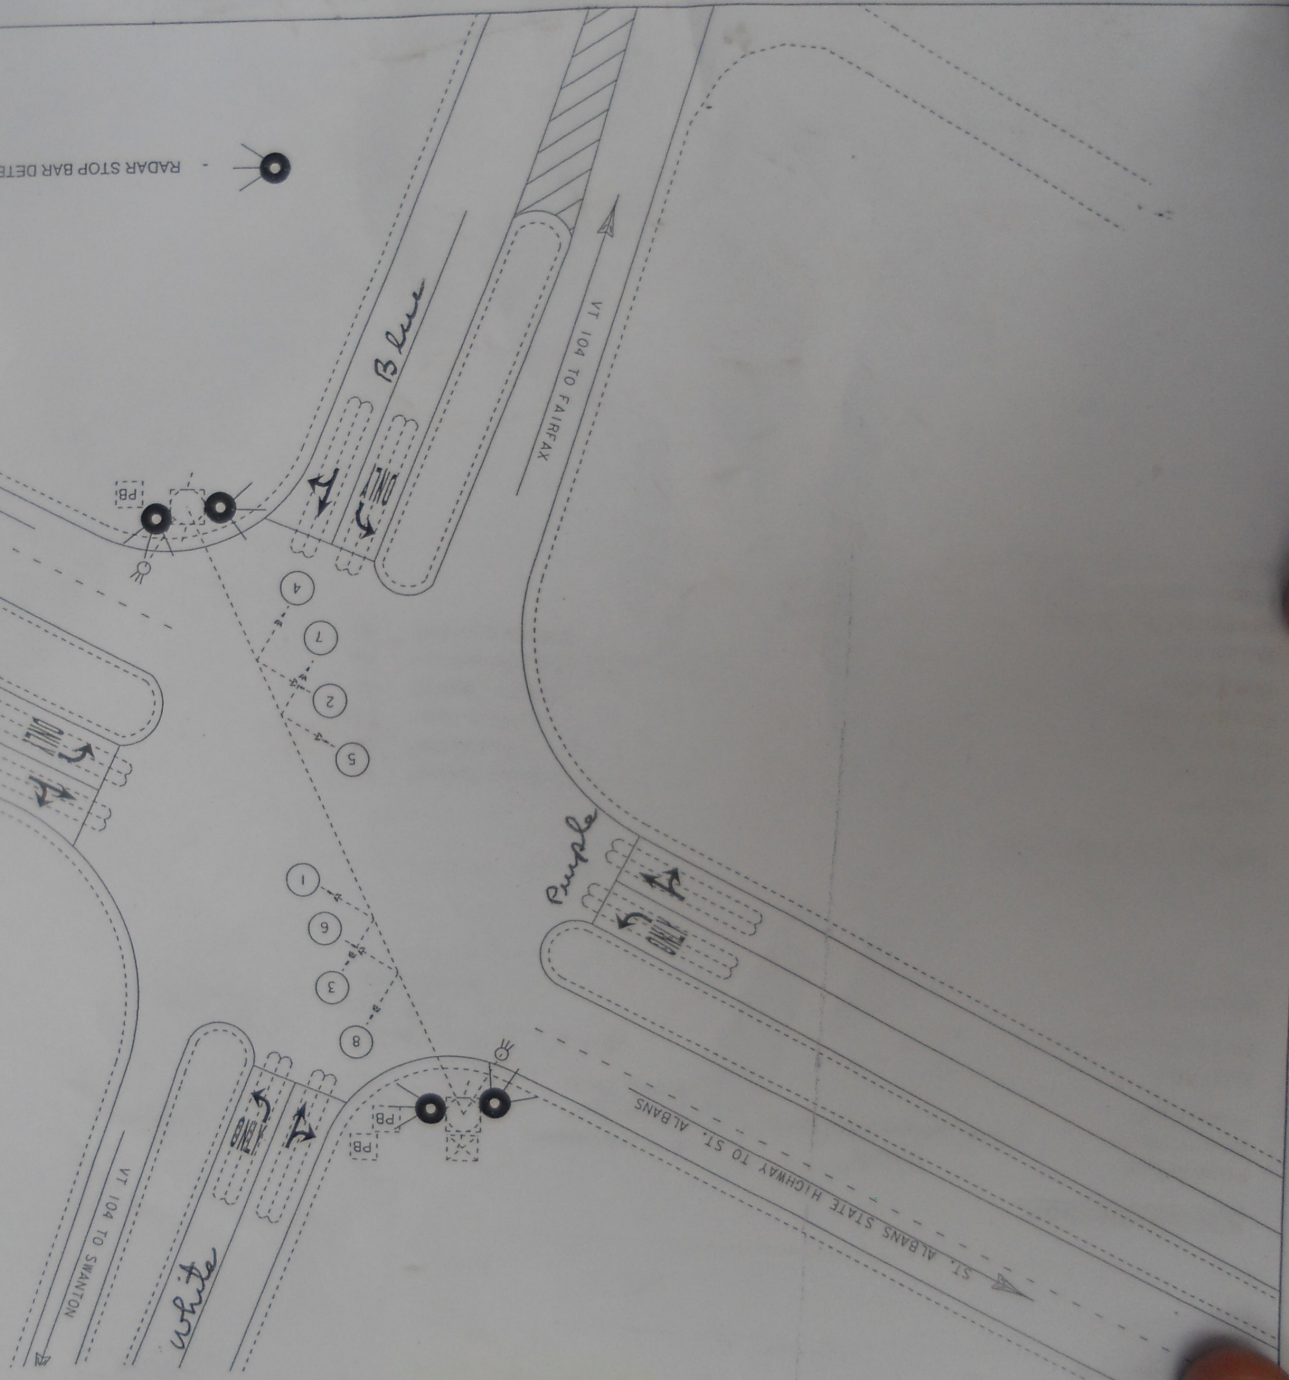

OriginalTurnOnDate  
GPSY:  
001.584  
V104-0613  
MajorRouteMajRD:  
0613  
Franklin  
TOWN