






MS # 813

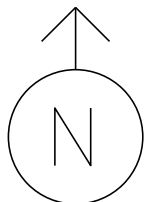

VT-104 NORTH

ST ALBANS HIGHWAY

- RADAR DETECTOR
- CONTROL BOX
- RADAR DETECTION
- PULL BOX
- LUMINAIRE
- ROADWAY SIGN
- =
- =

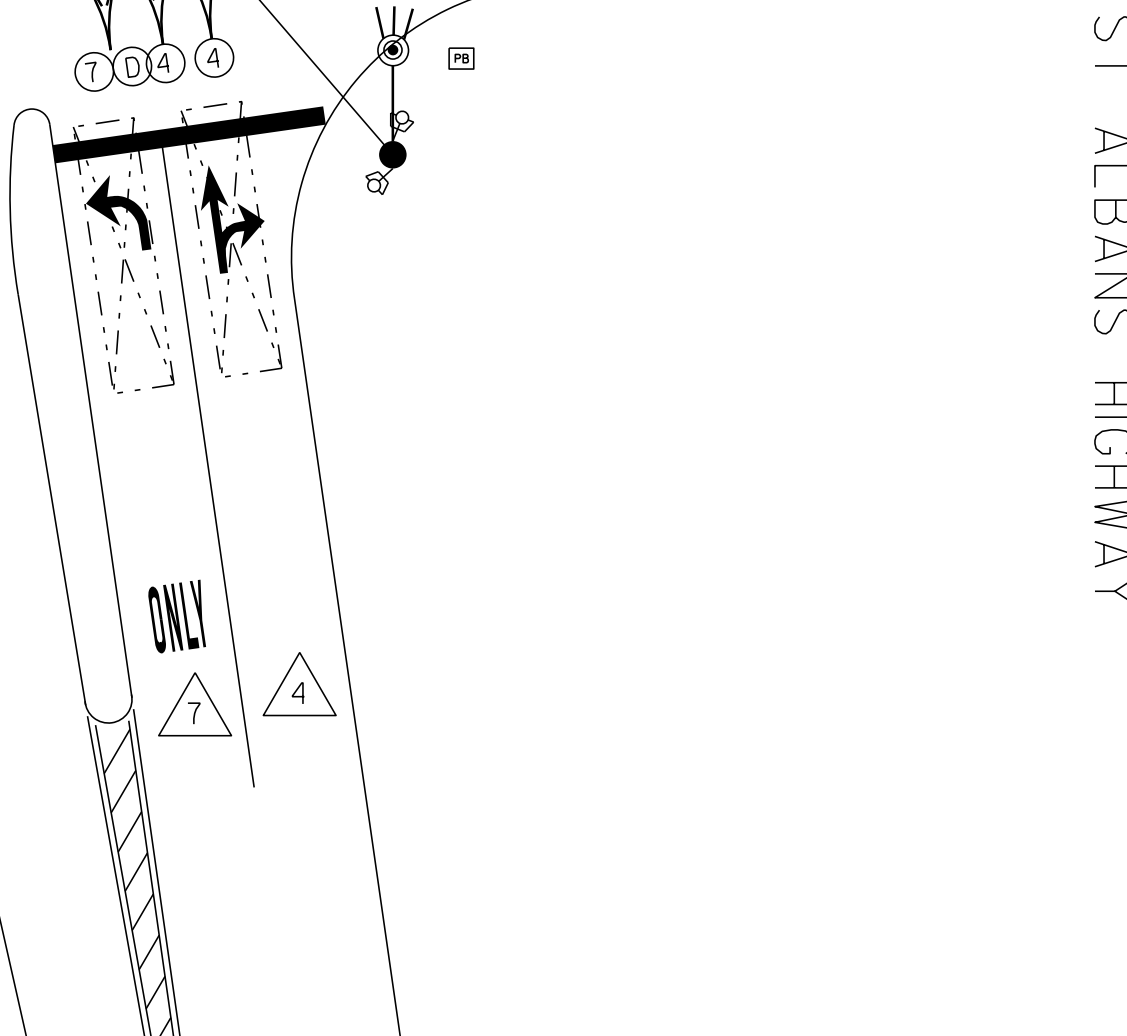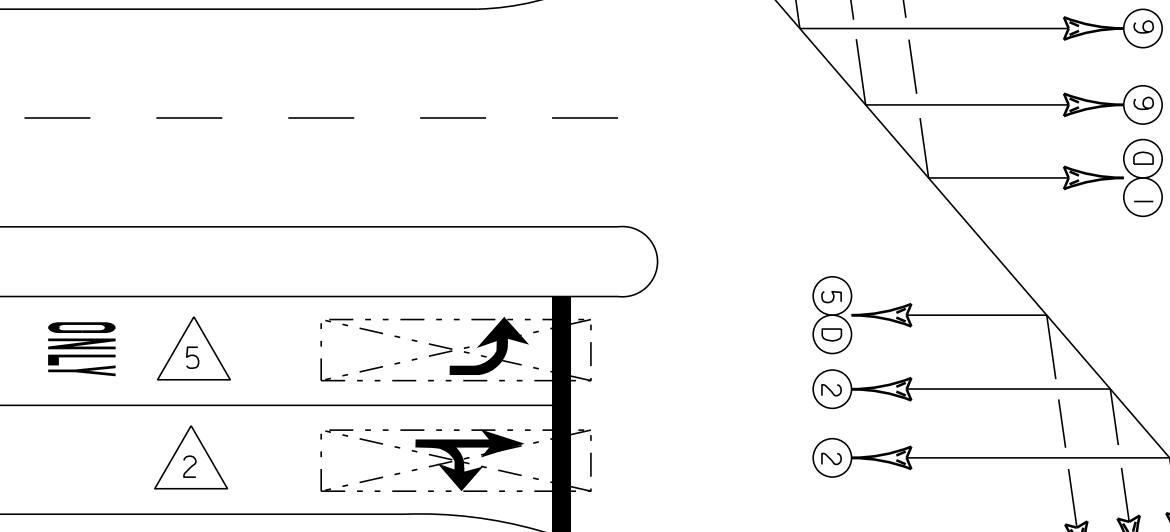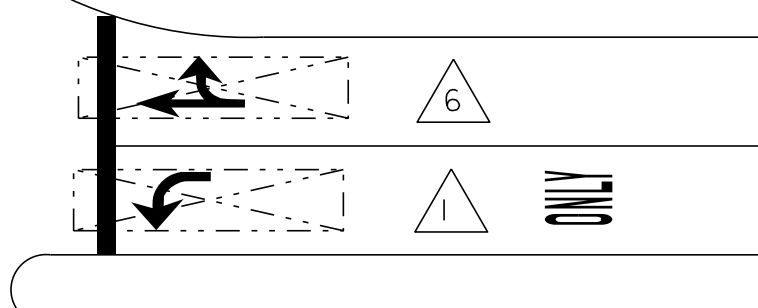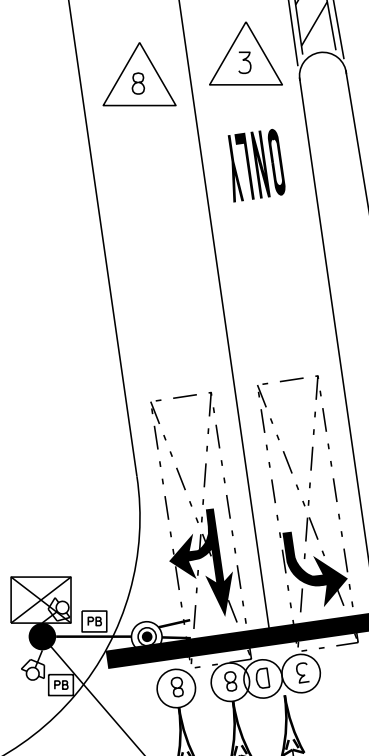

VT-104 SOUTH

ST ALBANS HIGHWAY