1950 - 1955

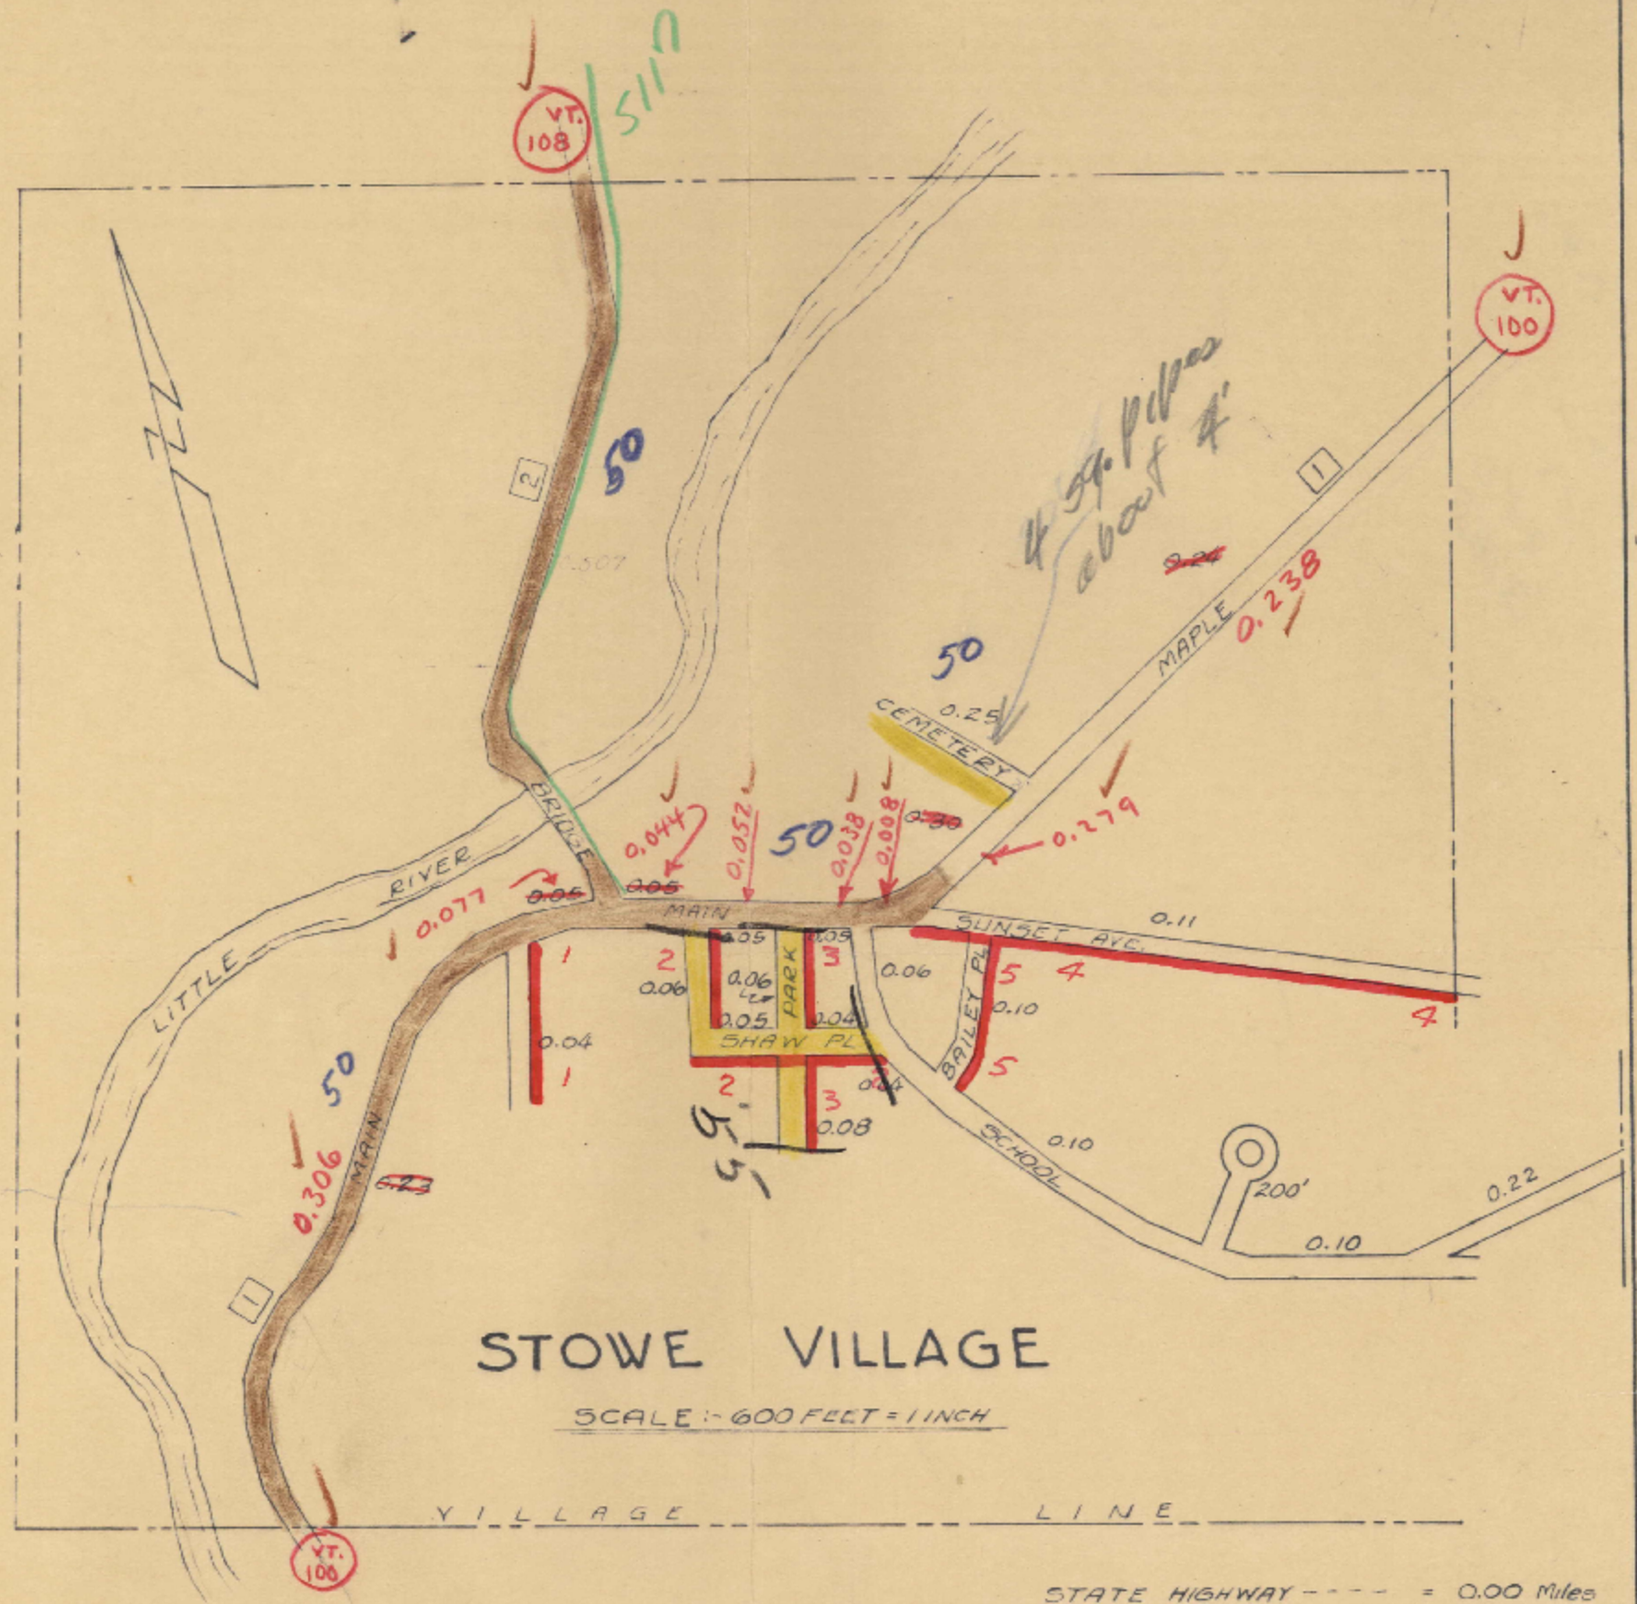

STOWE VILLAGE

SCALE :- 600 FEET = 1 INCH

(SA-1 = 1.042)

STATE HIGHWAY - - - - = 0.00 Miles
STATE AID STREETS = ~~1.477~~ "
STREETS - - - - - - = ~~1.13~~ "
TOTAL = ~~2.607~~ "

1950 → 1.572
1.445
3.017

—FAS

MEAS BY H.W. MARSETTE (O.H.C.) Rev. 4/1/44
DISTRICT Nº 9

Rev. 6/49 [illegible]

DRAWN BY C.H. BROOKS
TRACED BY J.J. PINE