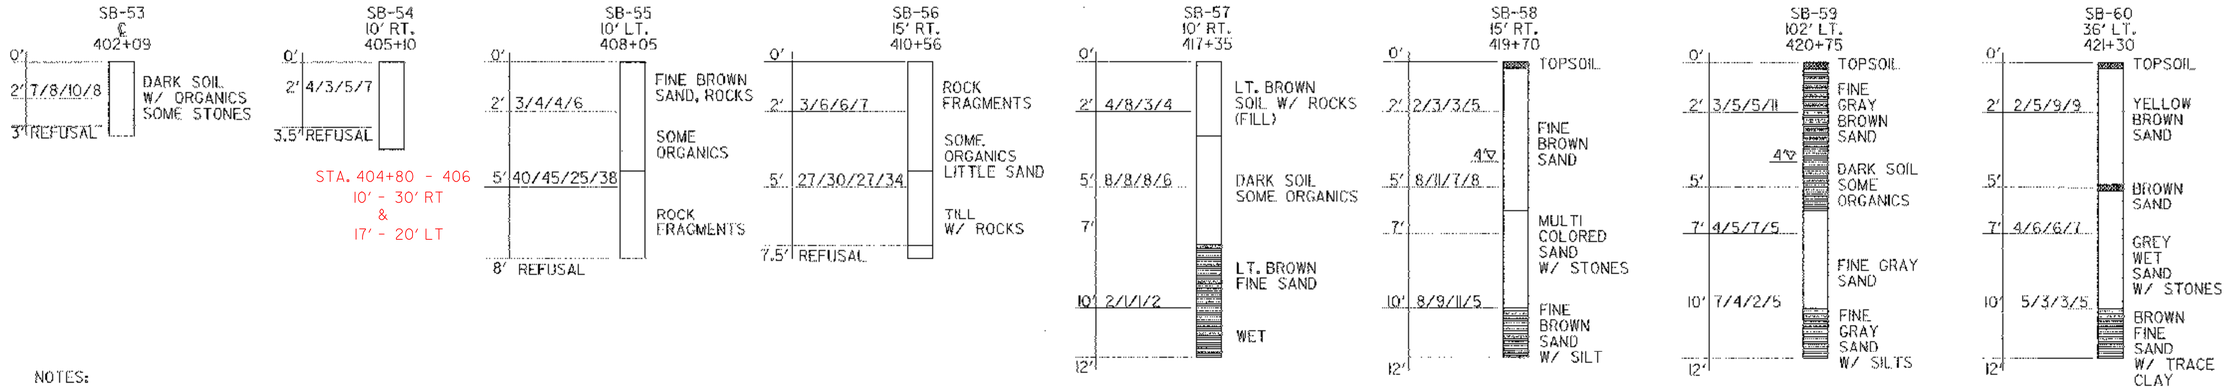

NOTES:

1. BORINGS SB-53, 54, 55, 56, 57, 58, 59 & 60 WERE TAKEN 23, APRIL 2001 BY GREEN MOUNTAIN BORINGS. TEST PITS #1, #2, #3, & #4 WERE SAMPLED 23, APRIL 2001, BY ATC.

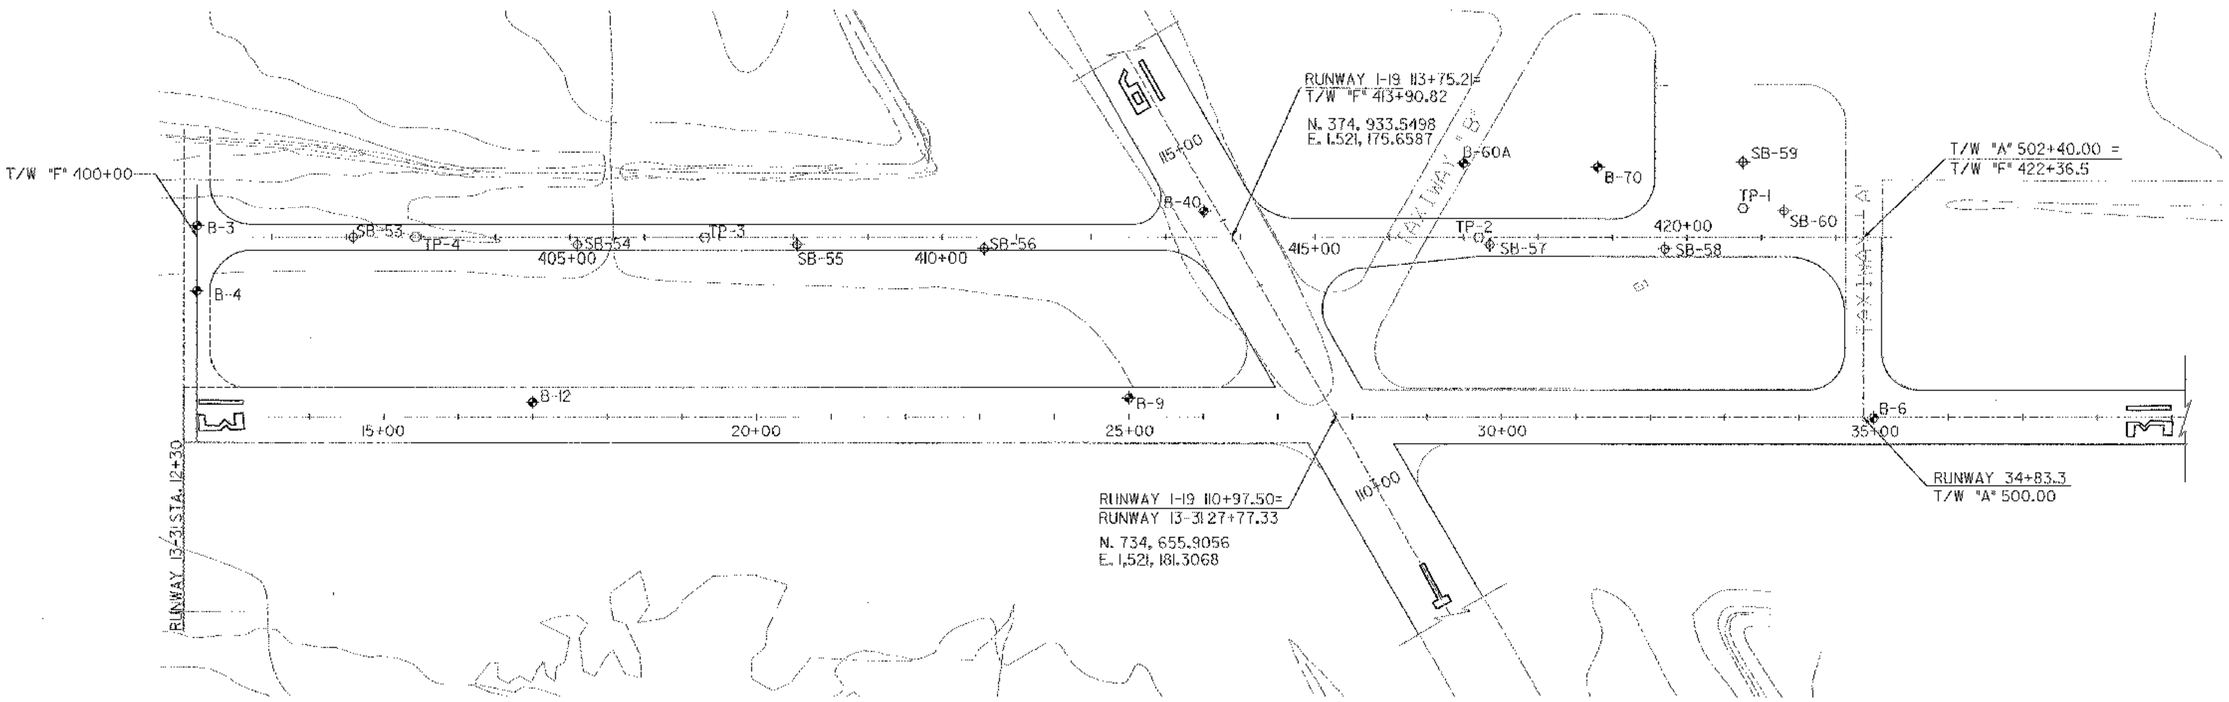

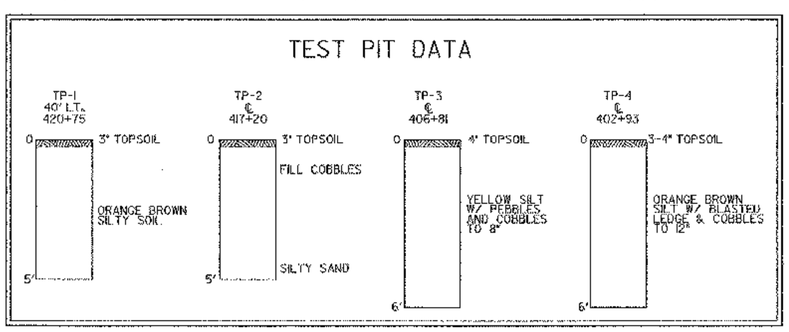

LEGEND:

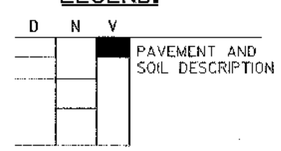

N - BLOWS PER 6-INCH INCREMENTS OF PENETRATION OF SAMPLING SPOON OR PENETRATION IN INCHES FOR THE INDICATED BLOWS OF A 140 lb. HAMMER FALLING 30".

V - SYMBOLS INDICATE EXTENT OF SOIL LAYERS

D - DEPTHS

SCALE 1" = 100'

100 0 100

A.I.P. 3-50-0015-17

REV.	DATE	DESCRIPTION

Job No. F200204002046.00

File No. F200204600DE23

RUTLAND STATE AIRPORT
CLARENDON, VERMONT

TAXIWAY IMPROVEMENTS
BORING LOGS

URS
1 NORTHWAY LN.
LATHAM, NEW YORK

Designed by: G.W.D.
Drawn by: M.C.M.
Checked by: G.W.D.
Approved by: F.J.A.

Scale: 1"=100'

Date: FEB., 2003

Sheet 29 OF 40

Sheet No 29