STA 416+00 -COMMON EXCAVATION = 227.69 SQ.FT.

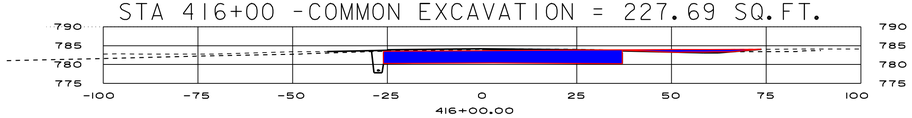


STA 415+50 -COMMON EXCAVATION = 223.82 SQ.FT.

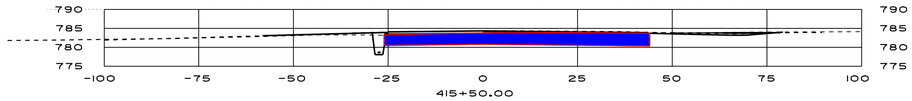


STA 415+00 -COMMON EXCAVATION = 436.99 SQ.FT.

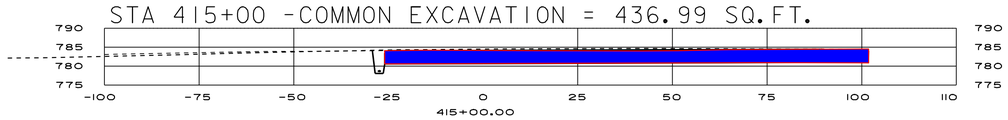


STA 414+49 -COMMON EXCAVATION = 276.81 SQ.FT.

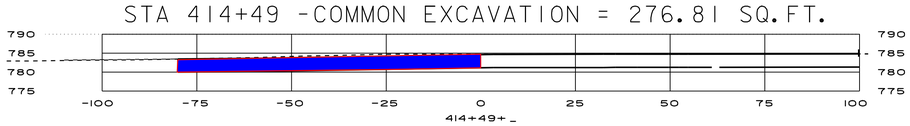


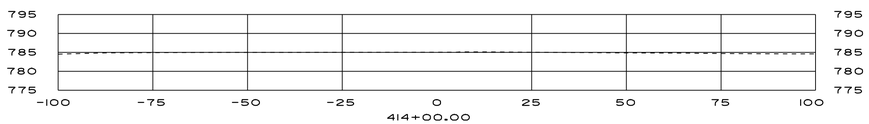


STA 418+50 -COMMON EXCAVATION = 141.62 SQ.FT.

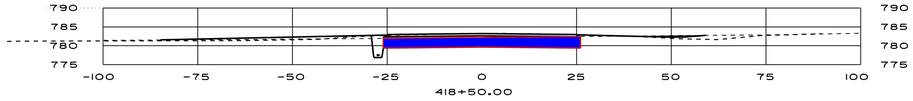


STA 418+00 -COMMON EXCAVATION = 152.67 SQ.FT.

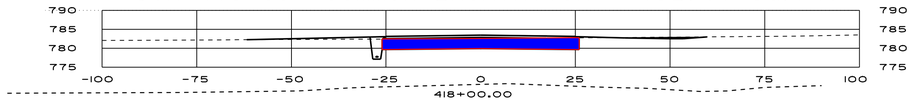


STA 417+50 -COMMON EXCAVATION = 164.23 SQ.FT.

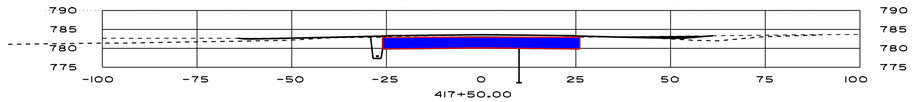


STA 417+00 -COMMON EXCAVATION = 198.83 SQ.FT.

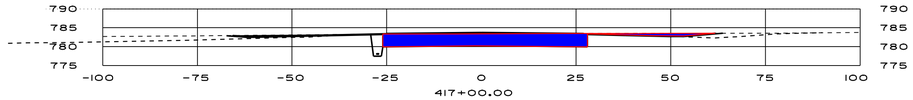


STA 416+50 -COMMON EXCAVATION = 215.18 SQ.FT.

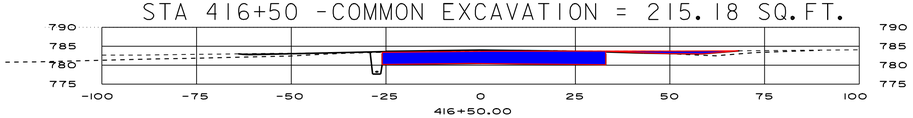


| | |
|---|---|
| PROJECT: CLARENDON | PROJECT NO. : AIR 04-3154 C/I |
| DESIGN FILE NAME: IPARM FILE NAME: S 04 | PLOT DATE:27-JUL-2005 |
| CCOMMON EXCAVATION | |