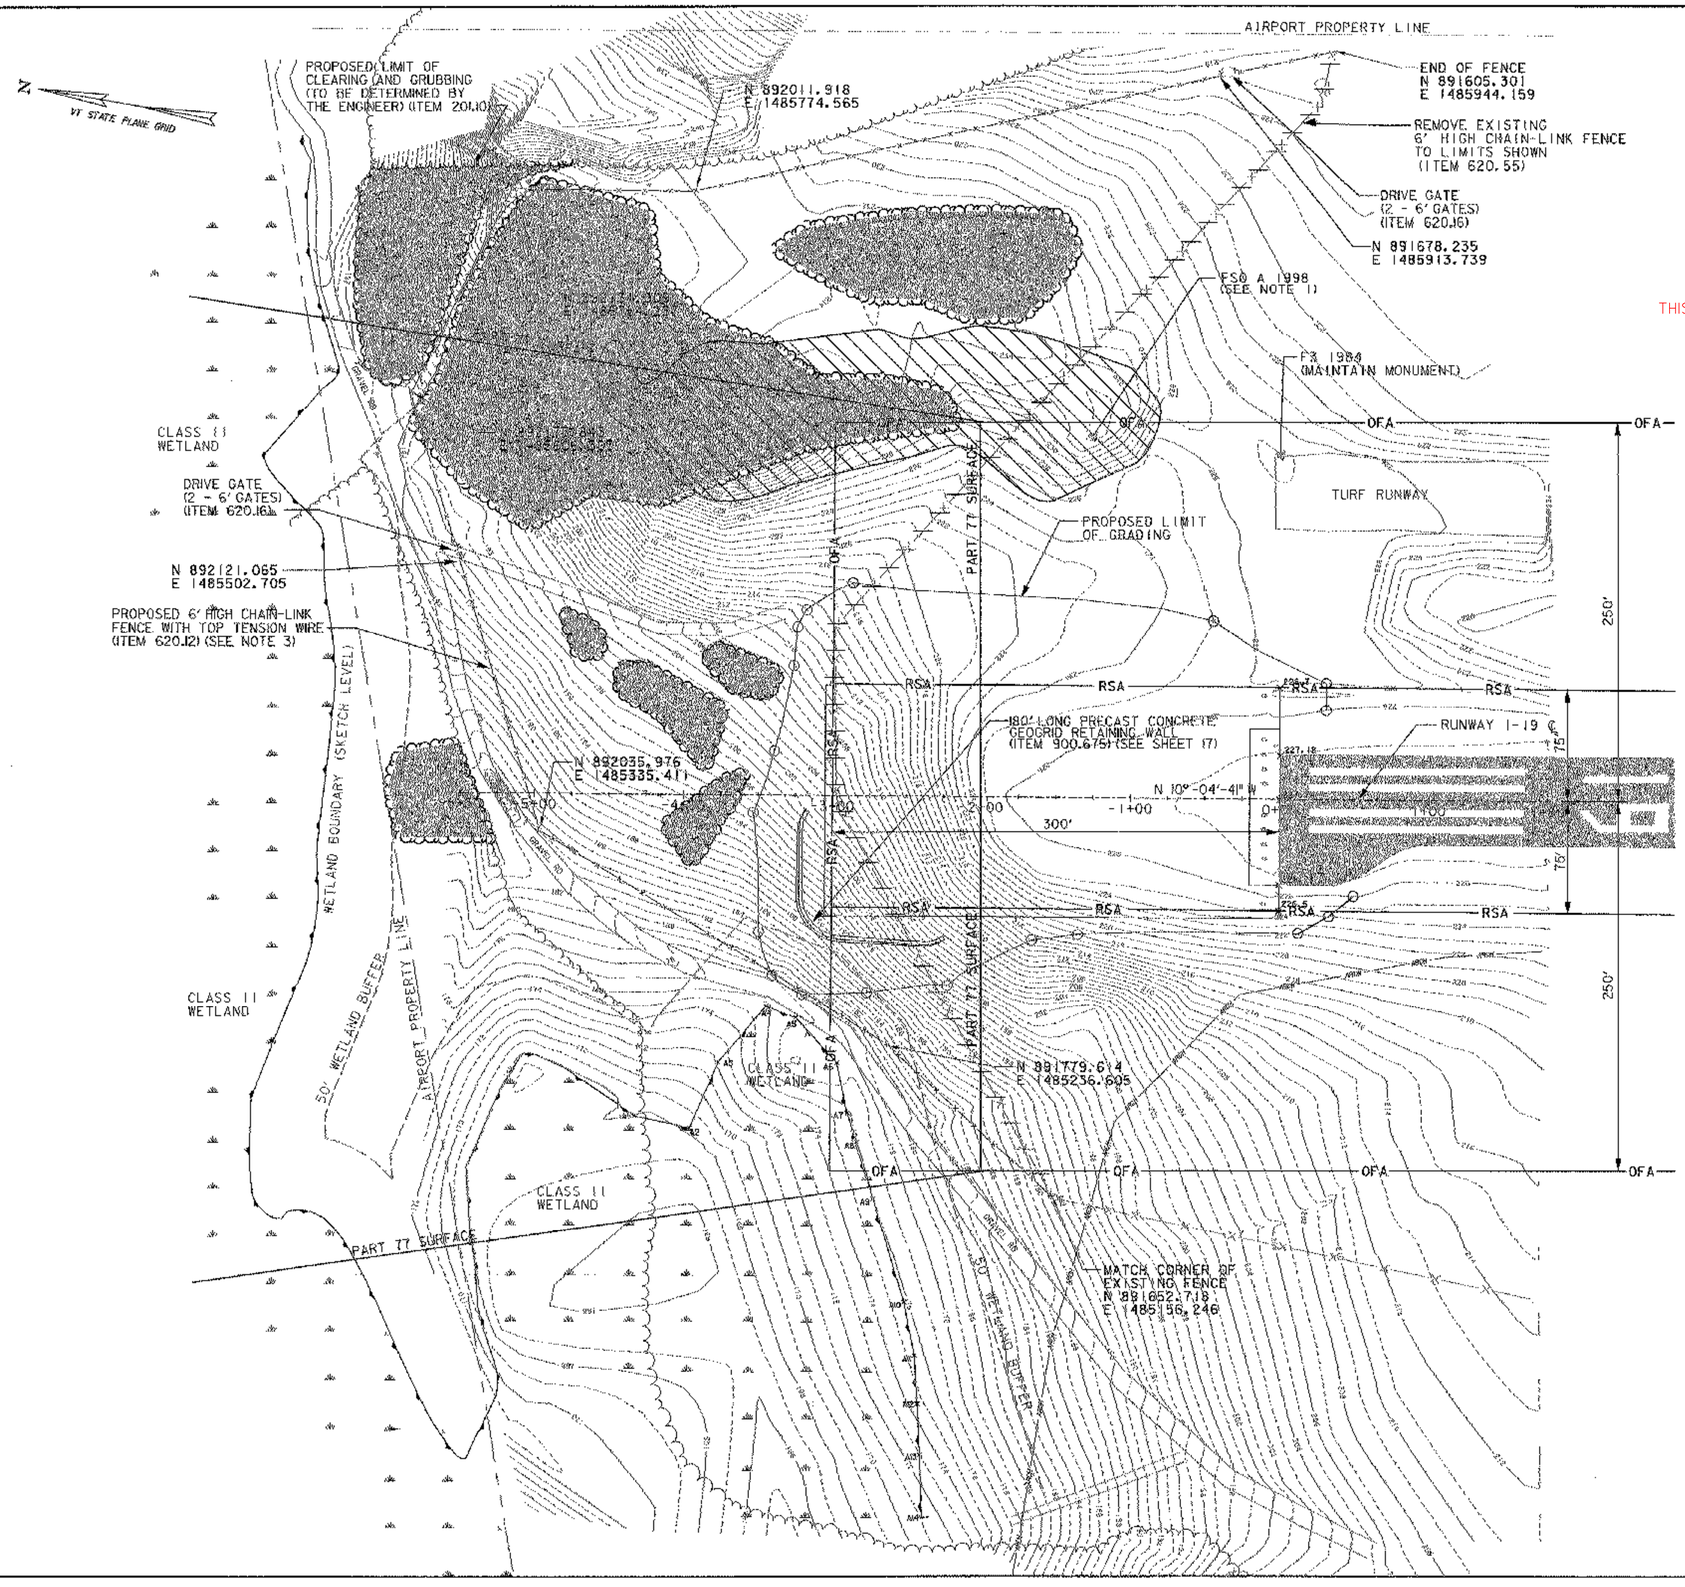

THESE NOTES NO LONGER APPLY

NOTES:

1. THE CONTRACTOR SHALL REMOVE THE CONTROL POINT METAL DISK PRIOR TO ANY ROCK REMOVAL OPERATIONS IN THIS AREA. IT IS THE RESPONSIBILITY OF THE CONTRACTOR TO DELIVER THE DISK TO DAN MARTIN OF THE VTRANS GEODETIC SURVEY SECTION IN MONTPELIER VERMONT. TELEPHONE NUMBER: 802-828-2952.
2. FOR LOCATION OF BARRIER FENCE SEE SHEET NO. 10.
3. FOR FENCE INSTALLATION DETAILS REFER TO VTRANS DESIGN STANDARD SHEET F-2.
4. FOR ROCK REMOVAL DETAILS SEE SHEET 3 AND THE CROSS SECTION SHEETS.

THIS PAGE NOT USED FOR WALL DESIGN

ROCK EXCAVATION LIMITS

STATION (LEFT)	WESTERN POINT		EASTERN POINT	
	OFFSET (FT.)	ELEVATION	OFFSET (FT.)	ELEVATION
-4+59.7			279.6	235.09
-4+50	251.6	233.09	294.0	233.95
-4+25	236.2	232.36	275.0	232.36
-4+00	206.7	231.62	291.3	233.16
-3+75	196.1	230.89	304.1	234.79
-3+50	199.6	230.15	302.2	234.33
-3+25	208.2	229.42	305.0	234.52
-3+00	214.8	228.68	307.0	234.61
-2+75	222.4	227.95	311.6	235.06
-2+50	226.6	227.21	305.5	234.00
-2+25	234.0	226.48	308.5	234.25
-2+00	219.8	225.74	314.2	234.91
-1+75	207.8	225.74	308.1	234.05
-1+50	195.5	225.74	303.3	233.36
-1+25	211.3	225.74	292.4	231.80
-1+00	222.4	225.74	286.9	231.02
-0+81.6			257.9	227.74

LEGEND

- GROUND PENETRATION AREA (ITEM 203.16 - SOLID ROCK EXCAVATION)
- TREE PENETRATION AREAS (ITEM 201.10 - CLEARING AND GRUBBING, INCLUDING INDIVIDUAL TREES & STUMPS)
- RSA — RUNWAY SAFETY AREA
- OFA — OBJECT FREE AREA
- ARCH — ARCHAEOLOGICALLY SENSITIVE AREA LIMIT

0 50 100
SCALE IN FEET

Stantec

PROJECT NAME: HIGHGATE
PROJECT NUMBER: AIR 04-3183

FILE NAME: OBSTRUCTION REMOVAL PLAN.DGN PLOT DATE: 12/27/2007
PROJECT LEADER: M. CHURCHILL DRAWN BY: J. OAKMAN
DESIGNED BY: P. ENZIEN CHECKED BY: P. ENZIEN
OBSTRUCTION REMOVAL PLAN SHEET 15 OF 27