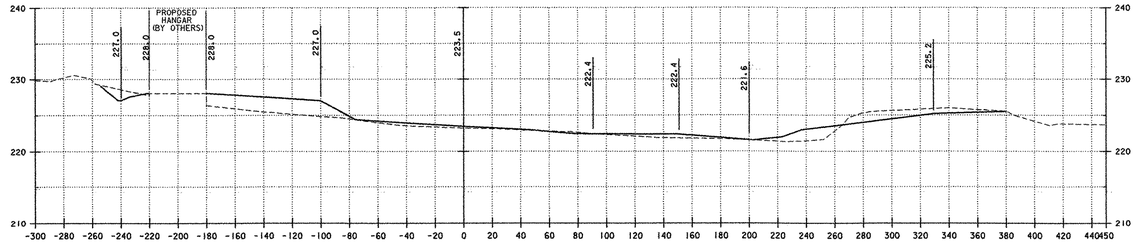

17+50

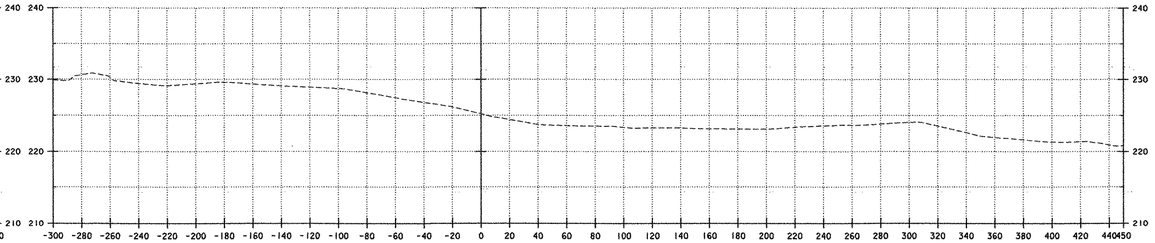

20+00

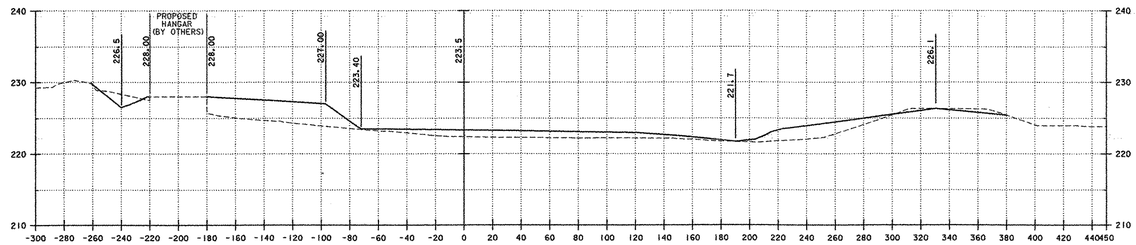

17+00

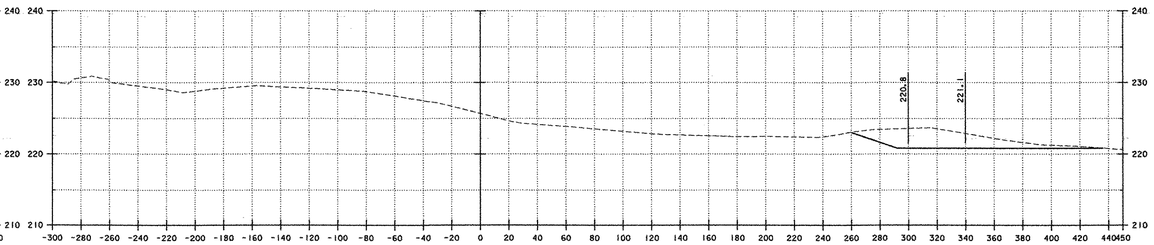

19+50

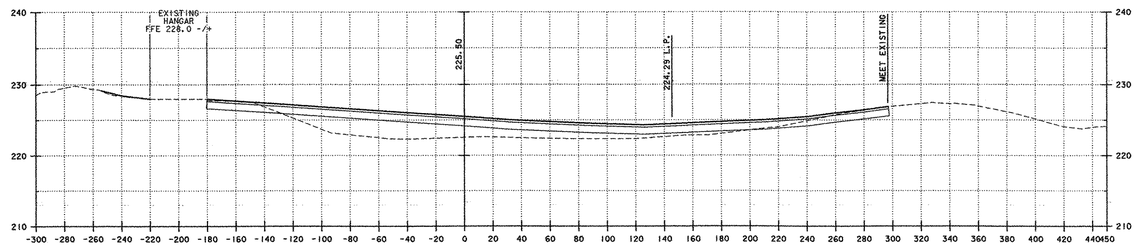

16+50

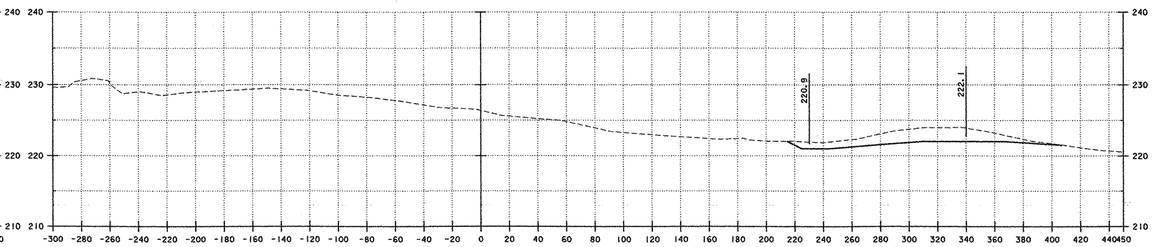

19+00

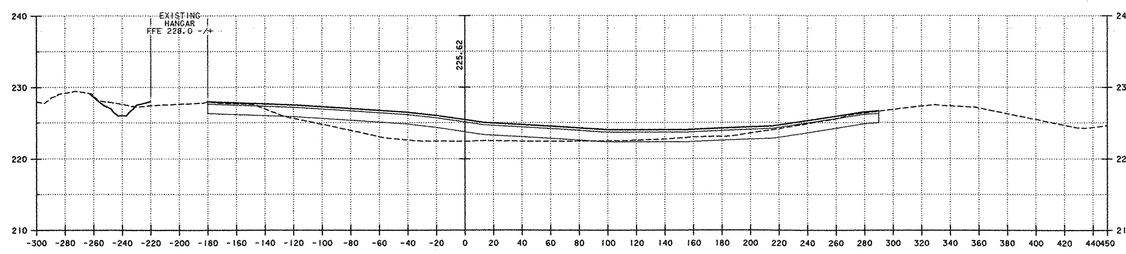

16+15

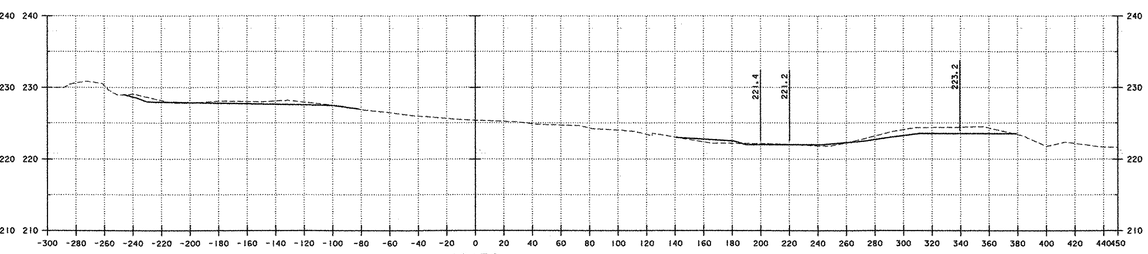

18+50

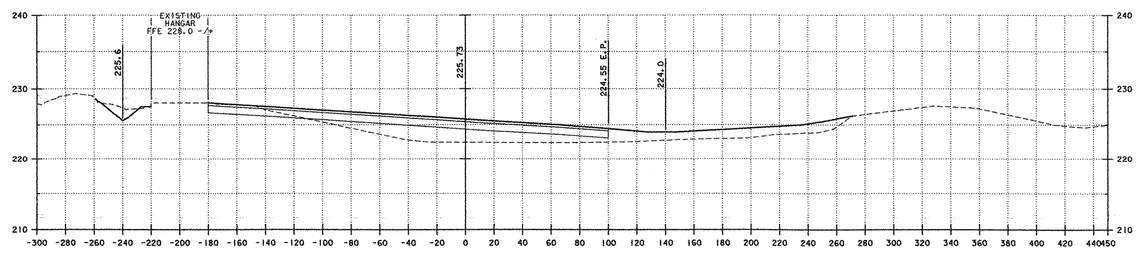

16+00

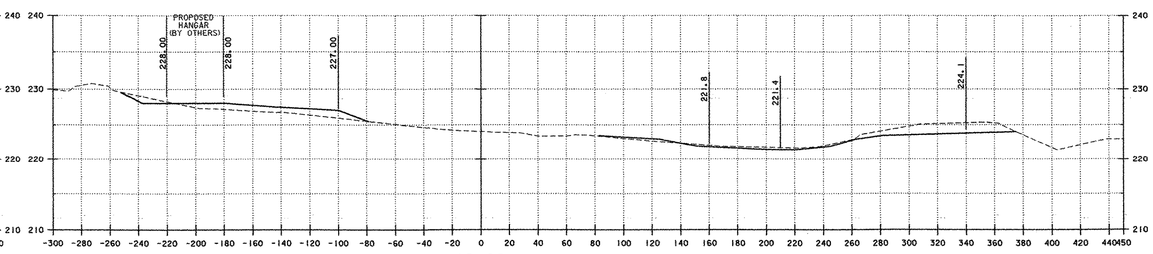

18+00

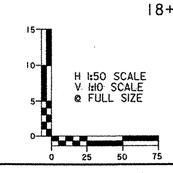

Dufresne-Henry

PROJECT NAME: FRANKLIN COUNTY AIRPORT

PROJECT NUMBER: AIR 04-3170

FILE NAME: ...\z000cross section.dgn

PROJECT LEADER: MLC

DESIGNED BY: MLC

CROSS SECTIONS

PLOT DATE: 04/06/2004

DRAWN BY: JDO

CHECKED BY: DPD

SHEET 17 OF 17

...\DESIGN\z00cross section.dgn 04/06/2004 01:46:06 PM