CLARENDON AIR 04-3172 C/2
BY P. REED

CLARENDON AIR 04-3172 C/2
BY: P.REED - HTA

ITEM 205.20
DRILLING AND BLASTING OF SOLID ROCK SUBGRADE

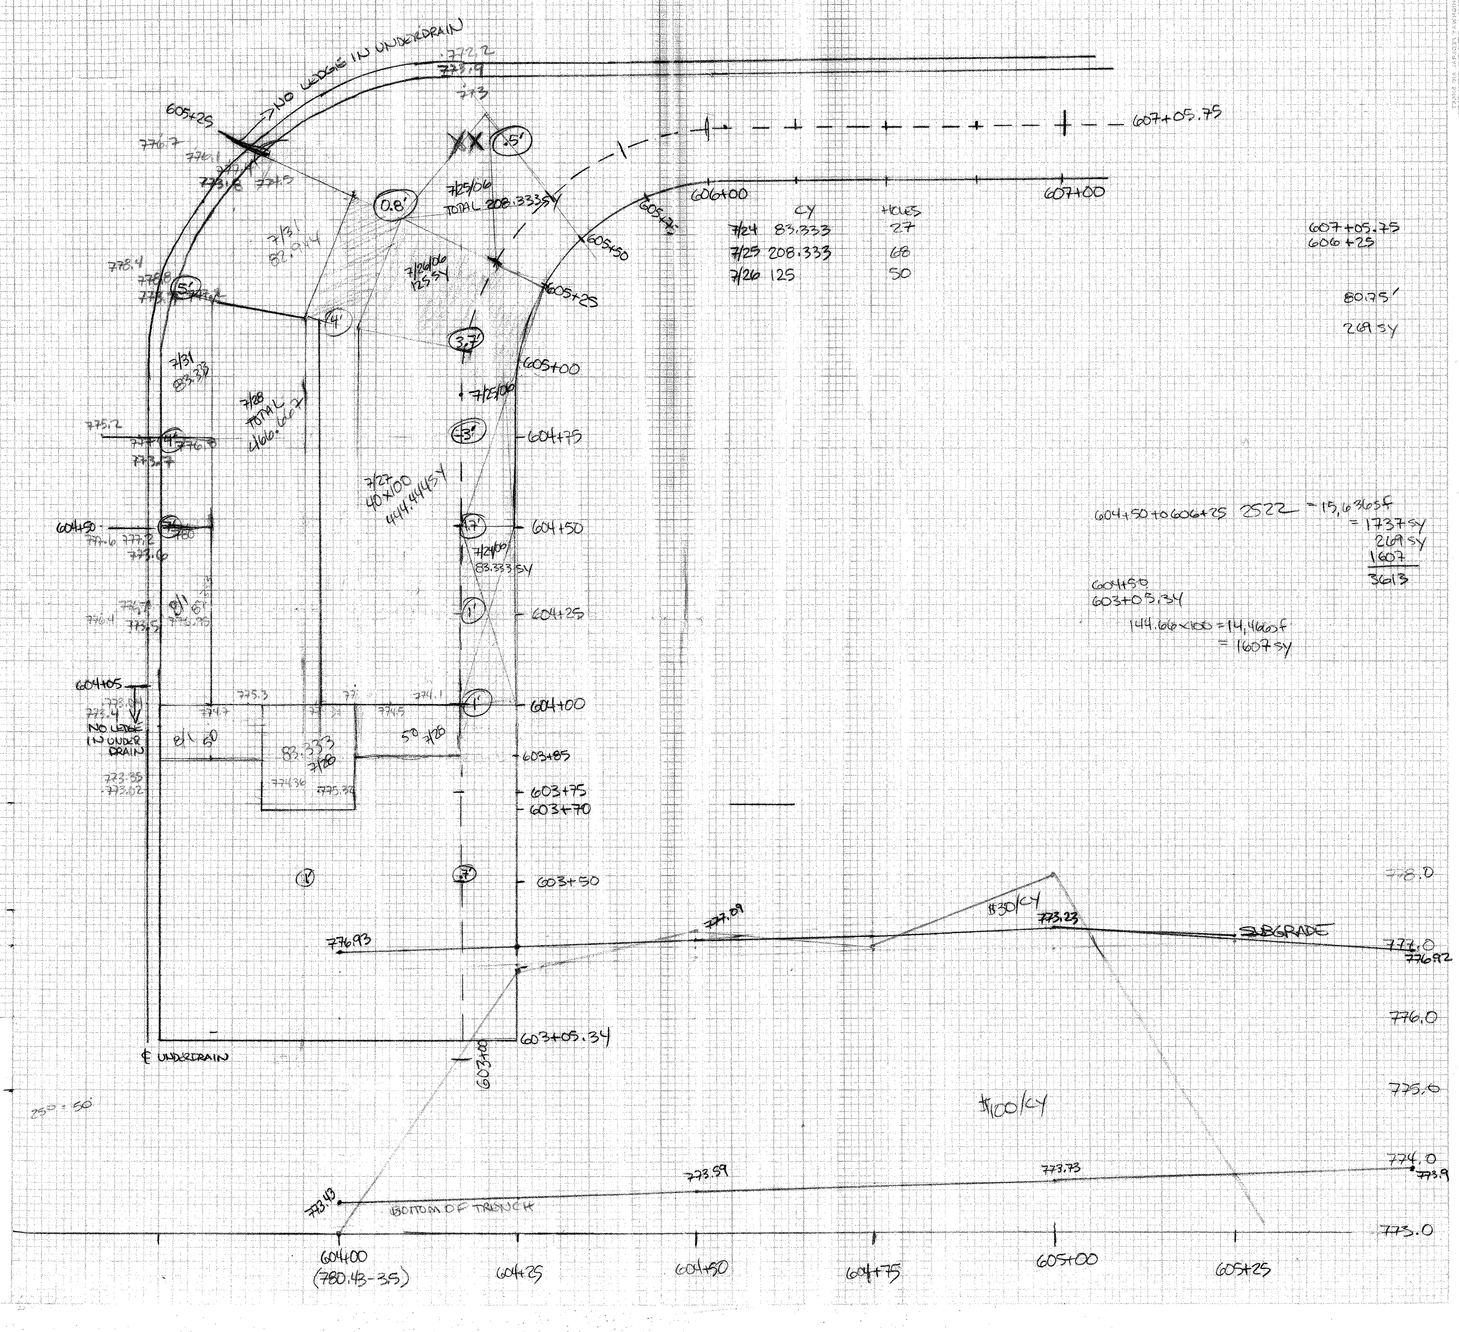

	CY	HOLES
7/24	83.333	27
7/25	208.333	68
7/26	125	50

607+05.75
606+25
80.75'
269 SY

604+50 to 606+25 2522 - 15,163 cf
= 1737 SY
269 SY
1607
3613

604+50
603+05.34
144.66x100 = 14,466 cf
= 1607 SY