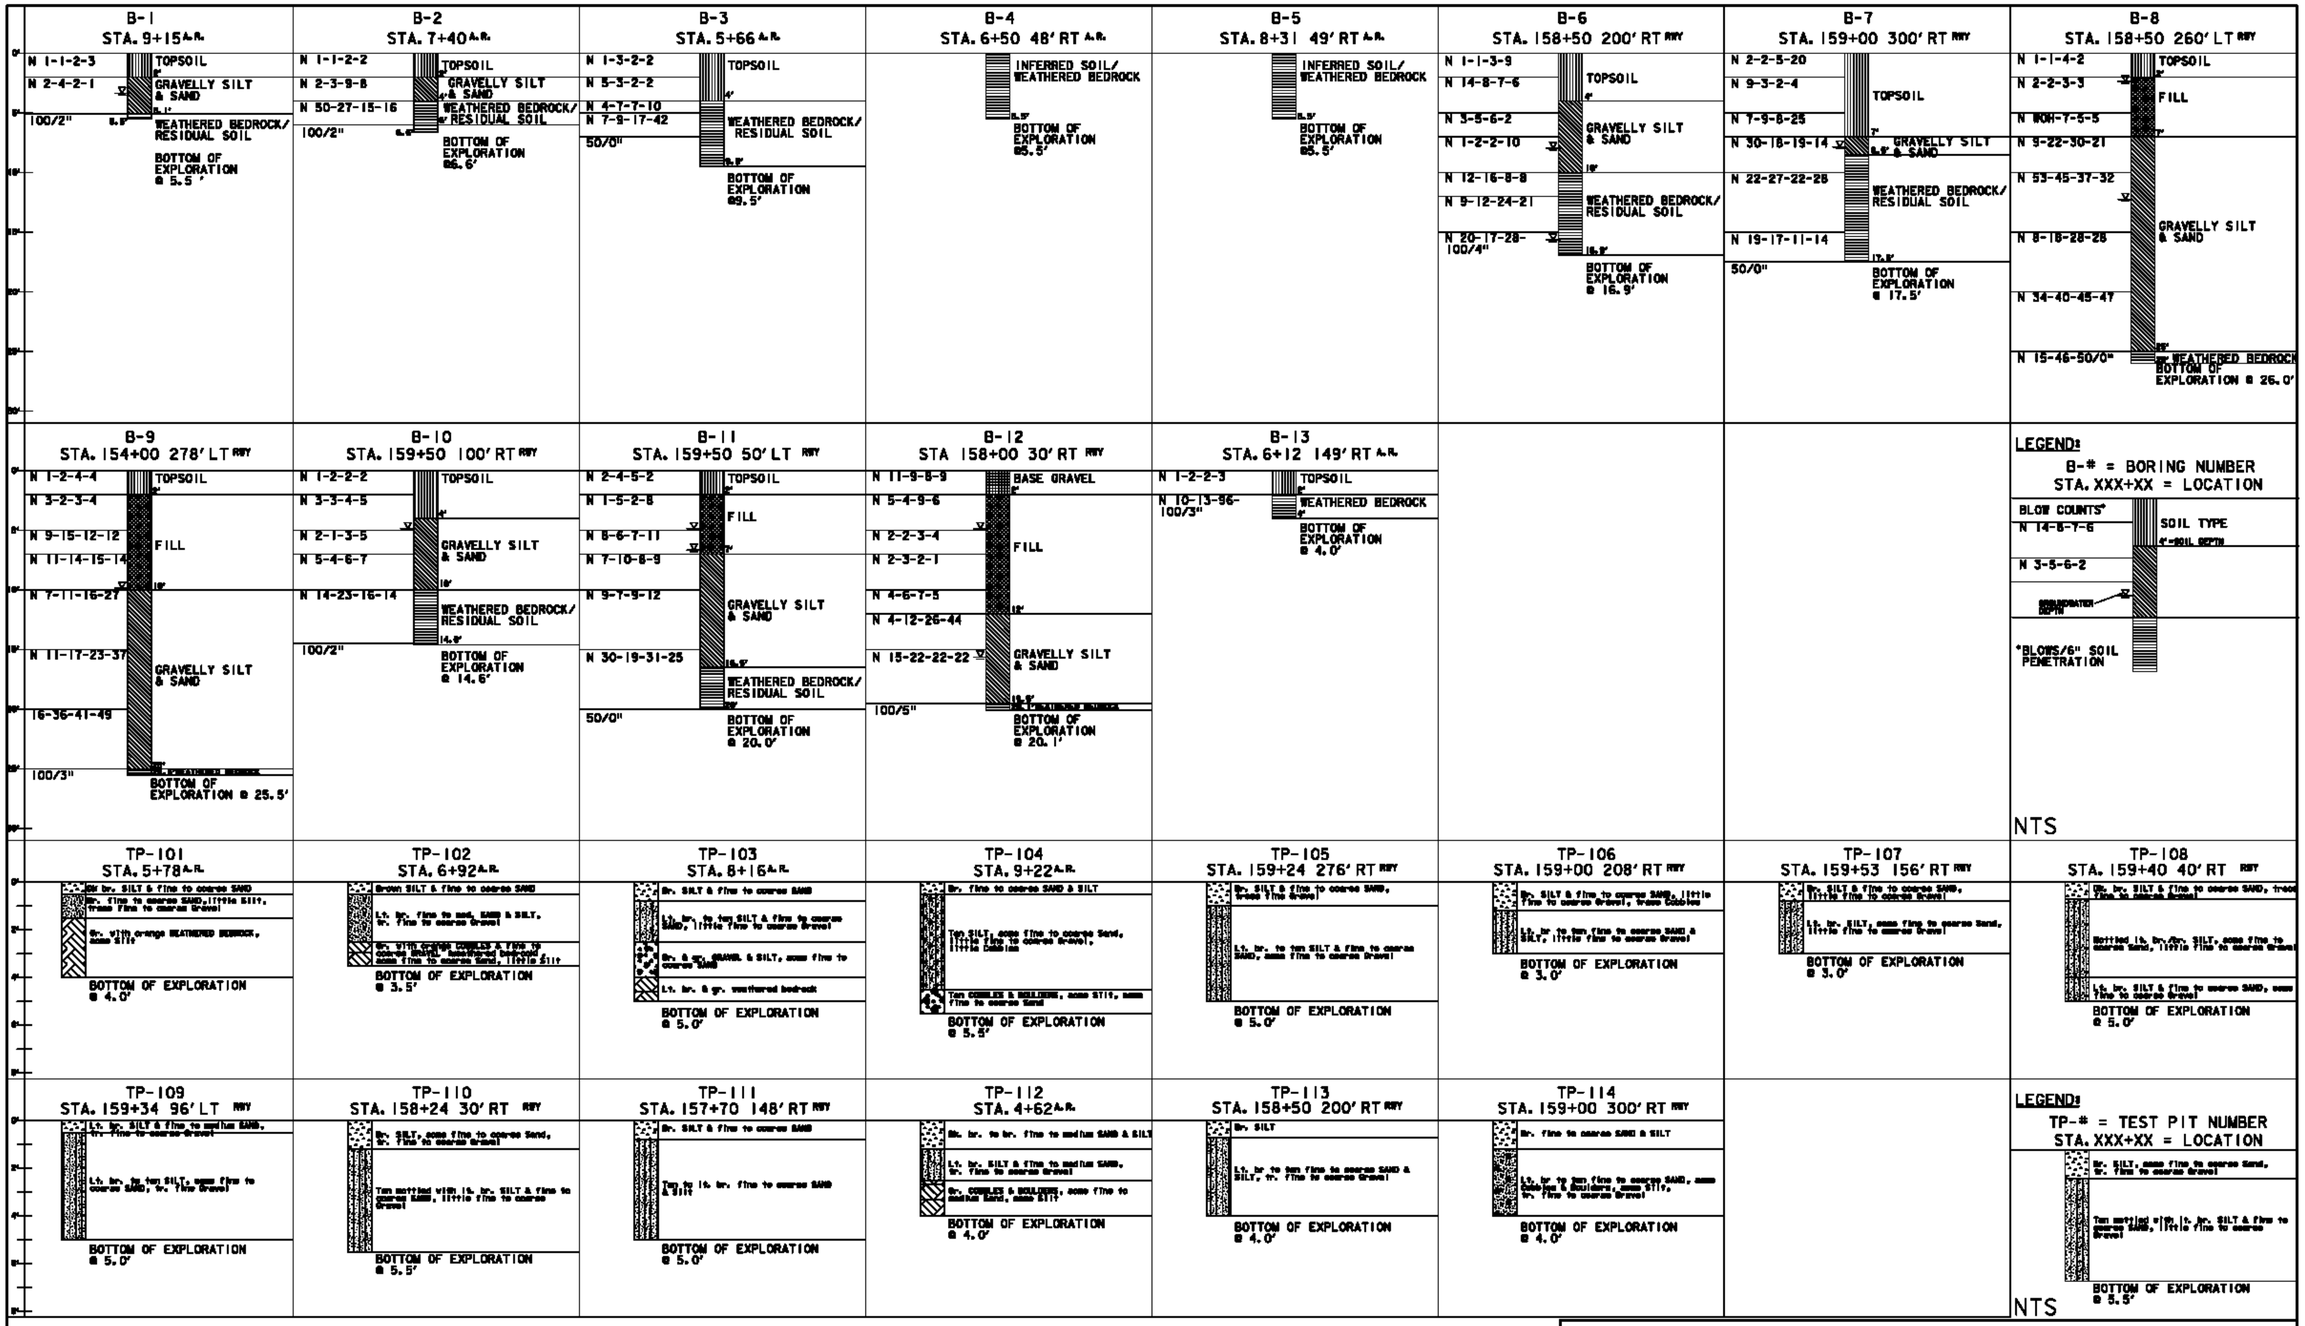

NOTES:
1. BORING LOCATIONS SHOWN ON SHEET XX.
2. BORINGS TAKEN JULY 2009 BY GEODESIGN, INC, WINDSOR, VT (SEE PRELIMINARY GEOTECHNICAL ENGINEERING REPORT FROM GEODESIGN DATED OCTOBER 20, 2009)
3. TEST PITS TAKEN SEPTEMBER 2012 BY GEODESIGN, INC, WINDSOR, VT
4. STATIONING FOR B-1 TO B-5 & B-13 CORRESPONDS TO AIRPORT ROAD AS INDICATED BY A.R.; STATIONING FOR B6 TO B-12 CORRESPONDS TO RUNWAY 1-19 AS INDICATED BY RWY.

RECORD DRAWING
DECEMBER 27, 2013

AIP 3-50-0015-34

VERMONT AGENCY OF TRANSPORTATION

URS
URS CORPORATION
3 CORPORATE DRIVE, SUITE 203
CLIFTON PARK, NY 12065
(518) 688-0015

PROJECT NAME: RUTLAND SOUTHERN VERMONT REGIONAL AIRPORT
CLARENDON, VERMONT
PROJECT NUMBER: AV14-8008-300

FILE NAME: z07h124b1-RD.dgn
PROJECT LEADER: F. WALSH
DESIGNED BY: G. D'AMICO
BORING AND TEST PIT LOGS

PLOT DATE: 12/30/2013
DRAWN BY: M. WASSON
CHECKED BY:
SHEET 21 OF 29

12/30/2013
J:\38397229 RUT RSA 19 Improvements Final Design & CIPhase 1\6.0 CADD\6.1 Plan Sheets\RECORD DRAWINGS\z07h124b1-RD.dgn