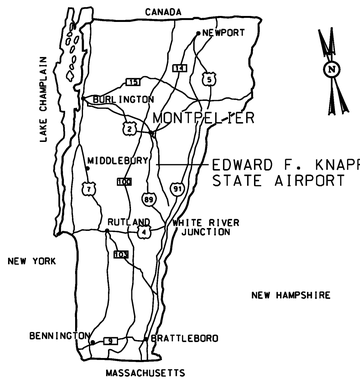

LOCATION MAP

STATE OF VERMONT
AGENCY OF TRANSPORTATION

PROPOSED IMPROVEMENT
A.I.P. 3-50-0001-011-2009
TOWN OF BERLIN
COUNTY OF WASHINGTON
E.F. KNAPP STATE AIRPORT

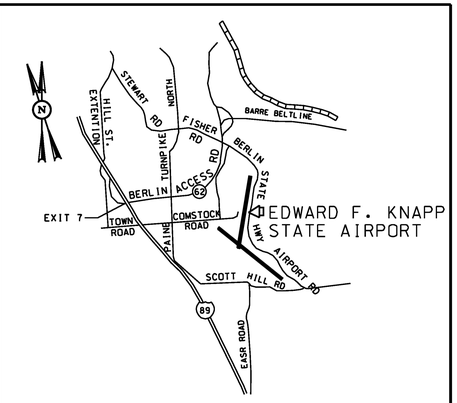

VICINITY MAP

INDEX OF SHEETS
SEE SHEET 2

PROJECT LOCATION:	THIS PROJECT IS LOCATED EAST OF INTERSTATE 89 EXIT 7 AT THE EDWARD F. KNAPP STATE AIRPORT IN BERLIN, VT.
PROJECT DESCRIPTION:	WORK PERFORMED UNDER THIS PROJECT INCLUDES THE EXTENSION OF TAXIWAY 'A', THE RECONSTRUCTION OF RUNWAY 5-23 AND TERMINAL AREA RECONSTRUCTION AND EXPANSION. THIS INCLUDES DRAINAGE, PAVEMENT, MARKINGS, SIGNAGE, LIGHTING, LANDSCAPING AND OTHER AMENITIES.
LENGTH OF PROJECT:	TAXIWAY 'A' - 5,469'; TAXIWAY 'B' - 128'; TAXIWAY 'E' - 906'; TAXIWAY 'F' - 658'; TAXIWAY 'G' - 86'; AND RUNWAY '5-23' - 3,000'.

THESE PLANS ARE SUBJECT TO SUCH ENGINEERING CHANGES AS MAY BE REQUIRED BY THE DIRECTOR OF PROJECT DEVELOPMENT. CONSTRUCTION IS TO BE CARRIED OUT IN ACCORDANCE WITH THESE PLANS AND SPECIFICATIONS, THE VAOT STANDARD SPECIFICATIONS FOR CONSTRUCTION DATED 2006, THE FEDERAL AVIATION ADMINISTRATION PLANS AND SPECIFICATIONS FOR USE ON THIS PROJECT, INCLUDING ALL SUBSEQUENT REVISIONS AND SUCH REVISED SPECIFICATIONS AND SPECIAL PROVISIONS AS ARE INCORPORATED IN THESE PLANS.

VT STATE PLANE GRID

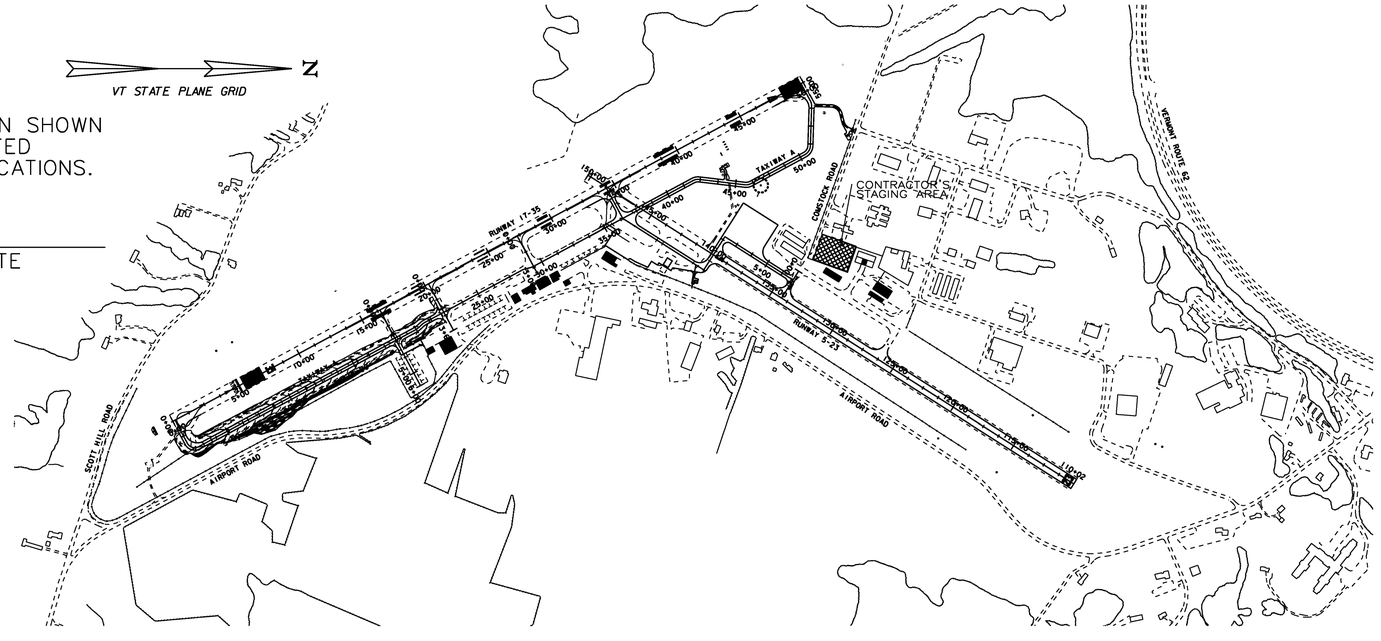

SCALE 1" = 500'-0
500 0 500

I HEREBY CERTIFY THAT ALL WORK ON SHOWN ON THESE PLANS HAS BEEN COMPLETED ACCORDING TO THE PLANS & SPECIFICATIONS.

MARK GOODRICH DATE

DEPARTMENT OF TRANSPORTATION
FEDERAL AVIATION ADMINISTRATION
NEW ENGLAND REGION

DATE:_____

DATE:_____

APPROVAL SUBJECT TO COMMENTS AND RECOMENDATIONS IN LETTERS DATED: _____

SPONSOR'S STATEMENT REGARDING COMPLIANCE

These plans and specifications have been prepared to the best of my knowledge and belief, in accordance with the list of current FAA Advisory Circulars for AIP and PFC projects as of 3/21/2007. Known deviations from FAA standards were approved by FAA letters dated NONE and are discussed in the project engineering report and/or other official project documents.

BY:_____ DATE:_____

DIRECTOR OF OPERATIONS

APPROVED _____ DATE _____

PROJECT MANAGER : SCOTT FORTNEY

CONVENTIONAL SYMBOLS

COUNTY LINE	COUNTY LINE
TOWN LINE	TOWN LINE
LIMITS OF ACCESS	
POINT OF ACCESS	X
FENCE LINE	
STONE WALL	
TRAVELED WAY	
GUARD RAIL	
RAILROAD	
SURVEY LINE	
CULVERT	
POWER POLE	
TELEPHONE POLE	
TREES	
CONTROL OF ACCESS	
PROPERTY LINE	
R.O.W. TAKING LINE	
SLOPE RIGHTS	SR SR SR
TOP OF CUT	
TOE OF SLOPE	

SURVEY PERFORMED BY VERMONT SURVEY AND ENGINEERING, INC. ON 07-11-07

DATUM
VERTICAL $ (VER_DAT)
HORIZONTAL $ (HOR_DAT)

HTA PROJECT NO.
302803

Hoyle, Tanner & Associates, Inc.
150 Dow Street
Manchester, NH 03101-1227
Tel 603-669-5555
Fax 603-669-4168
Web Page: www.hoyletanner.com

PROJECT NAME : E.F. KNAPP STATE AIRPORT
A.I.P. 3-50-0001-011-2009
PROJECT NUMBER : BERLIN AIR 04-3216
TITLE SHEET
SHEET 1 OF 173 SHEETS