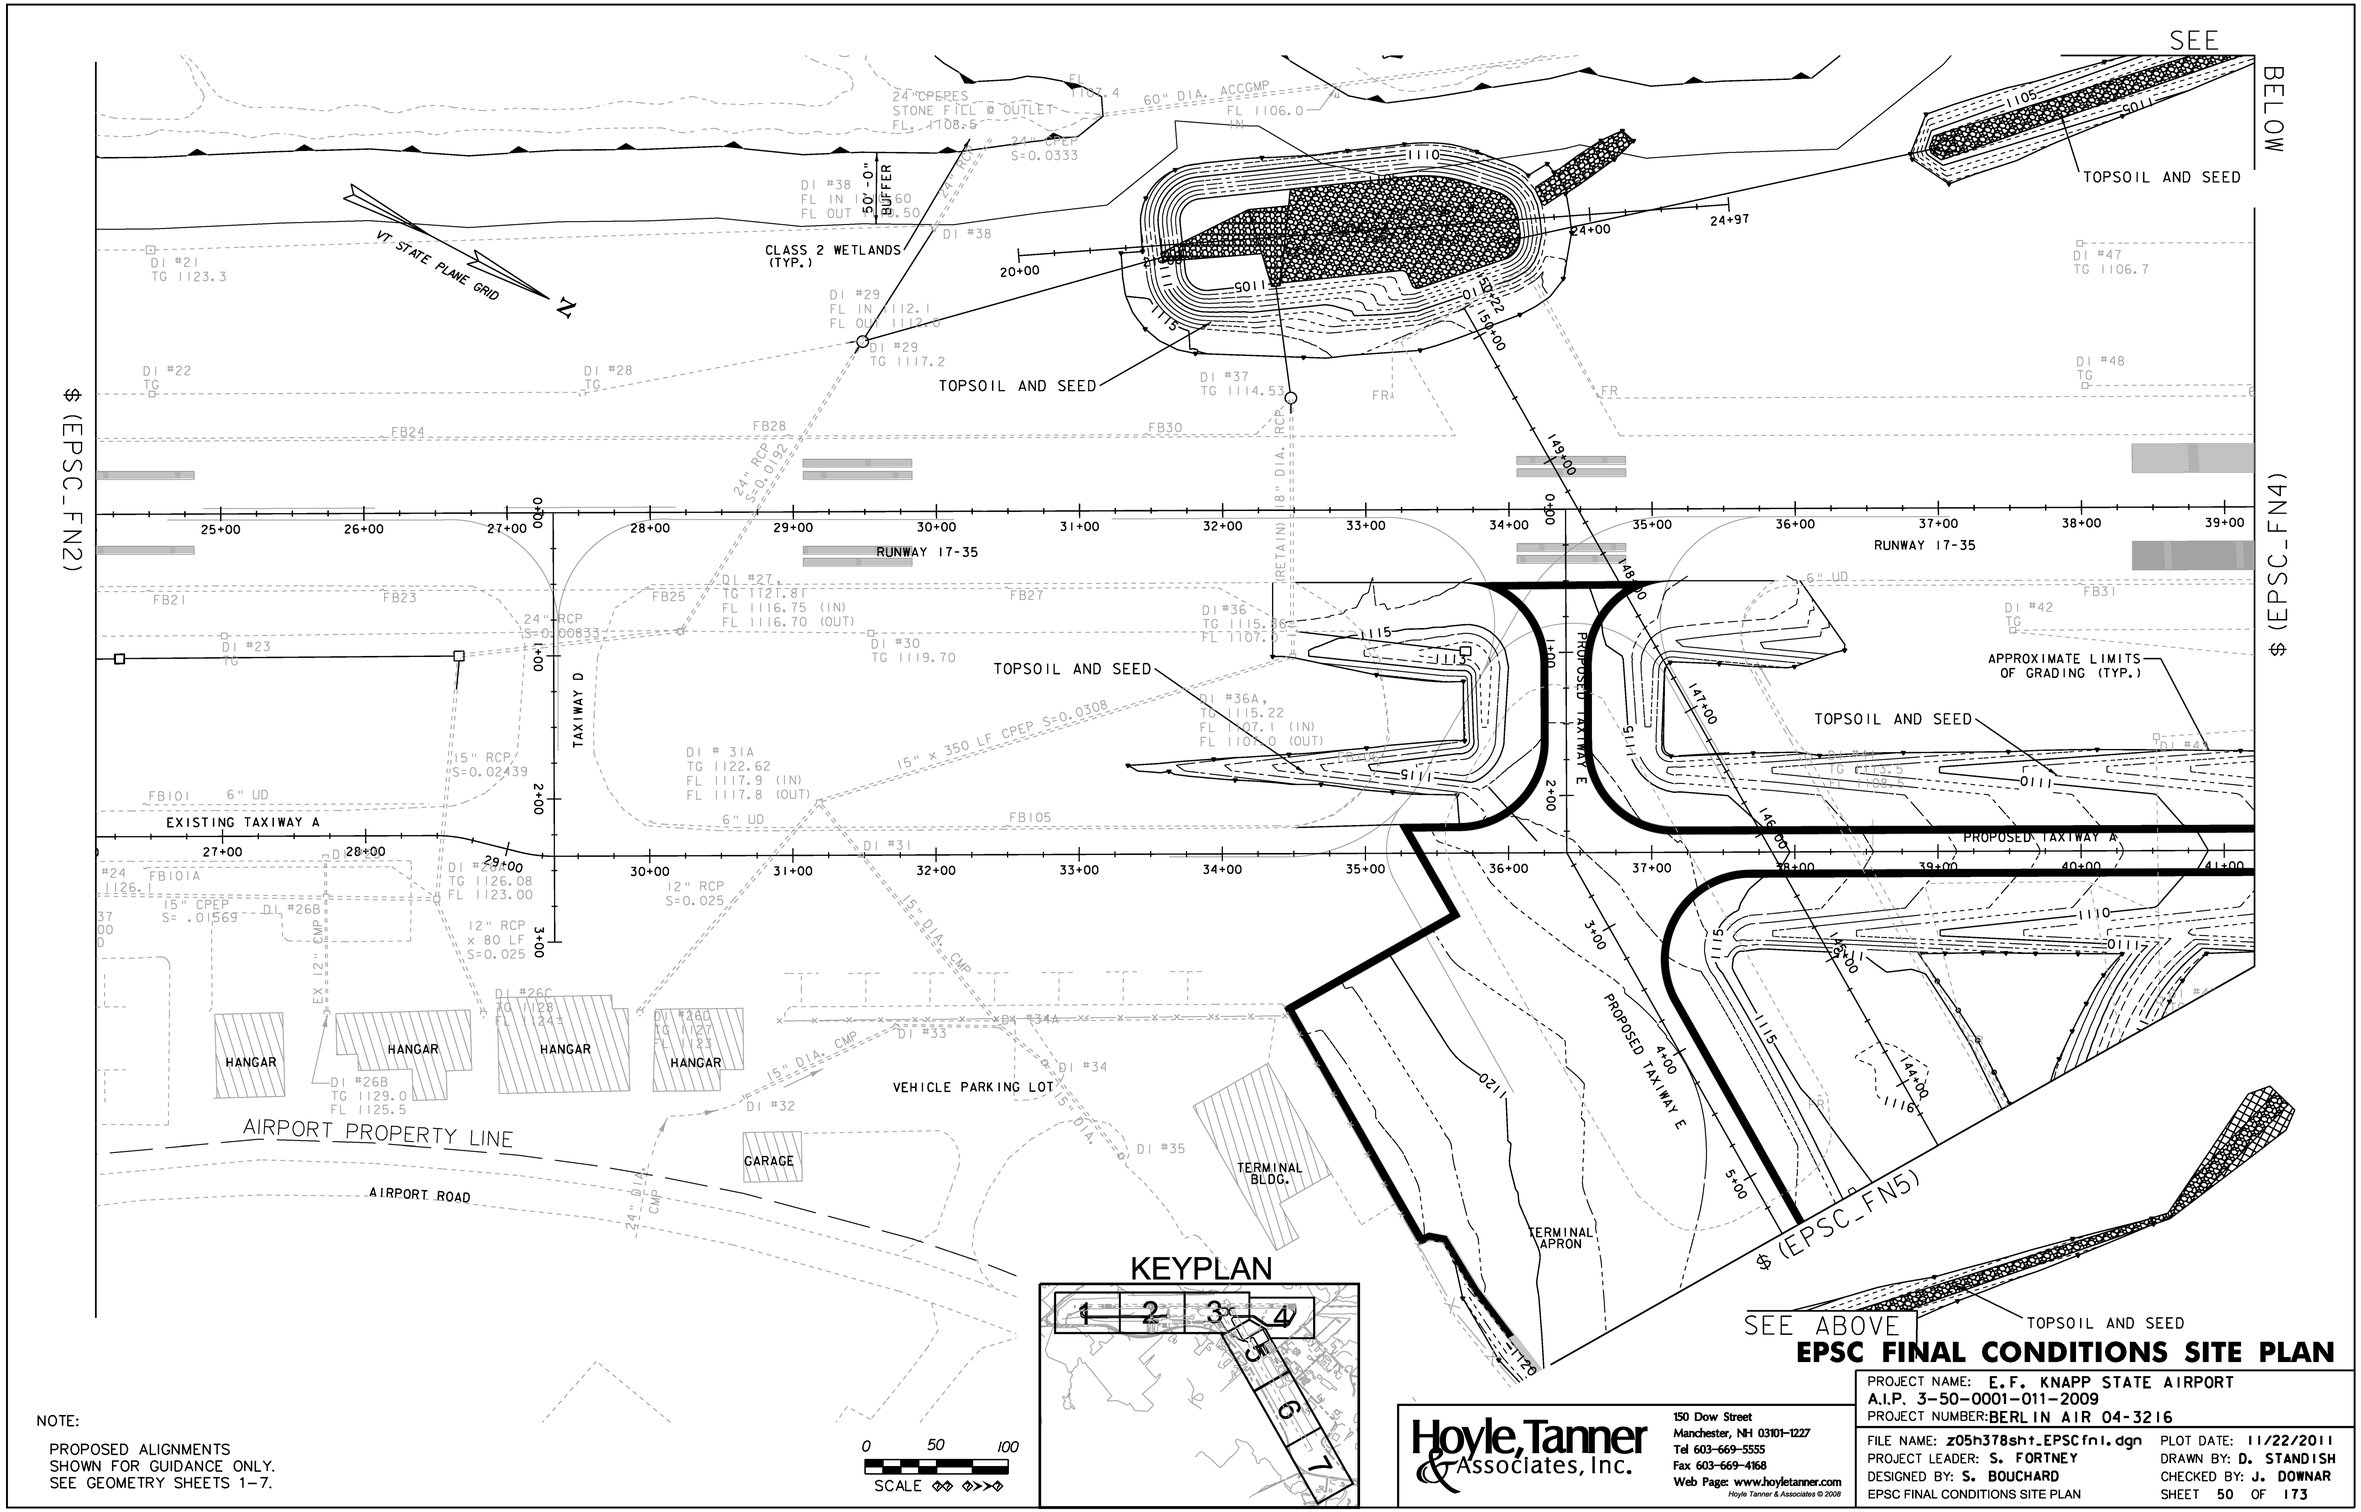

EPSC FINAL CONDITIONS SITE PLAN

NOTE:

PROPOSED ALIGNMENTS SHOWN FOR GUIDANCE ONLY. SEE GEOMETRY SHEETS 1–7.

Hoyle, Tanner & Associates, Inc.
150 Dow Street
Manchester, NH 03101-1227
Tel 603-669-5555
Fax 603-669-4168
Web Page: www.hoyletanner.com
Hoyle Tanner & Associates © 2008

PROJECT NAME: E.F. KNAPP STATE AIRPORT
A.I.P. 3-50-0001-011-2009
PROJECT NUMBER: BERLIN AIR 04-3216

FILE NAME: z05h378sht_EPSCfn1.dgn
PROJECT LEADER: S. FORTNEY
DESIGNED BY: S. BOUCHARD
EPSC FINAL CONDITIONS SITE PLAN

PLOT DATE: 11/22/2011
DRAWN BY: D. STANDISH
CHECKED BY: J. DOWNAR
SHEET 50 OF 173