SEE DEMOLITION SHT 1

SEE DEMOLITION SHT 3

VT STATE PLANE GRID

N

RUNWAY 17-35 5000.19'

REMOVE PAVEMENT STRIPING

REMOVE SIGN AND BASE

SAWCUT PAVEMENT

REMOVE EXISTING ELECTRICAL CABLES (TYP.)

EXISTING PIPE TO REMAIN

CAP PIPE INLET

REMOVE EXISTING PIPE

REMOVE EXISTING D. I.

REMOVE EXISTING HEADWALL

REMOVE EXISTING PIPE (TYP.)

REMOVE EXISTING PIPE

REMOVE EXISTING REFLECTOR (TYP.)

REMOVE D. I. AND CAP PIPE INLET

PAVEMENT REMOVAL

PROPOSED TAXIWAY A

EXISTING TAXIWAY A

TAXIWAY C

TOFA

RSA

HANGAR

APRON B

APRON C

AIRPORT PROPERTY LINE

AIRPORT ROAD

KEYPLAN

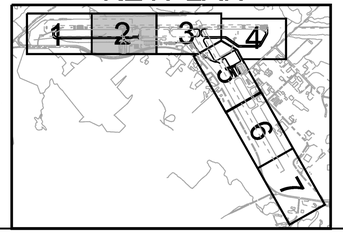

0 50 100

SCALE

Hoyle, Tanner & Associates, Inc.

150 Dow Street
Manchester, NH 03101-1227
Tel 603-669-5555
Fax 603-669-4168
Web Page: www.hoyletanner.com

Hoyle Tanner & Associates © 2008

PROJECT NAME: E.F. KNAPP STATE AIRPORT
A.I.P. 3-50-0001-011-2009
PROJECT NUMBER: BERLIN AIR 04-3216

FILE NAME: 302803_sht_demo.dgn
PROJECT LEADER: S. FORTNEY
DESIGNED BY: S. BOUCHARD
DEMOLITION SHT 2

PLOT DATE: 11/22/2011
DRAWN BY: D. STANDISH
CHECKED BY: J. DOWNAR