Record Drawings
Work completed in general conformance with contract plans.

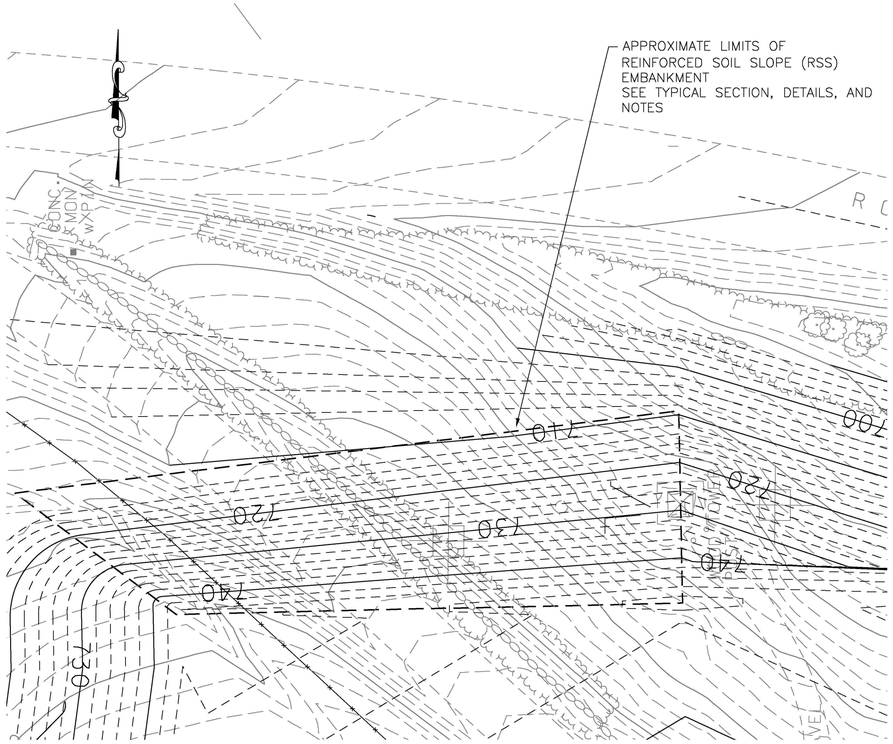

RSS PLAN
SCALE: 1"=60'

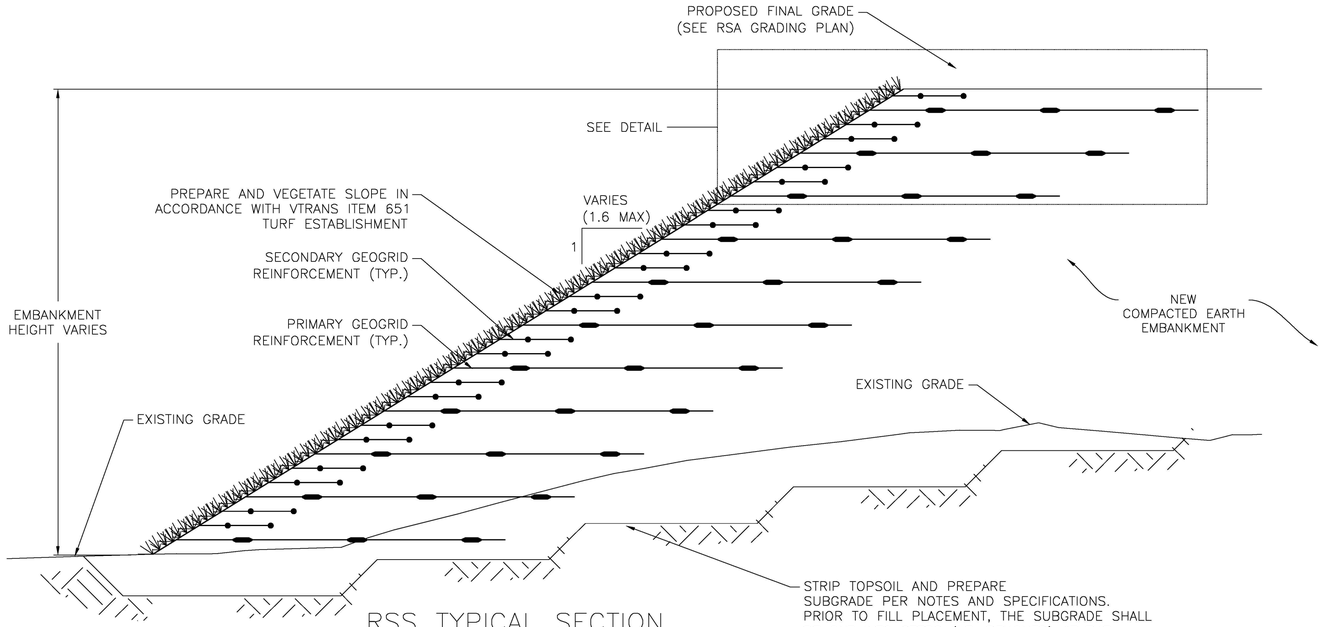

RSS TYPICAL SECTION
SCALE: 1"=10'

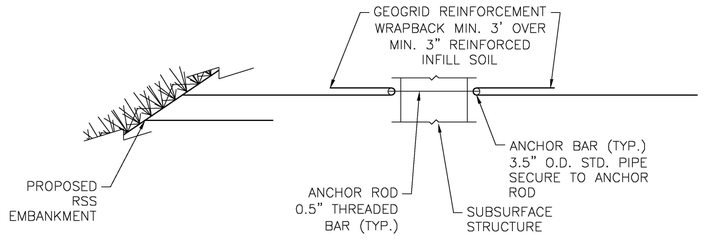

SUBSURFACE STRUCTURE DETAIL
SCALE: NONE

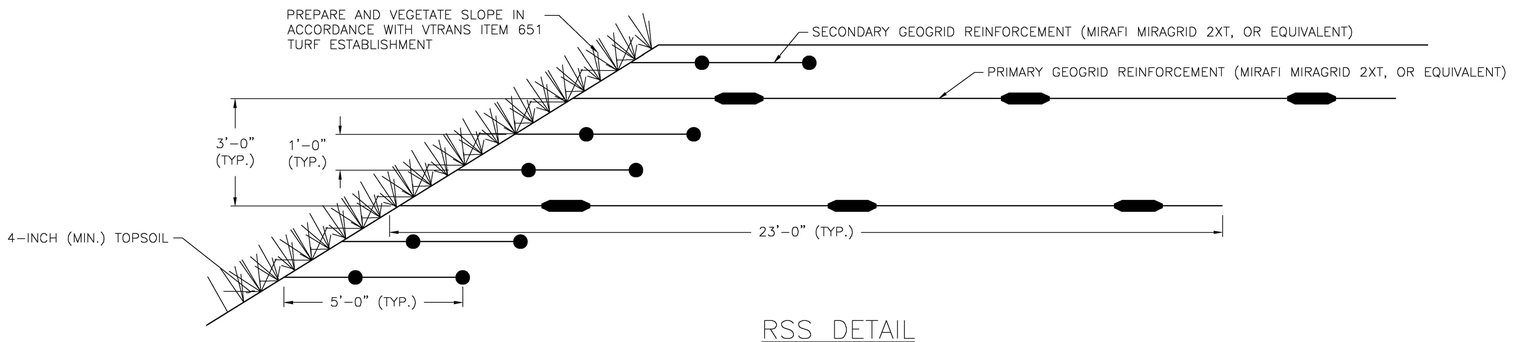

RSS DETAIL
SCALE: 1"=4'

AIP 3-50-0015-34

VERMONT AGENCY OF TRANSPORTATION

STATE OF VERMONT JOSEPH W. ROOT NO. 8555 CIVIL LICENSED PROFESSIONAL ENGINEER

GEODESIGN INCORPORATED
Geotechnical | Construction | Environmental
Engineers and Scientists

DRAWING NO. 1
SHEET 1 OF 2
PROJECT NO. 0880-011.5

URS
URS CORPORATION
3 CORPORATE DRIVE, SUITE 203
CLIFTON PARK, NY 12065
(518) 688-0015

PROJECT NAME: RUTLAND SOUTHERN VERMONT REGIONAL AIRPORT
CLARENDON, VERMONT
PROJECT NUMBER: AV14-8018-300

FILE NAME: z07hl24details_rss.dgn
PROJECT LEADER: ULF
DESIGNED BY: RPJ
RSS PLAN, TYPICAL SECTIONS & DETAILS
PLOT DATE: 6/2/2013
DRAWN BY: RPJ / JDG
CHECKED BY: JWK / JAG
SHEET 19 OF 36

6/2/2013
P:\CADD\Consultants\z07hl24details_rss.dgn

PROJECT RECORD DRAWINGS