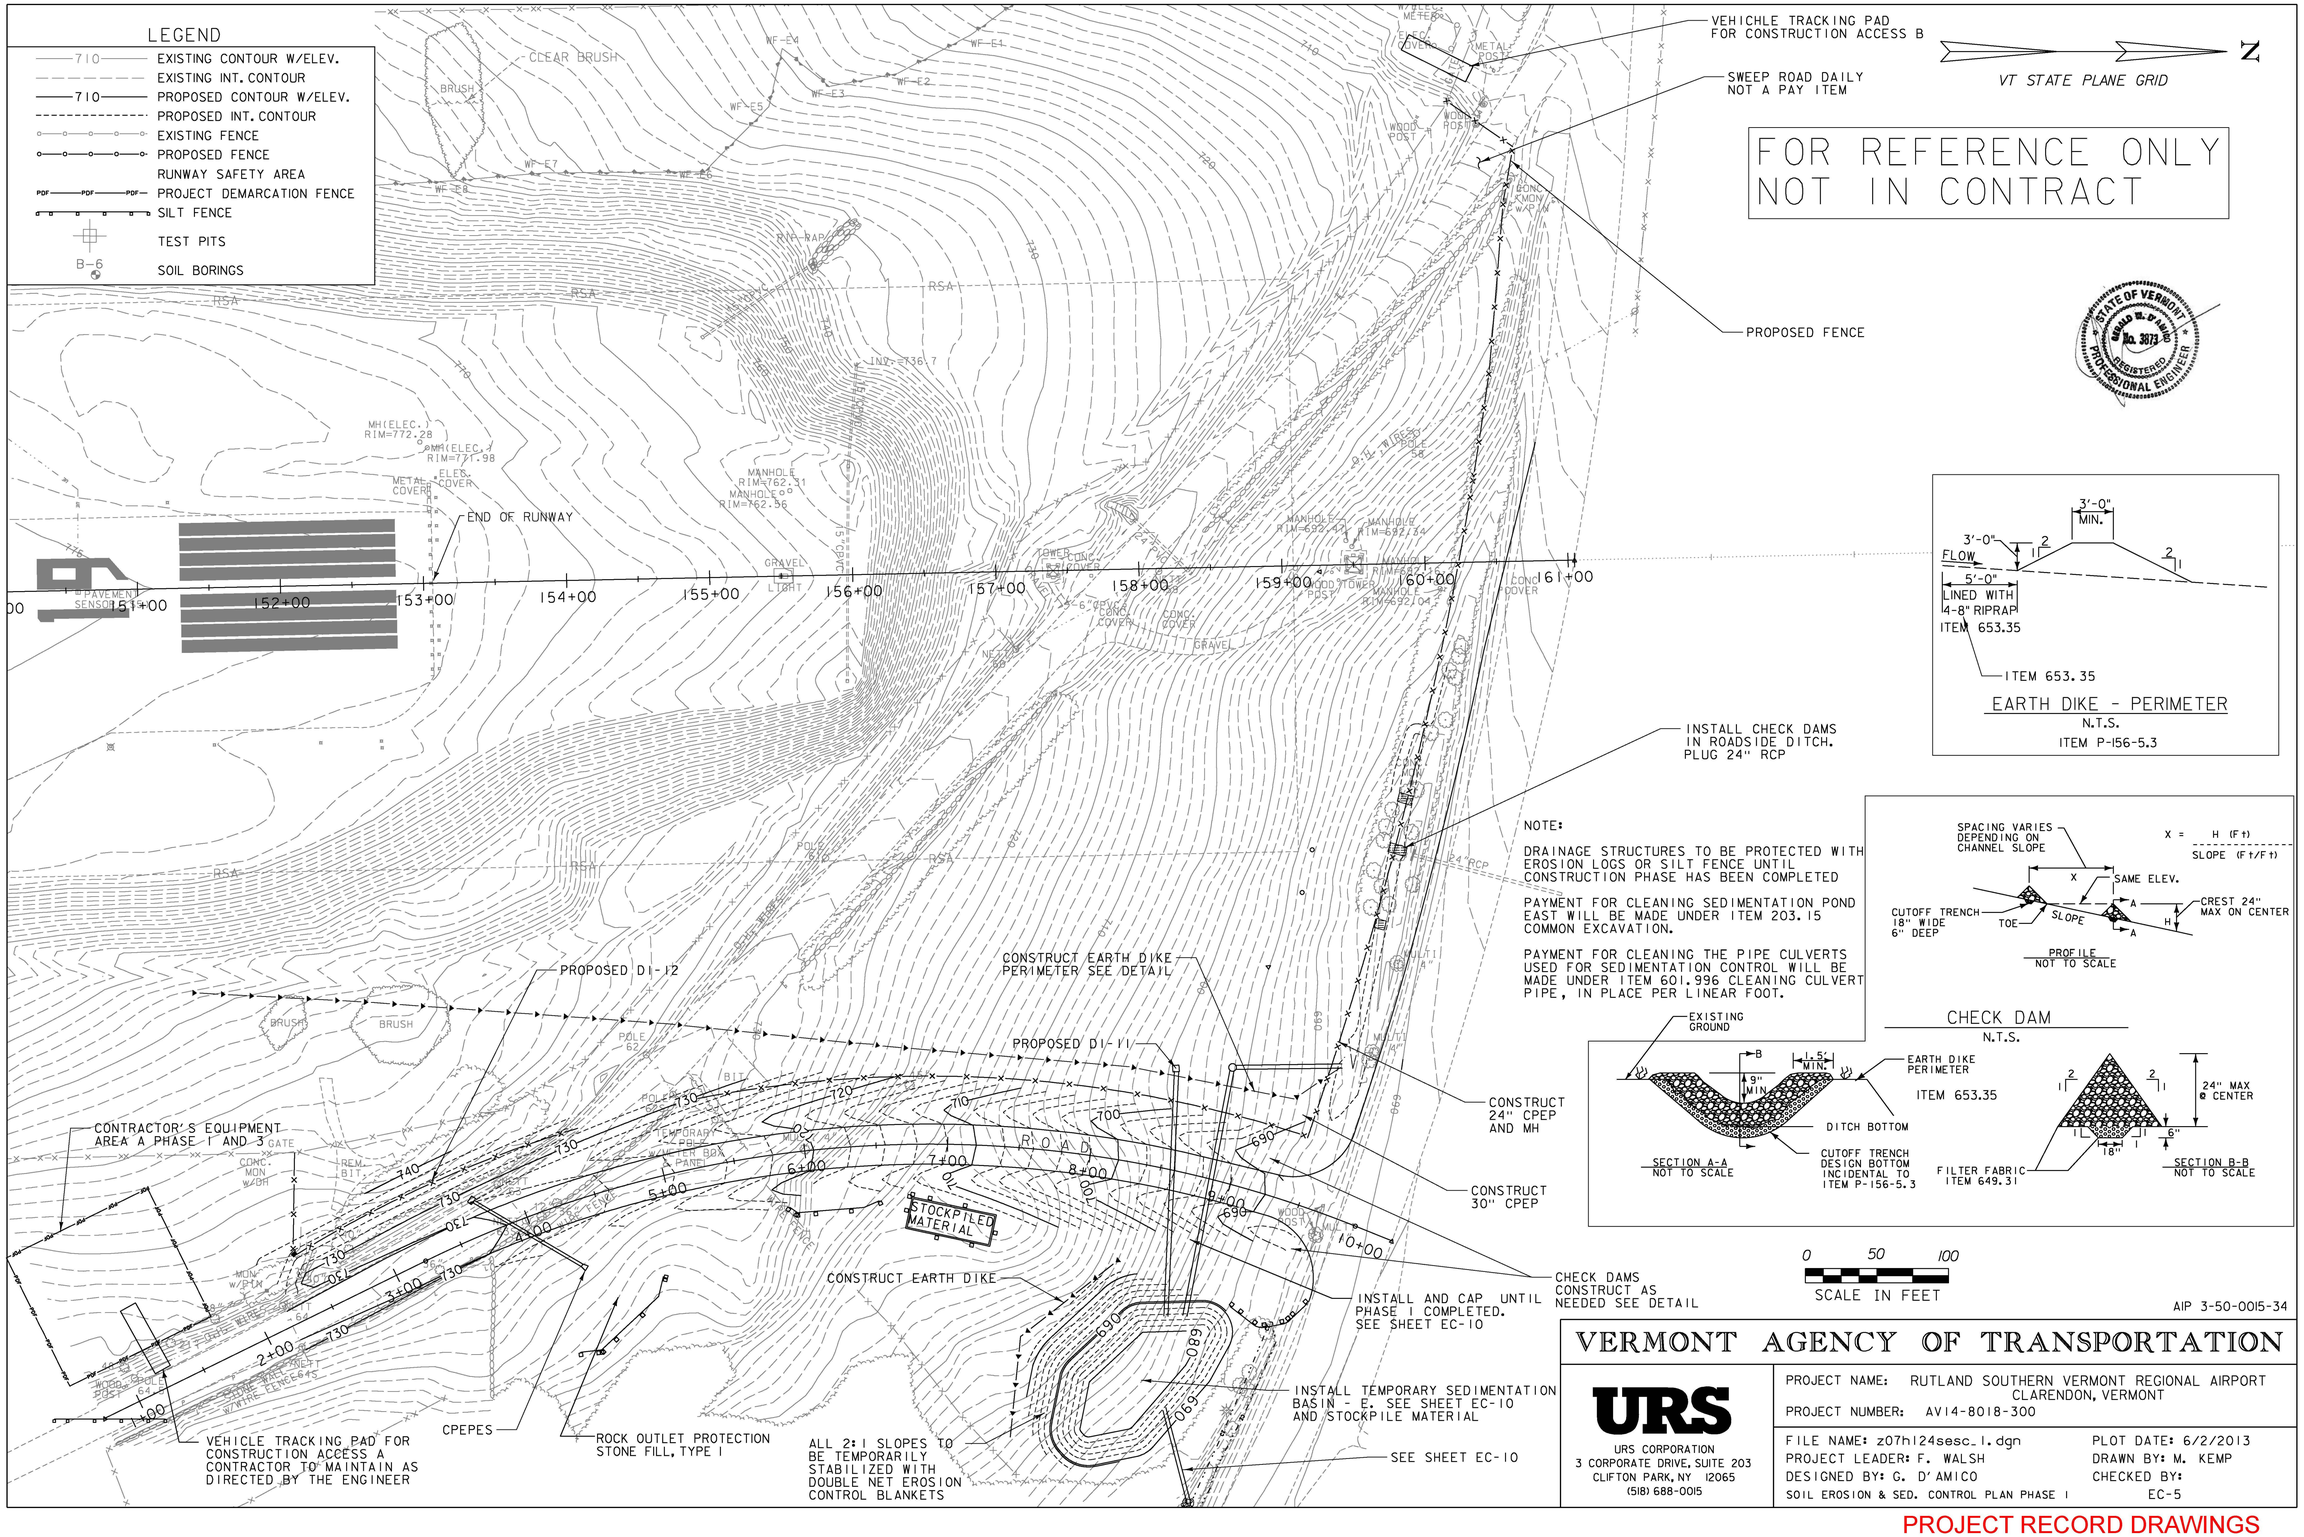

VERMONT AGENCY OF TRANSPORTATION

URS
URS CORPORATION
3 CORPORATE DRIVE, SUITE 203
CLIFTON PARK, NY 12065
(518) 688-0015

PROJECT NAME: RUTLAND SOUTHERN VERMONT REGIONAL AIRPORT
CLARENDON, VERMONT
PROJECT NUMBER: AV14-8018-300

FILE NAME: z07h124sesc_1.dgn
PROJECT LEADER: F. WALSH
DESIGNED BY: G. D'AMICO
SOIL EROSION & SED. CONTROL PLAN PHASE 1

PLOT DATE: 6/2/2013
DRAWN BY: M. KEMP
CHECKED BY:
EC-5

6/2/2013
P:\CADD\Consultants\z07h124sesc_1.dgn

PROJECT RECORD DRAWINGS