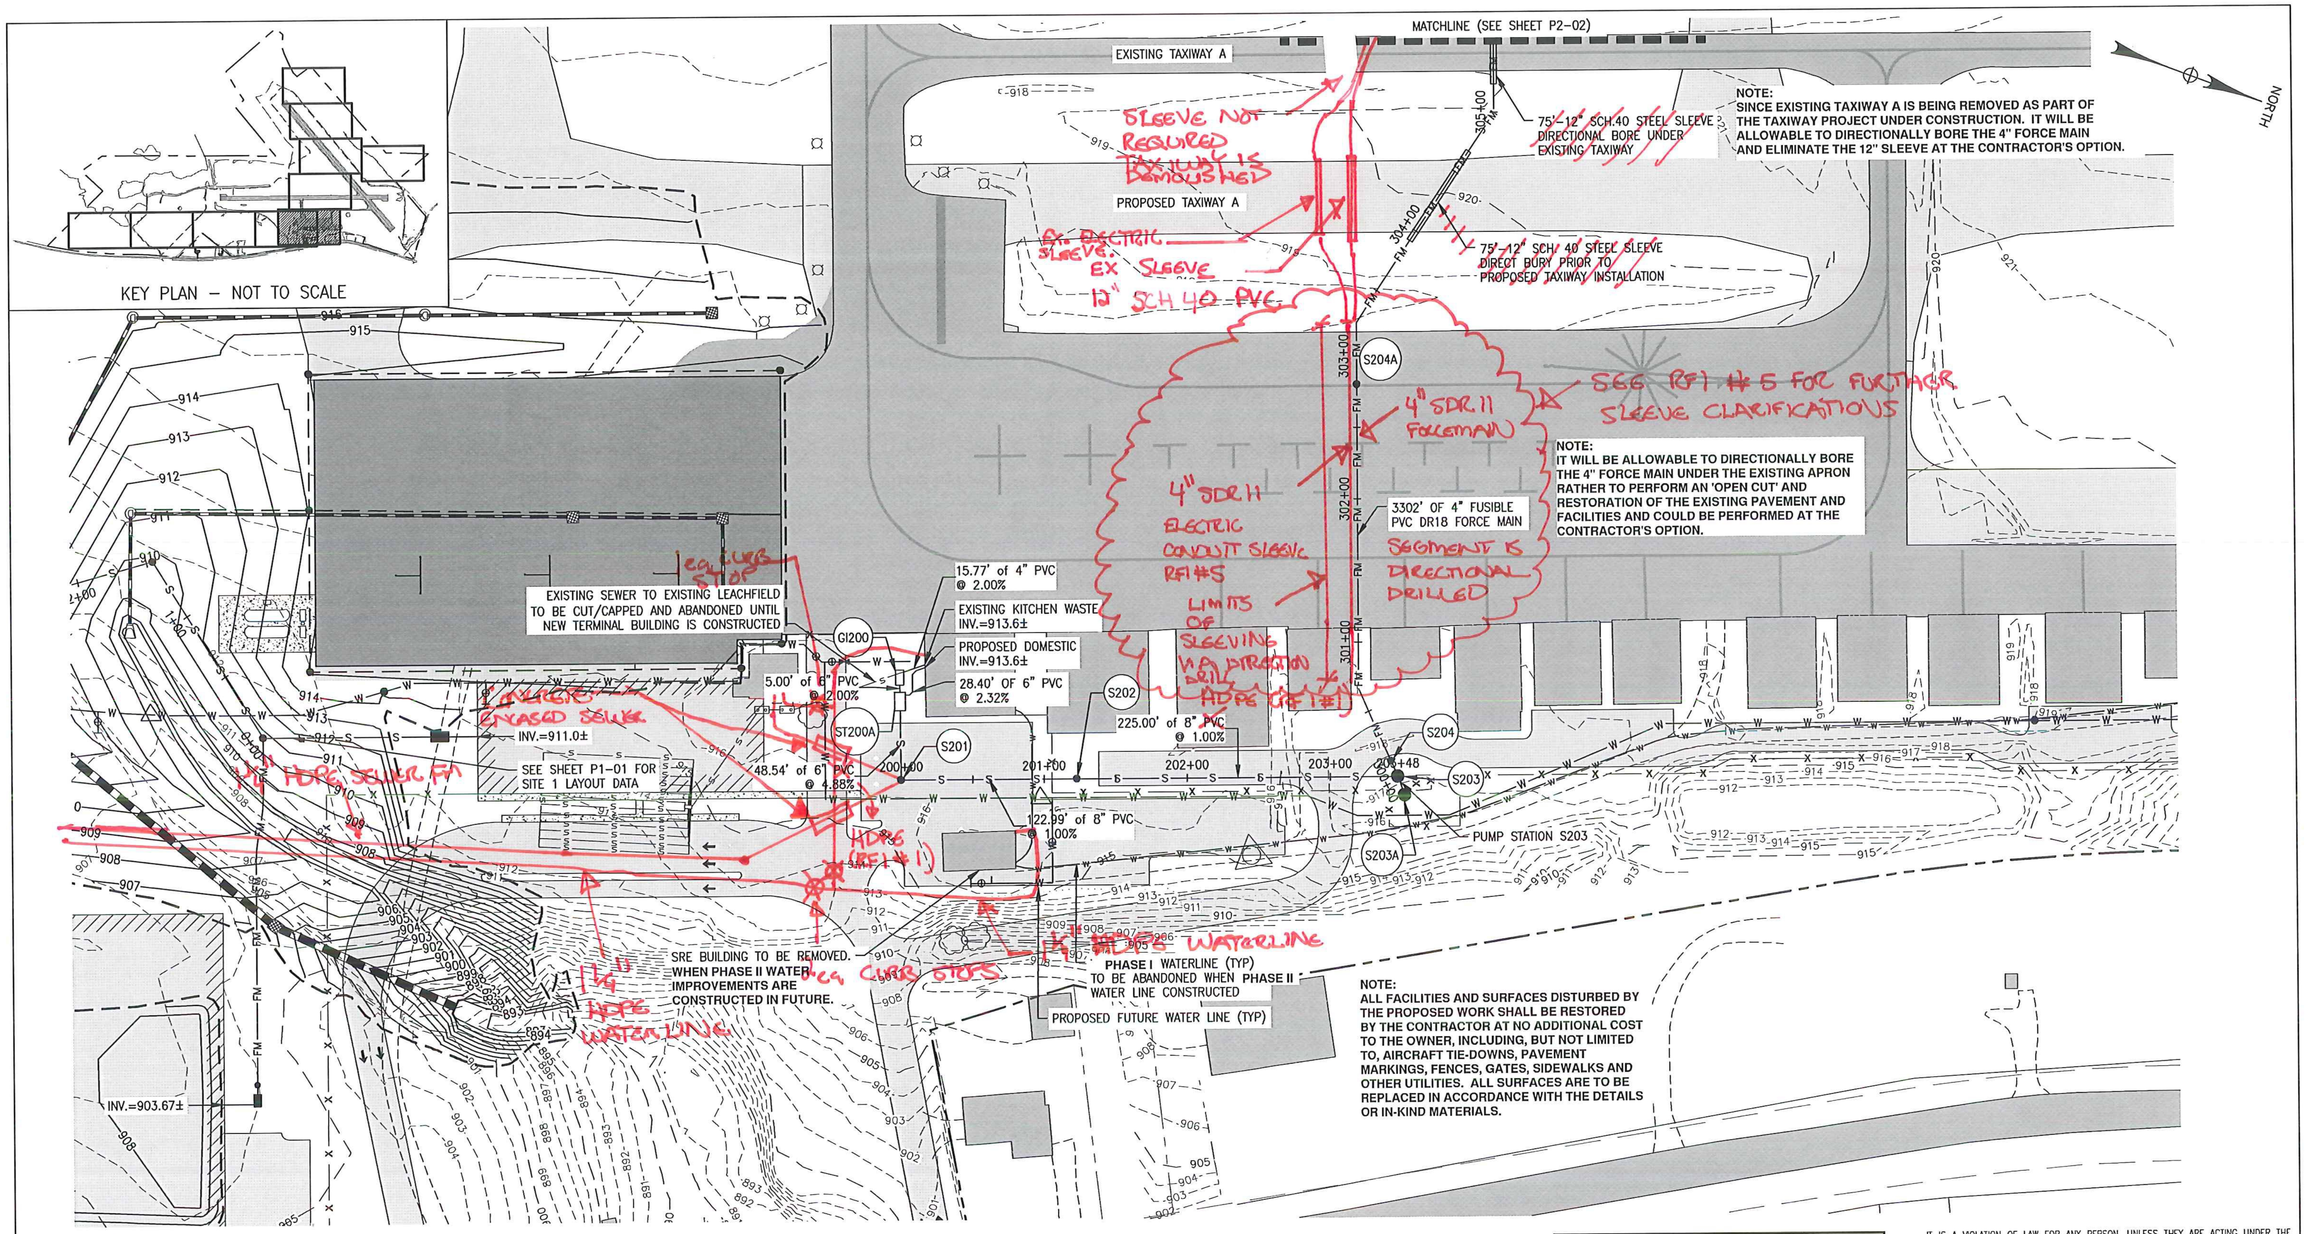

LEGEND:

- EXISTING CONTOUR
- PROPOSED CONTOUR
- PROPERTY LINE
- WETLAND
- TREE LINE
- SANITARY FORCE MAIN
- SANITARY MANHOLE
- SANITARY GRAVITY SEWER LINE
- SANITARY STRUCTURE IDENTIFICATION
- STORMDRAIN PIPE
- STORMDRAIN STRUCTURE
- FUTURE WATER LINE
- TEMPORARY WATER LINE

NOTES:

1. REFER TO SHEET P2-05 FOR STRUCTURE DATA.
2. REFER TO SHEET PR2-01 FOR GRAVITY SEWER PROFILE.
3. REFER TO SHEET PR2-02 FOR SITE 2 FORCE MAIN SEWER PROFILE.
4. REFER TO SHEET SD-03 FOR PUMP STATION S203 DETAILS.
5. CARRYING PIPE INSIDE SLEEVES SHALL USE CASCADE WATERWORKS MFG. CASING SPACERS MODEL CCS OR EQUAL. ENDS OF SLEEVES SHALL USE CASCADE END SEALS MODEL CCES OR EQUAL.

0 50 100 150 FT
SCALE

SCHEDULE B - WASTEWATER SYSTEM - BID SET
VTRANS PROJECT #AVI157046-301
JUNE 2016

REV	DATE	DESCRIPTION	BY
5	5/3/15	COLD WEATHER MODIFICATIONS	BMB
4	4/29/15	PERMITTING MODIFICATIONS	SKI
3	1/30/15	WW SYSTEM MODIFICATIONS	BMB
2	8/5/14	ANR COMMENTS	TCB
1	4/18/14	ADD 400-SERIES TEST PITS	CH

IT IS A VIOLATION OF LAW FOR ANY PERSON, UNLESS THEY ARE ACTING UNDER THE DIRECT DIRECTION OF A LICENSED PROFESSIONAL ENGINEER, ARCHITECT, LANDSCAPE ARCHITECT, OR LAND SURVEYOR, TO ALTER AN ITEM IN ANY WAY. IF AN ITEM BEARING THE STAMP OF A LICENSED PROFESSIONAL IS ALTER, THE ALTERING ENGINEER, ARCHITECT, LANDSCAPE ARCHITECT, OR LAND SURVEYOR SHALL STAMP THE DOCUMENT AND INCLUDE THE NOTATION "ALTERED BY" FOLLOWED BY THEIR SIGNATURE, THE DATE OF SUCH ALTERATION, AND A SPECIFIC DESCRIPTION OF THE ALTERATION.

VTrans Working to Get You There Vermont Agency of Transportation

STATE OF VERMONT TERRENCE C. BRADBURY NO. 8852 CIVIL LICENSED PROFESSIONAL ENGINEER

McFarland Johnson
53 REGIONAL DRIVE
CONCORD, NH 03301

NEWPORT STATE AIRPORT
COVENTRY, VERMONT
NEWPORT WASTEWATER

SITE 2 – PIPING LAYOUT PLAN 1

SCALE: 1" = 50'	DESIGN: TCB	P2-01
DRAWN: TCB	PROJECT: 17958.01	
CHECKED: BLS	DATE: JUNE, 2014	20 OF 36