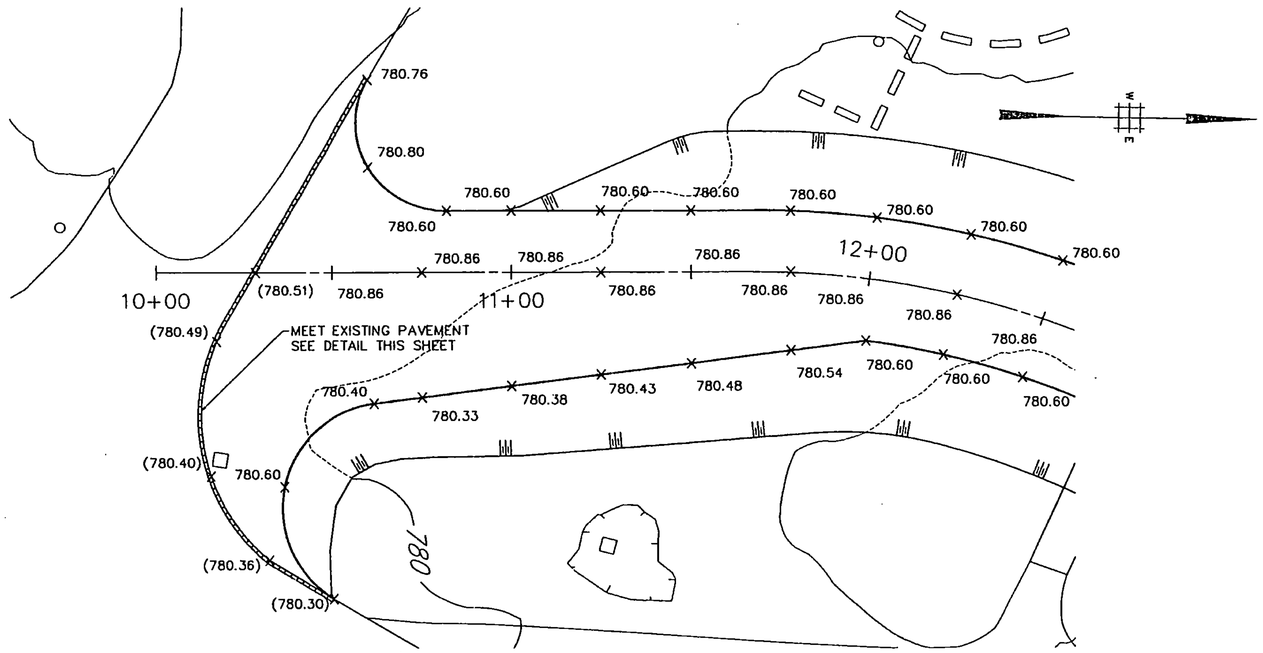

PROPOSED FINISHED PAVEMENT ELEVATIONS AT INTERSECTION OF T/W 'E' AND T/W 'C'

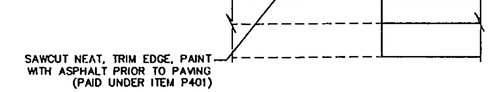

MEET EXISTING PAVEMENT

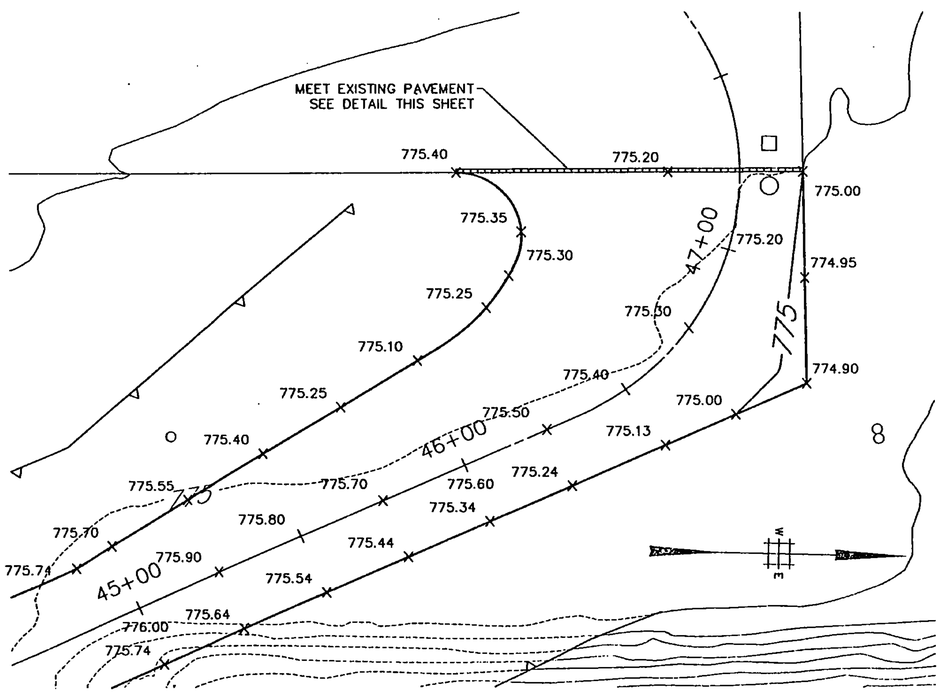

PROPOSED FINISHED PAVEMENT ELEVATIONS AT INTERSECTION OF T/W 'E' AND R/W 1-19

20' 10' 0 20' 40'

SEAL

REVISION	DESCRIPTION	DRAWN BY	CHECKED BY	APPR BY	DATE

PROJECT NO. 7804

Envirodyne Engineers, Inc.
41 East 42nd St. Suite 1015
New York, NY 10017

DATE: AUG. 23, 1993 | DESIGNED BY: F.S. | DRAWN BY: D.W. | CHECKED BY: L.G.

SCALE: 1" = 20'

RUTLAND STATE AIRPORT
CLARENDON, VERMONT

TAXIWAY E

GRADING DETAILS

DRAWING NO.
GD5

SHEET 15 OF 11