NOTE:

1. EXISTING RUNWAY 1-19 IS 150' WIDE. NEW RUNWAY TO BE 100' WIDE.

CURVE DATA				
#	RADIUS	LENGTH	TANGENT	DELTA
1	100.00	157.08	100.00	90°00'00"
2	100.00	157.08	100.00	90°00'00"

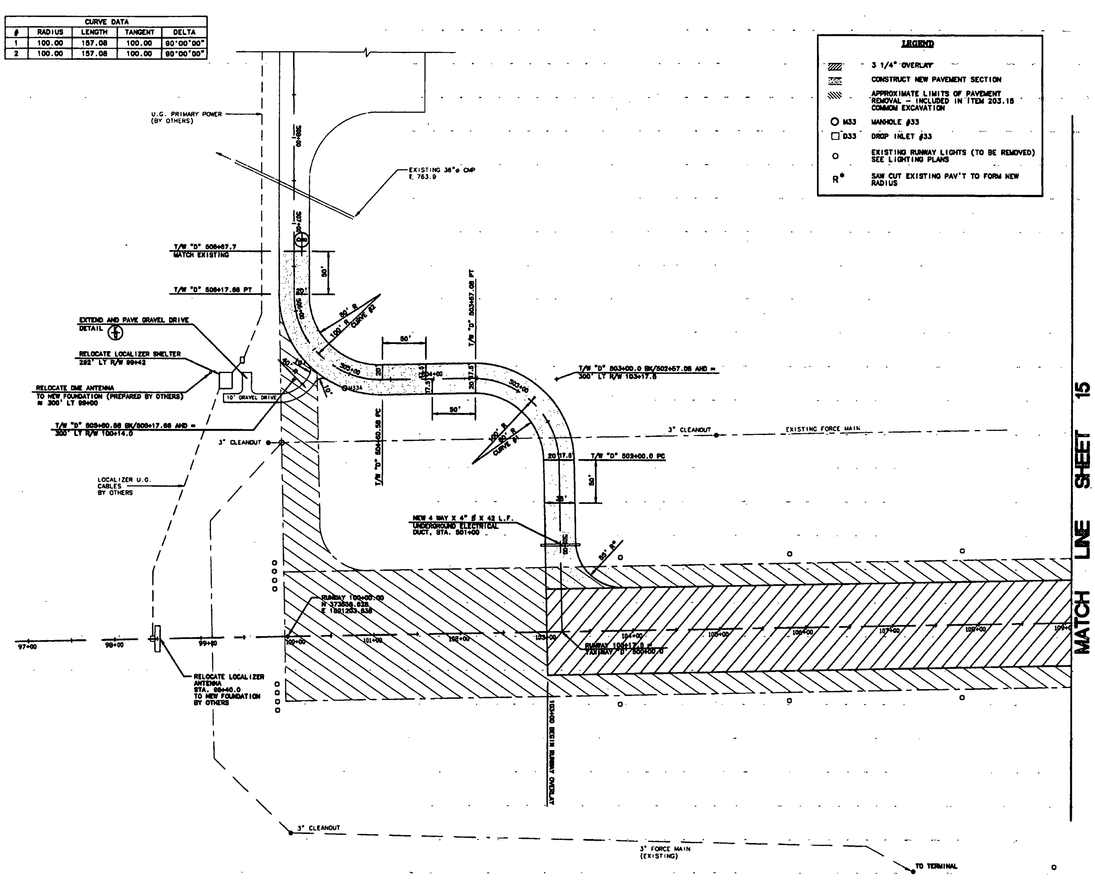

REV.	DATE	DESCRIPTION

Job No. 90213.00 File No. 1:\90213\PAVING

RUTLAND STATE AIRPORT
CLARENDON, VERMONT

PAVING PLAN & GEOMETRIC LAYOUT

URS Greiner, Inc.
3 MARCUS BOULEVARD
ALBANY, NEW YORK

Designed by: Date: 10/97
Drawn by: B. SICILIA 3/97
Checked by: Date:
Approved by: B. SICILIA 5/97

Scale: HOR. = 1" = 50' VERT. = NONE

Date: 5/5/97

Sheet 14 Of 65

Sheet No. 14

AIP 3-50-0015-11