NOTES:

MATCH LINE SHEET 17

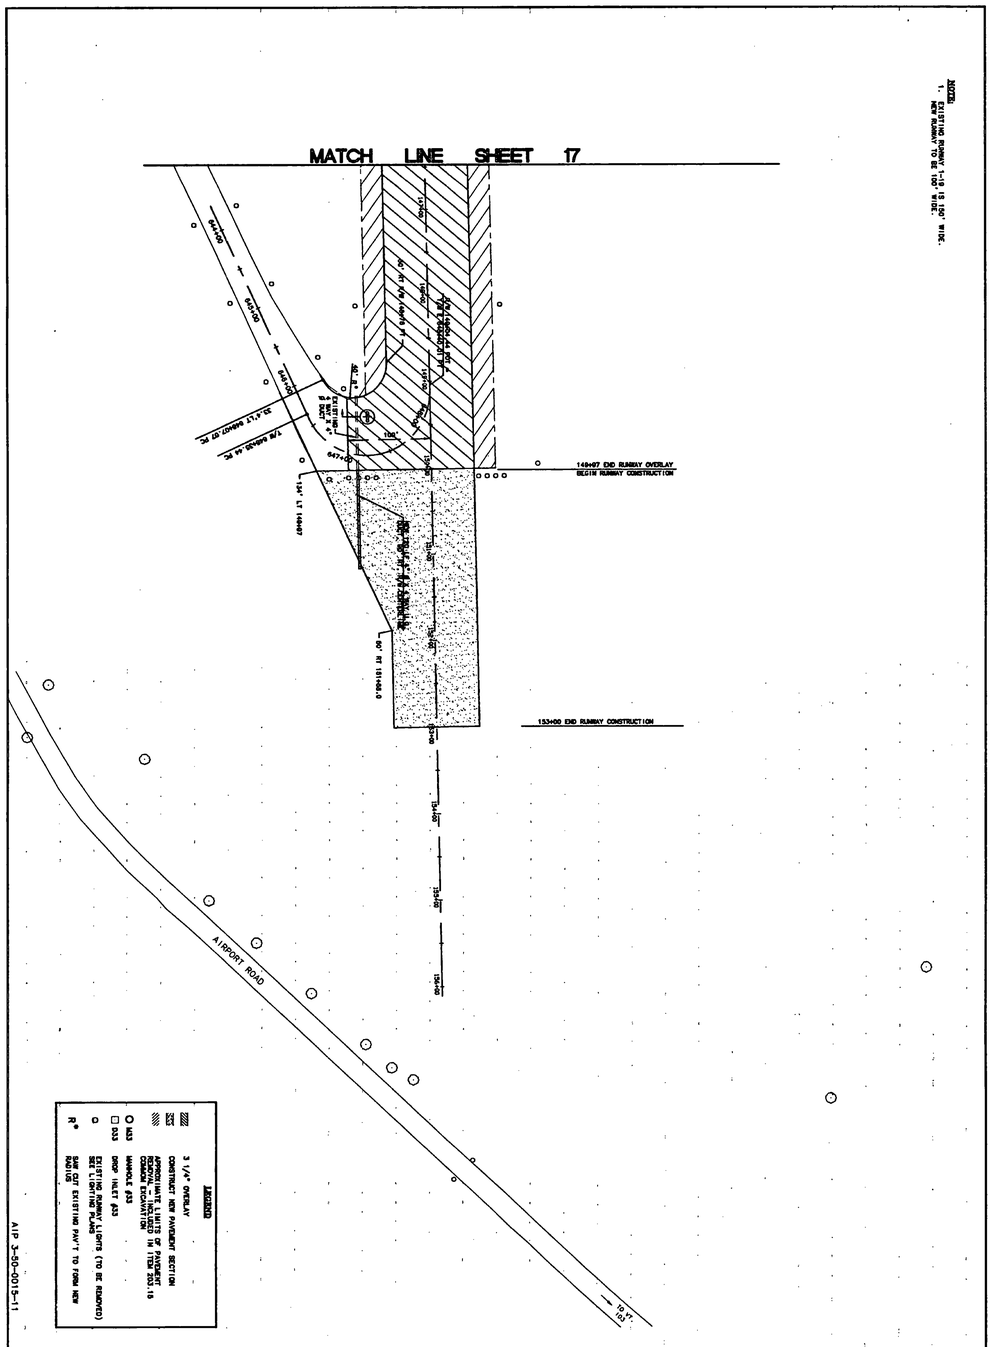

LEGEND

- 3 1/4" OVERLAY
- CONSTRUCT NEW PAVEMENT SECTION
- EXISTING RUNWAY LIGHTS (TO BE REMOVED)
- SEE LIGHTING PLANS
- R EXISTING PAV'T TO FORM NEW RADIUS

Designed by: C D'ANGELO	Date: 2/97	
Drawn by: M MCCALLA	3/97	
Checked by: C D'ANGELO	5/5/97	
Approved by: M CHURCHILL	5/5/97	

Scale: 1" = 100'

Date: 6/24/97

Sheet 18 OF 69

Sheet No. 18

URS Greiner, Inc.
3 MARCUS BOULEVARD
ALBANY, NEW YORK

RUTLAND STATE AIRPORT
CLARENDON, VERMONT

PAVING PLAN & GEOMETRIC LAYOUT

REV.	DATE	DESCRIPTION

Job No. 14511Z.00

File No. I:\V14511Z\MI-PP04

AIP 3-50-0015-11