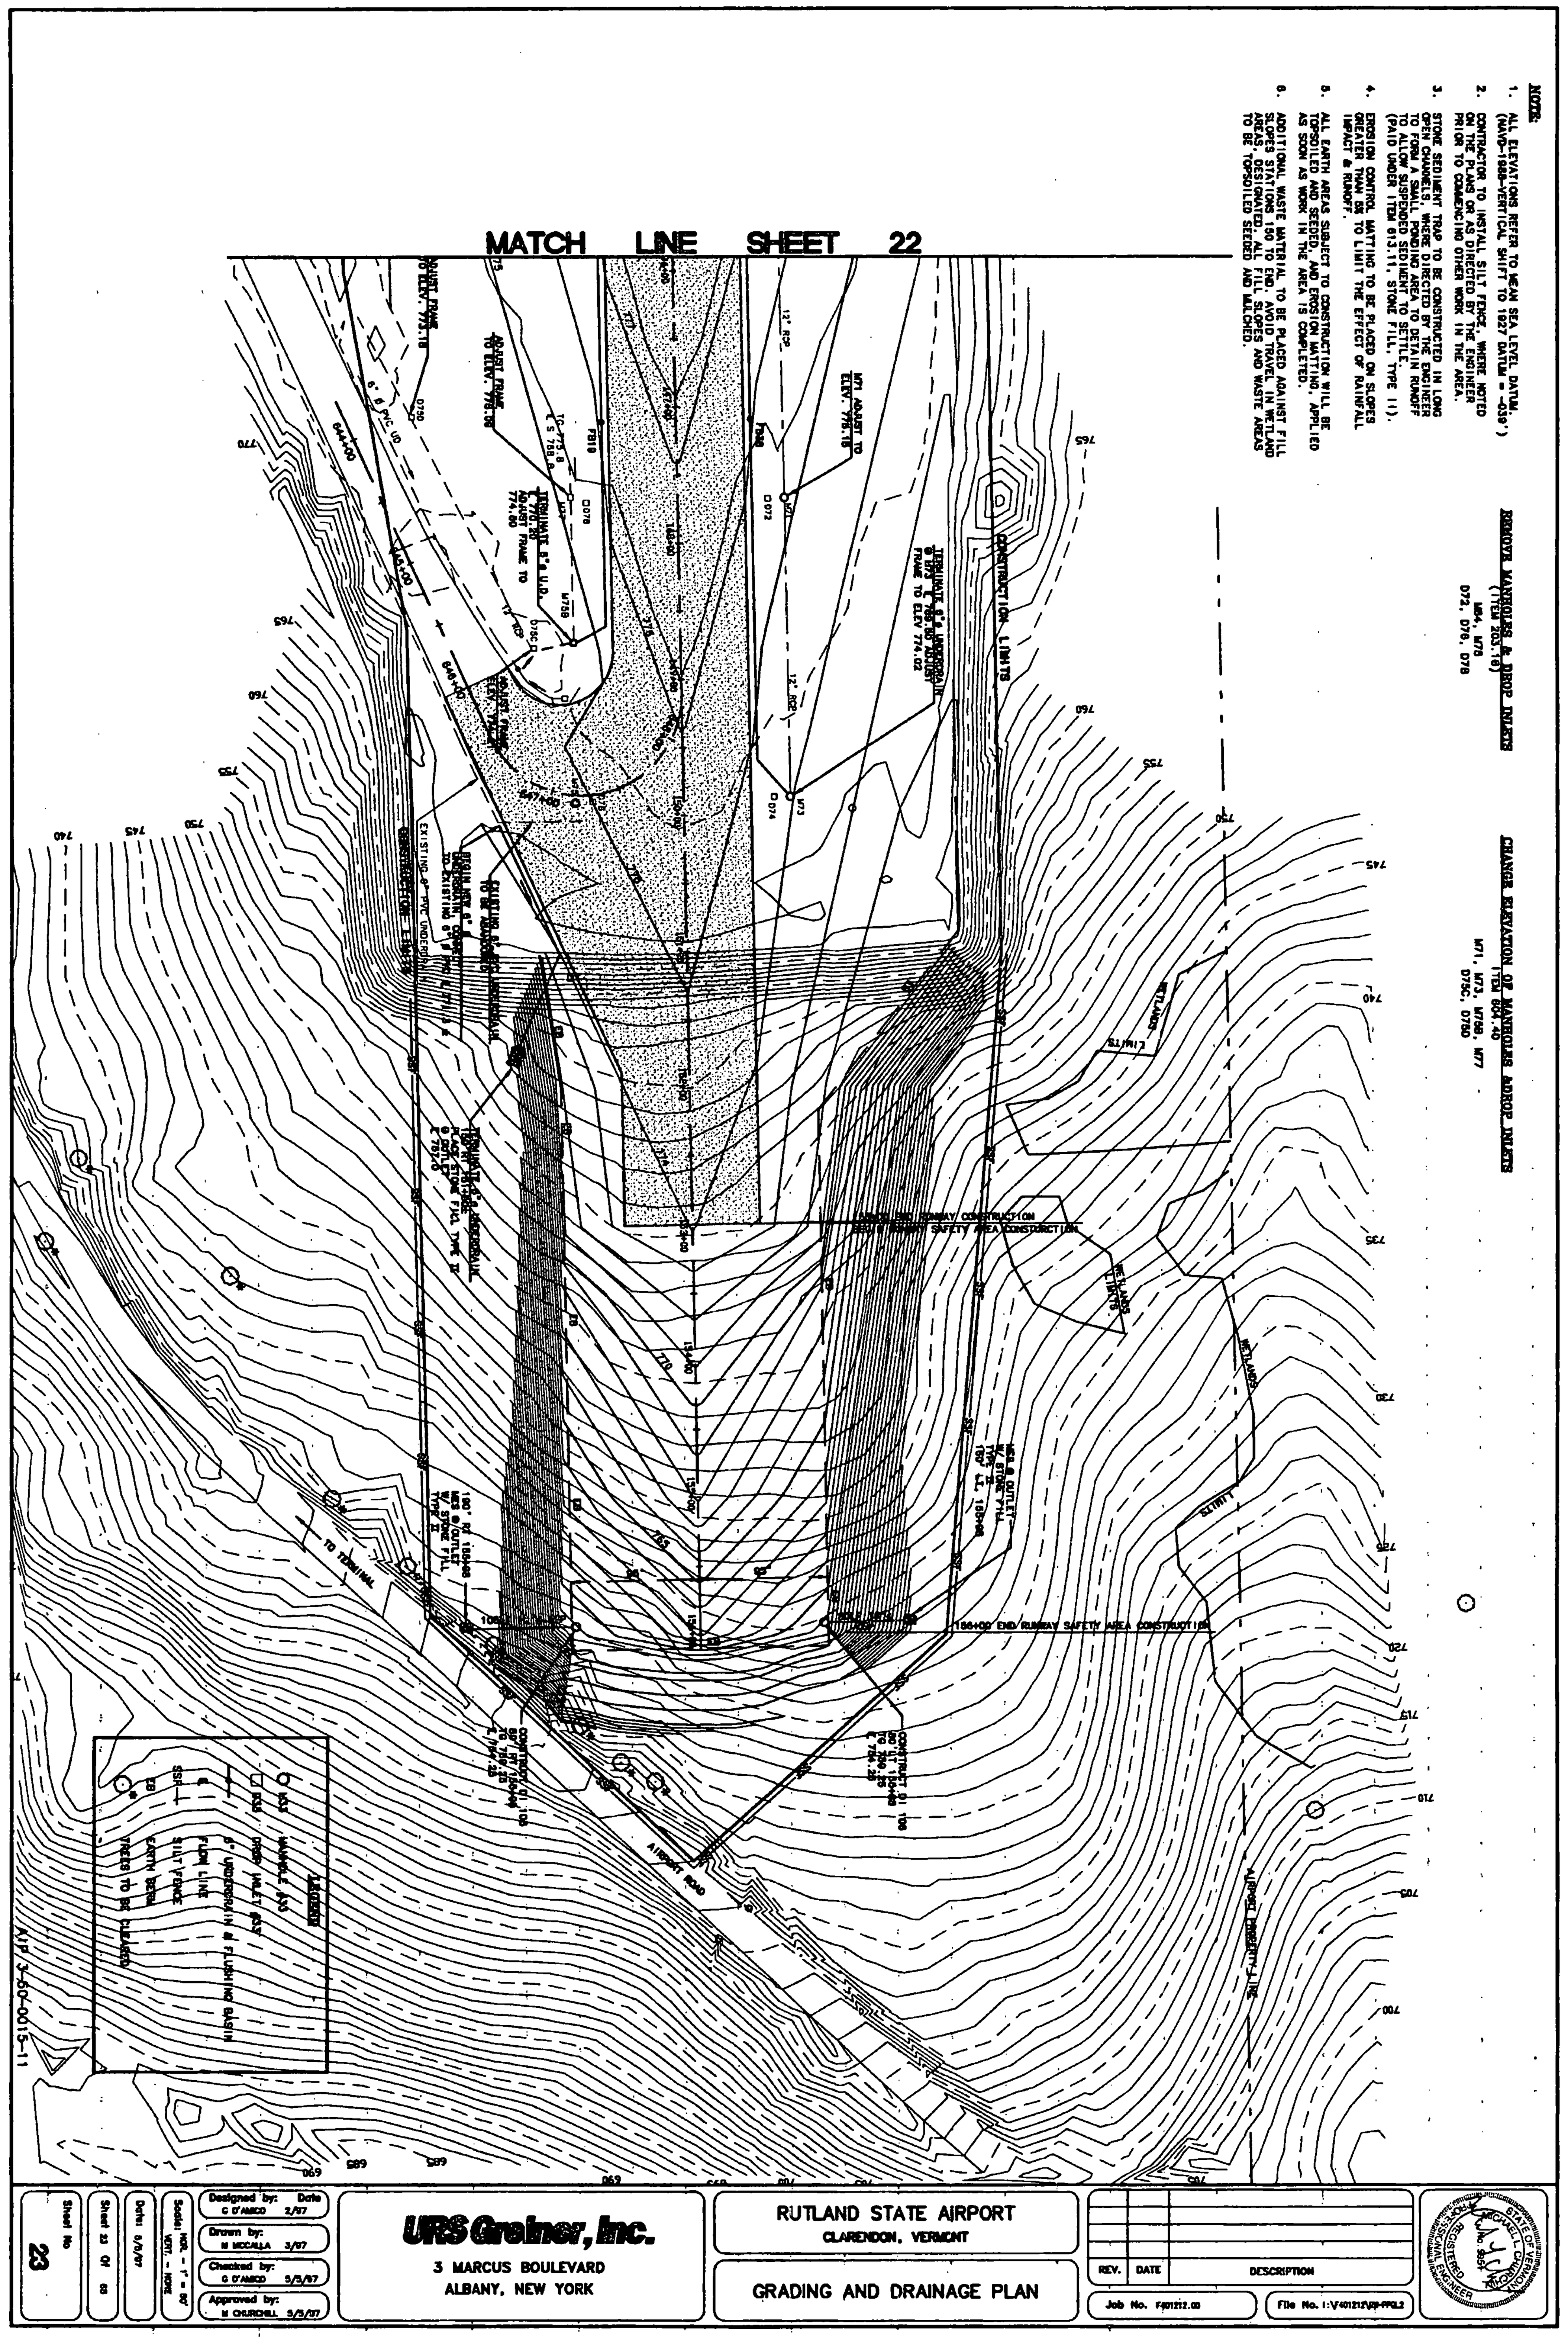
MATCH LINE SHEET 22
URS Greiner, Inc.
3 MARCUS BOULEVARD
ALBANY, NEW YORK
RUTLAND STATE AIRPORT
CLARENDON, VERMONT
GRADING AND DRAINAGE PLAN
REV.
DATE
DESCRIPTION
Designed by: G D'AMICO Date 2/97
Drawn by: M MCCALLA 3/97
Checked by: G D'AMICO 5/5/97
Approved by: M CHURCHILL 5/5/97
Sheet No 23