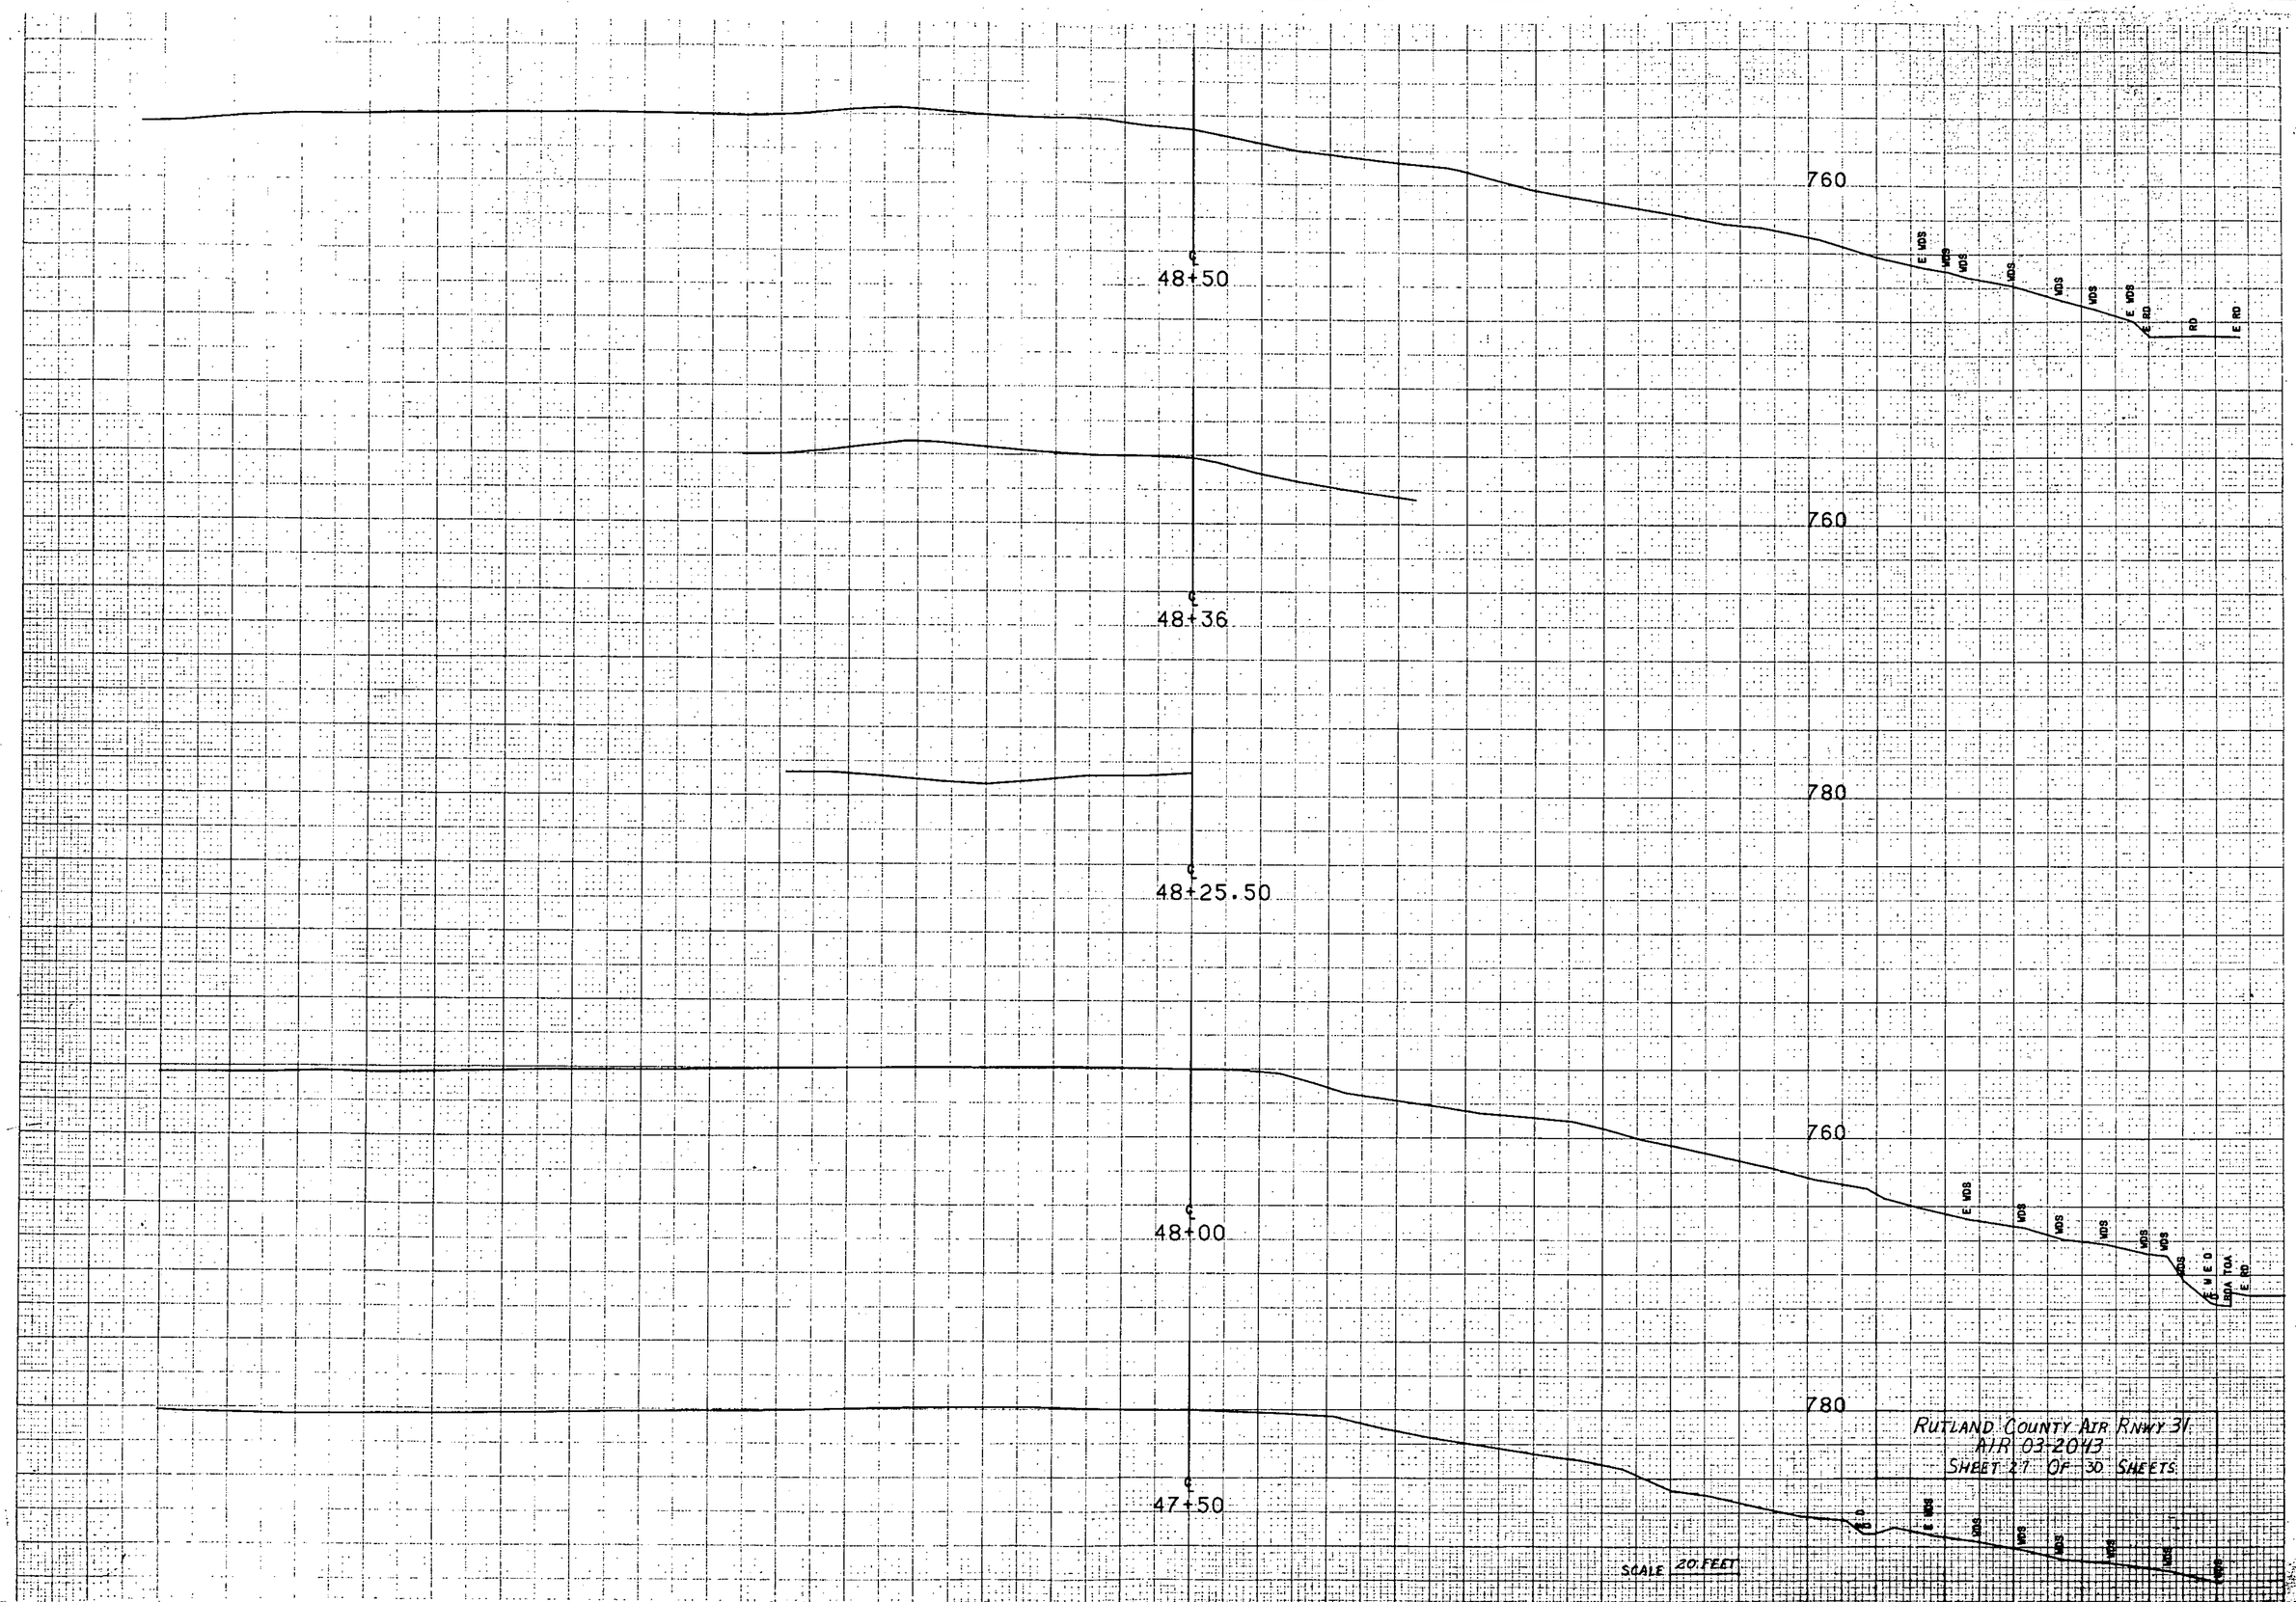
760
E VDS
VDS
VDS
VDS
VDS
VDS
VDS
E RD
E RD
RD
E RD
48+50
760
48+36
780
48+25.50
760
E VDS
VDS
VDS
VDS
VDS
VDS
VDS
E W E O
LBDA TOA
E RD
48+00
780
RUTLAND COUNTY AIR RNWY 31
AIR 03-2043
SHEET 27 OF 30 SHEETS
47+50
E O
E VDS
VDS
VDS
VDS
VDS
VDS
VDS
SCALE 20 FEET