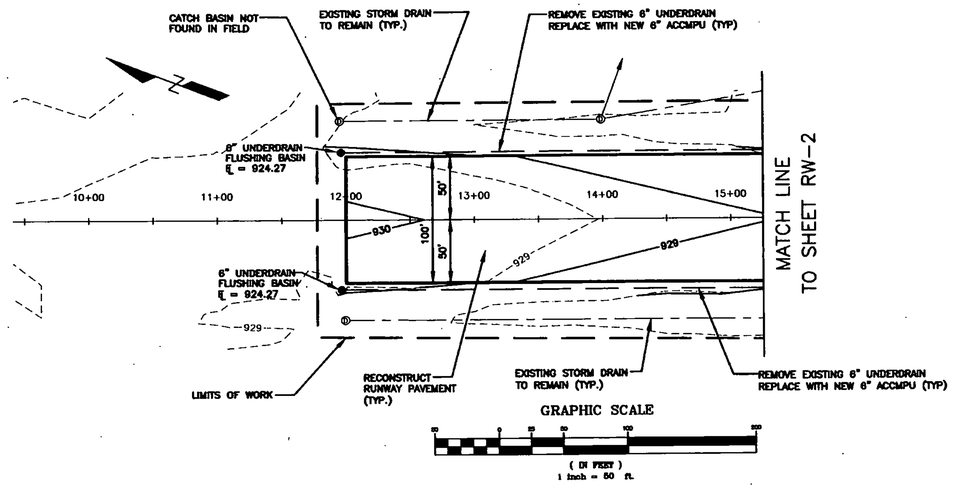

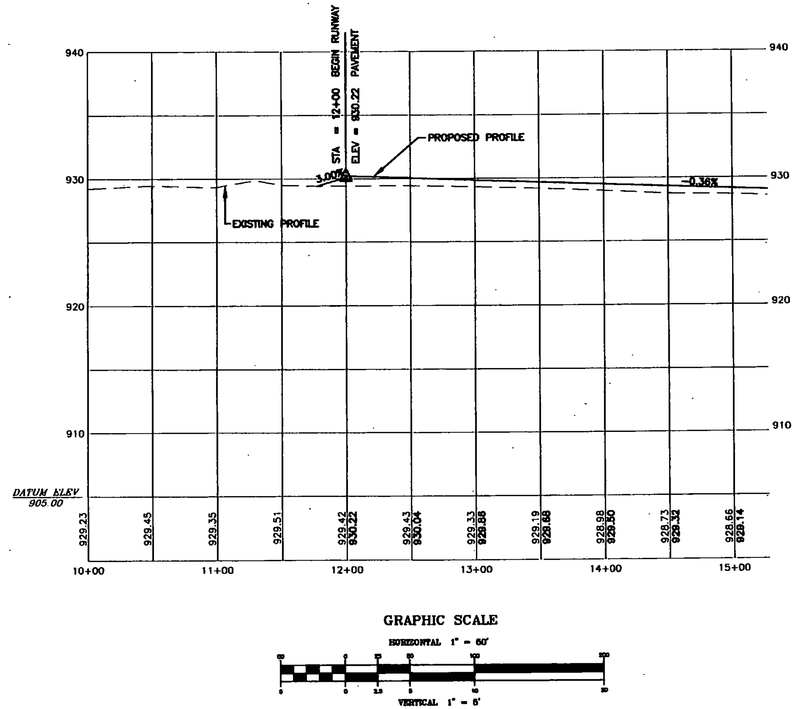

LEGEND

- LIMITS OF WORK
- EXISTING CONTOURS
- PROPOSED CONTOURS
- PROPOSED UNDERDRAIN
- EXISTING STORM DRAIN TO REMAIN
- PROPOSED STORM DRAIN
- EXISTING CATCH BASINS TO REMAIN
- PROPOSED CATCH BASINS
- FLUSHING BASIN

NO.	DATE	REVISIONS	BY	CK'D
1	1/18/01	VAOT COMMENTS AND SURVEY ADJUSTMENTS	MDL	SJR

DuBois & King INC.
engineering planning management development

VERMONT AGENCY OF TRANSPORTATION
COVENTRY, VERMONT
NEWPORT STATE AIRPORT
RUNWAY 18-36 RECONSTRUCTION
RUNWAY 18-36 PLAN & PROFILE
STA. 10+00 TO 15+25

DRAWN BY JJP	DATE MAR. 2000
CHECKED BY	PROJ. NO. N15500
PROJ. ENG. JAA	DRAW. NO. 1
SHEET RW-1	

I:\N15500F2\dwg\C15500F20003.dwg F-1 Feb 02 11:28:09 2001