INDEX OF SHEETS

STATE OF VERMONT
AGENCY OF TRANSPORTATION

PROPOSED IMPROVEMENT
CITY OF BURLINGTON AND
TOWN OF COLCHESTER
COUNTY OF CHITTENDEN

RECORD PLANS

CONTRACTOR: KUBRICKY CONST. CORP.

RESIDENT ENGINEER: JOE KNIPES

CONSTRUCTION BEGAN: FEBRUARY 12, 2003

CONSTRUCTION COMPLETE: JULY 07, 2004

RECORD PLANS BY: K. NORTH, N. GARBACIK

I HEREBY CERTIFY THAT ALL THE CONSTUCTION REQUIRED BY THIS SET OF DRAWINGS HAS BEEN ACCOMPLISHED AS INDICATED HEREIN.

BY _____ RESIDENT ENGINEER

DATE 12-19-04

NOTE: Any further information concerning final quantities, amounts or other details relative to this project may be found at Central Files in the electronic archives.

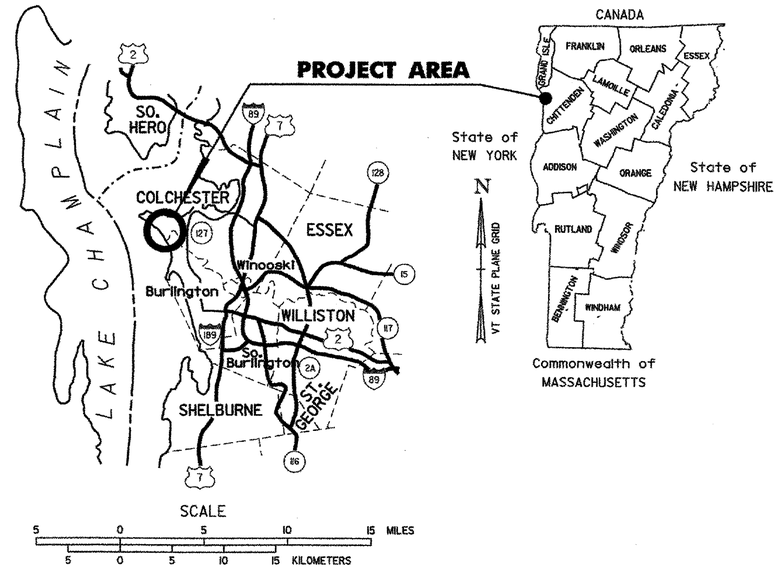

PROJECT LOCATION

Beginning in Burlington at a point on the existing Burlington Bike Path approximately 1550 feet northerly of the intersection of the bike path and North Avenue Extension, and extending northerly approximately ~~2662~~ 676 feet to the intersection of Windermere Way and Horizon View Drive in the Town of Colchester.

PROJECT DESCRIPTION

Work to be performed under this project includes the installation of a new bridge superstructure over the Winooski River and construction of a new shared-use path.

Length of bridge = 566.00 feet - 0.107 miles
~~Length of elevated path = 1691.27 feet - 0.320 miles~~
Length of path = ~~404.73~~ feet - ~~0.077~~ miles 109' - .021
Length of project = ~~2662.00~~ feet - ~~0.504~~ miles 676' - .128

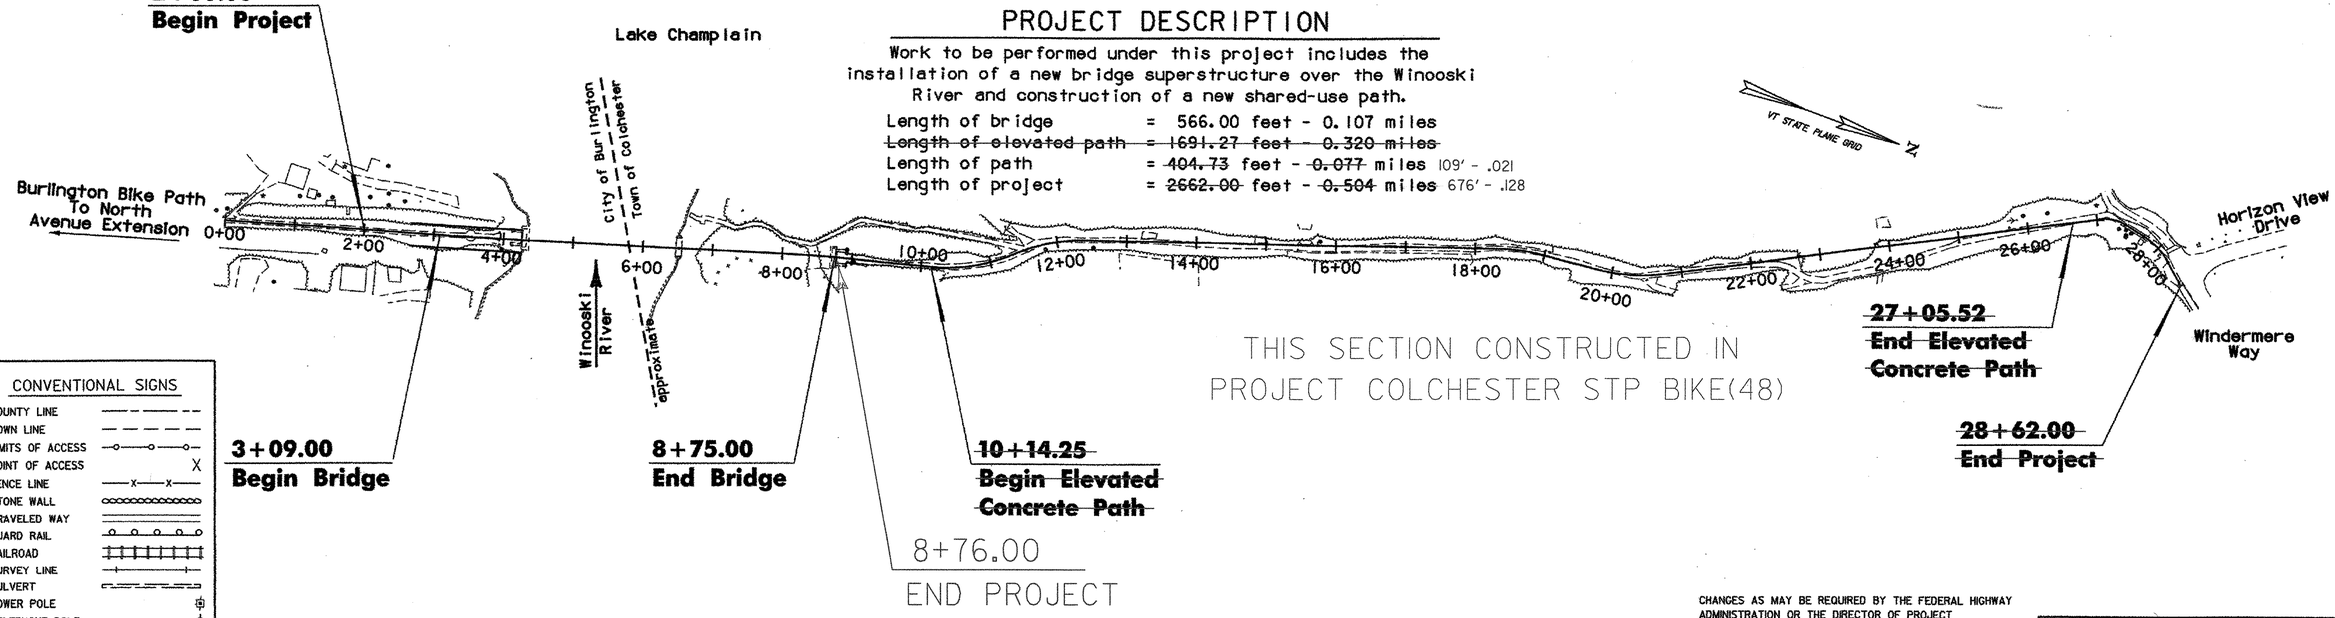

CONVENTIONAL SIGNS

COUNTY LINE
TOWN LINE
LIMITS OF ACCESS
POINT OF ACCESS
FENCE LINE
STONE WALL
TRAVELED WAY
GUARD RAIL
RAILROAD
SURVEY LINE
CULVERT
POWER POLE
TELEPHONE POLE
TREES
CONTROL OF ACCESS
PROPERTY LINE
R.O.W. TAKING LINE
SLOPE RIGHTS
TOP OF CUT
TOE OF SLOPE

DATUM
VERTICAL NAVD 88
HORIZONTAL NAD 83 (96)

0 100 200
SCALE IN FEET

CHANGES AS MAY BE REQUIRED BY THE FEDERAL HIGHWAY ADMINISTRATION OR THE DIRECTOR OF PROJECT DEVELOPMENT.

CONSTRUCTION IS TO BE CARRIED ON IN ACCORDANCE WITH THESE PLANS AND THE STANDARD SPECIFICATIONS FOR CONSTRUCTION DATED 2001, AS APPROVED BY THE FEDERAL HIGHWAY ADMINISTRATION ON JANUARY 4, 2001 FOR USE ON THIS PROJECT, INCLUDING ALL SUBSEQUENT REVISIONS AND SUCH REVISED SPECIFICATIONS AND SPECIAL PROVISIONS AS ARE INCORPORATED IN THESE PLANS.

DIRECTOR OF PROJECT DEVELOPMENT
APPROVED _____ DATE 11/6/02

PROJECT MANAGER :

PROJECT NAME : **Burlington - Colchester**
PROJECT NUMBER : **STP Bike (45)**

SHEET 1 OF 87 SHEETS