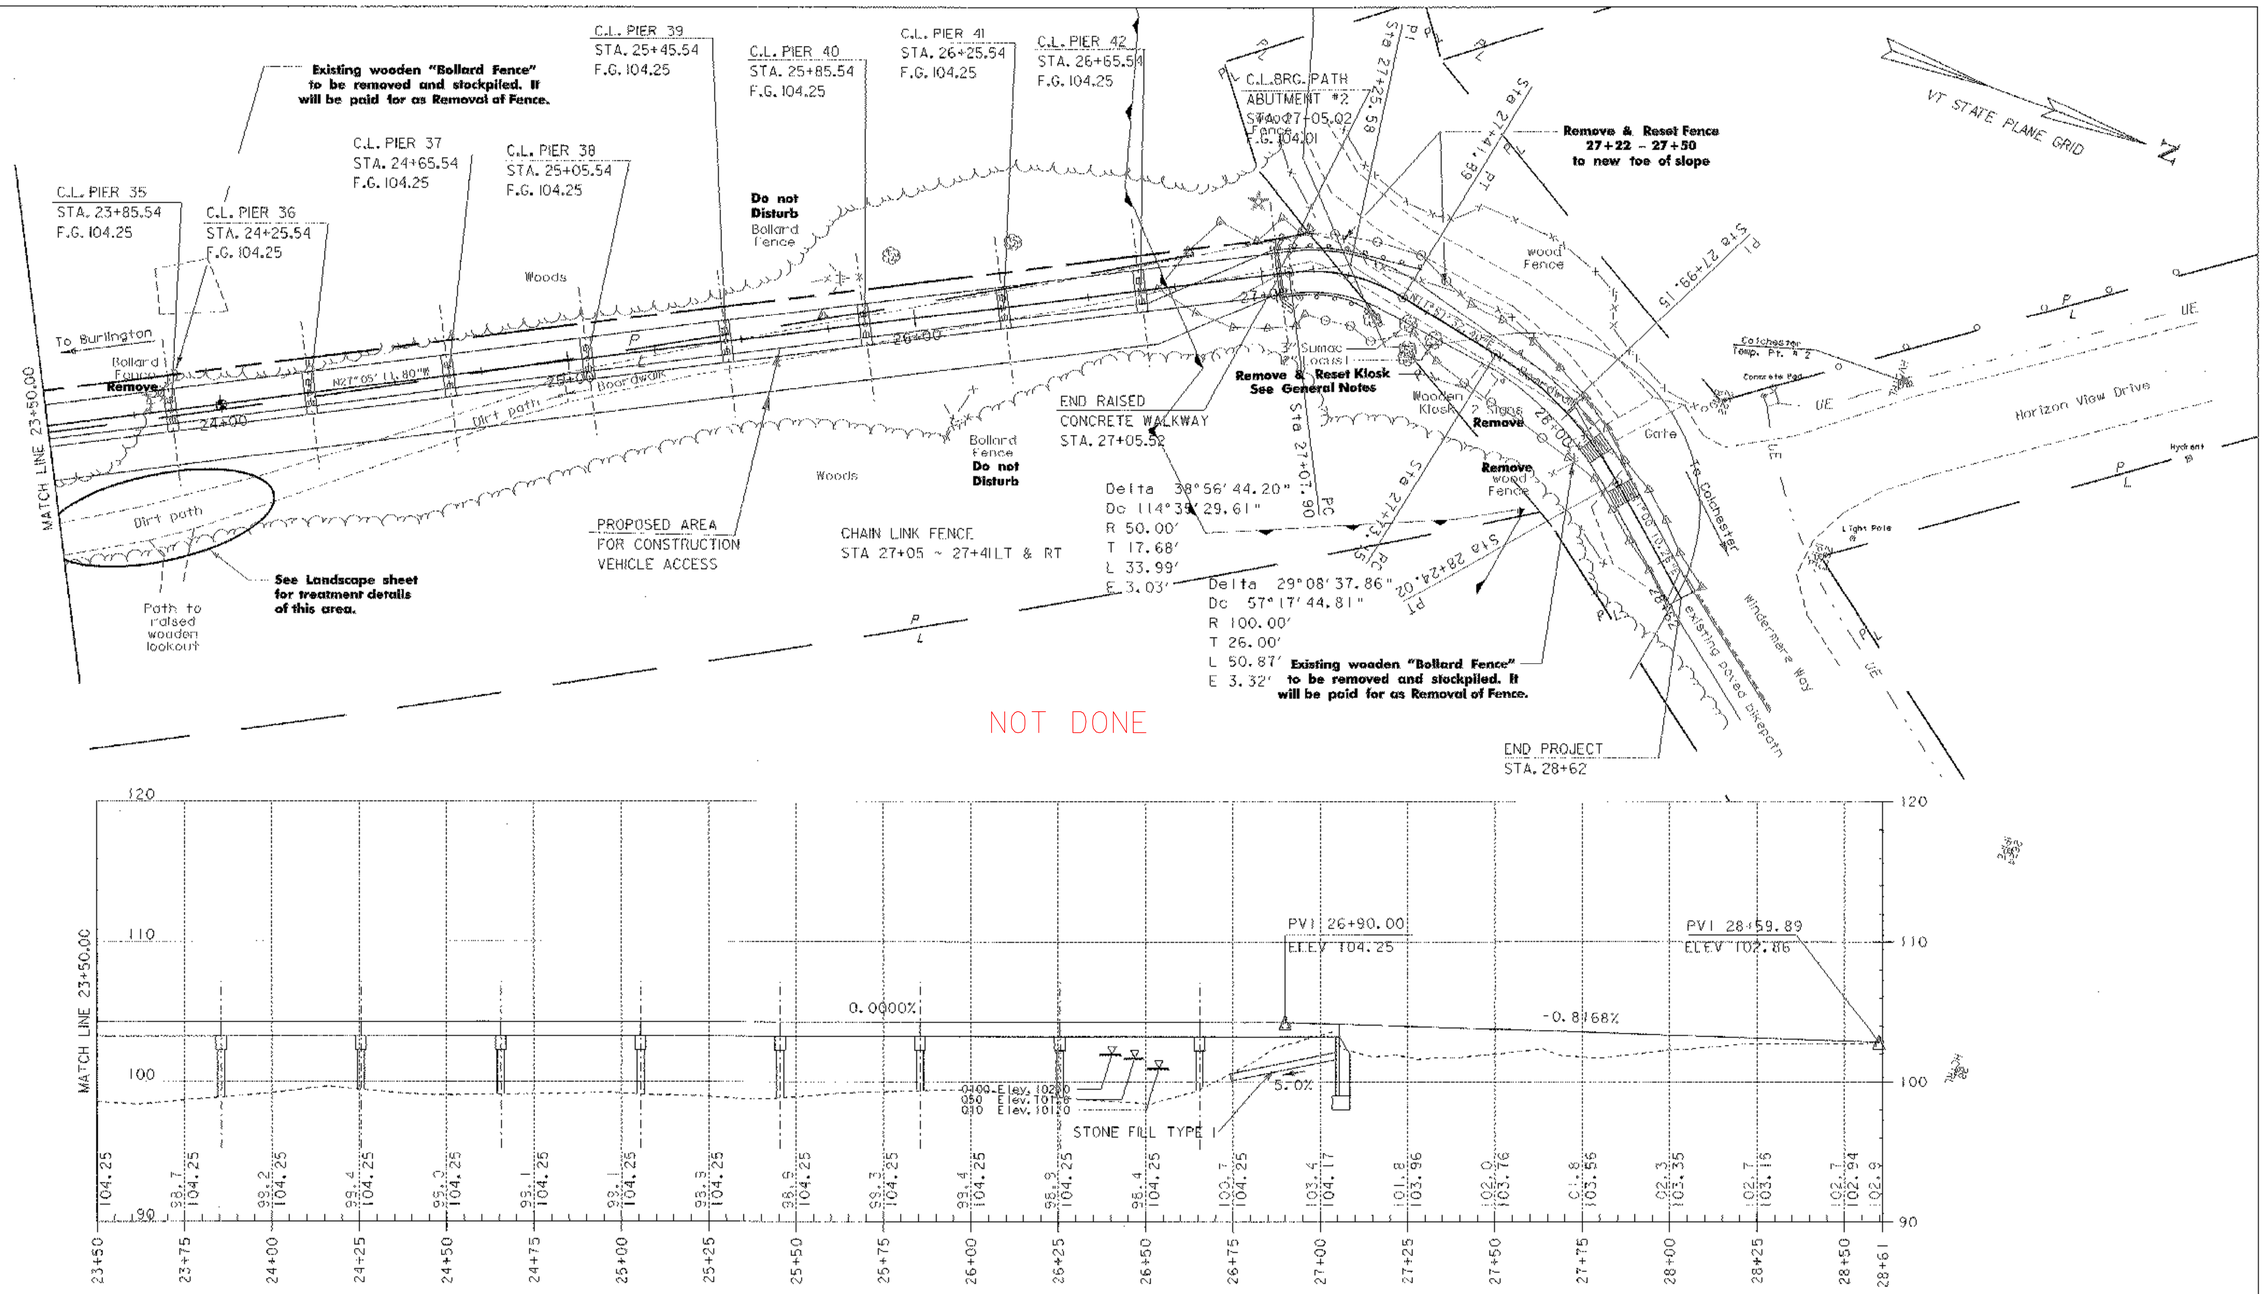

0 20 40
SCALE IN FEET

PROJECT NAME:	Burlington - Colchester
PROJECT NUMBER:	STP Bike(45)
FILE NAME: \str5\01f132\sf132bdr.dgn	PLOT DATE: 15-NOV-2002
PROJECT LEADER: C. Keller	DRAWN BY: G. Shangraw
DESIGNED BY: M. Evans-Mongeon	CHECKED BY:
Layout and Profile Sheet 5	SHEET 25 OF 87