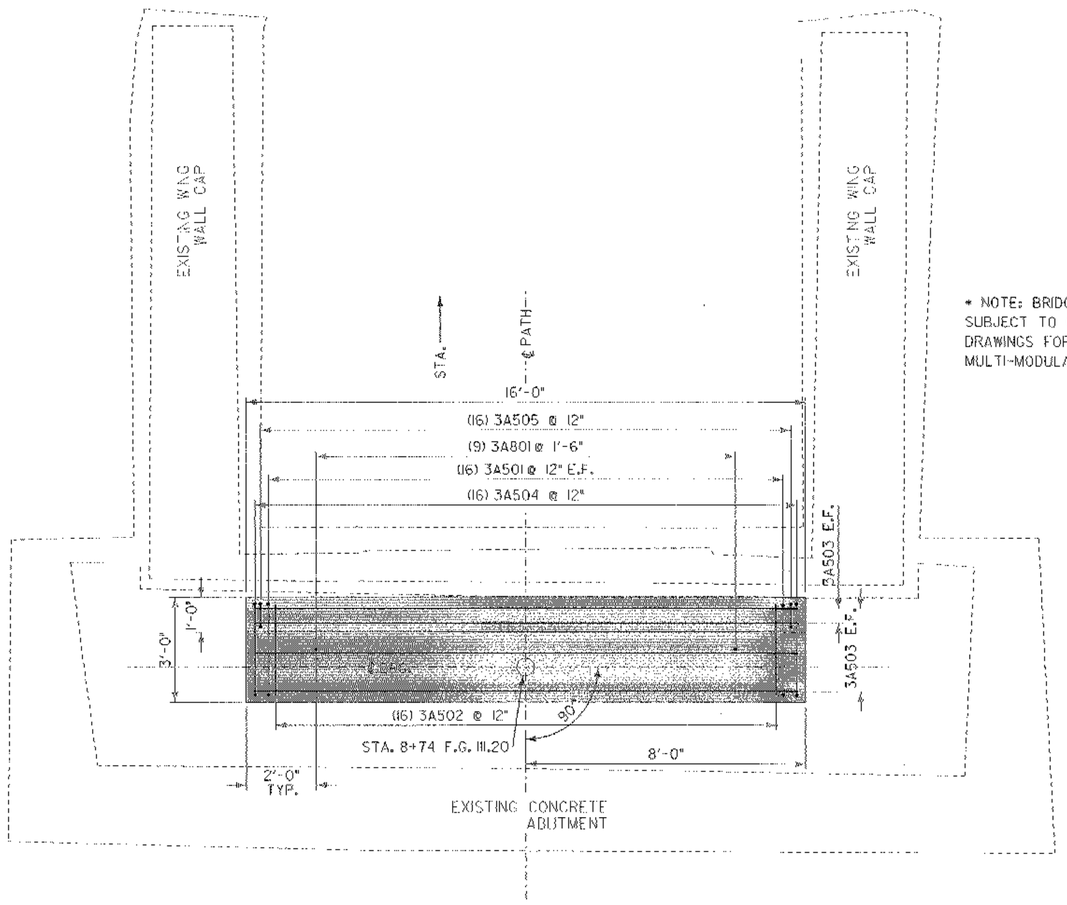

PLAN VIEW

SCALE ½" = 1'-0

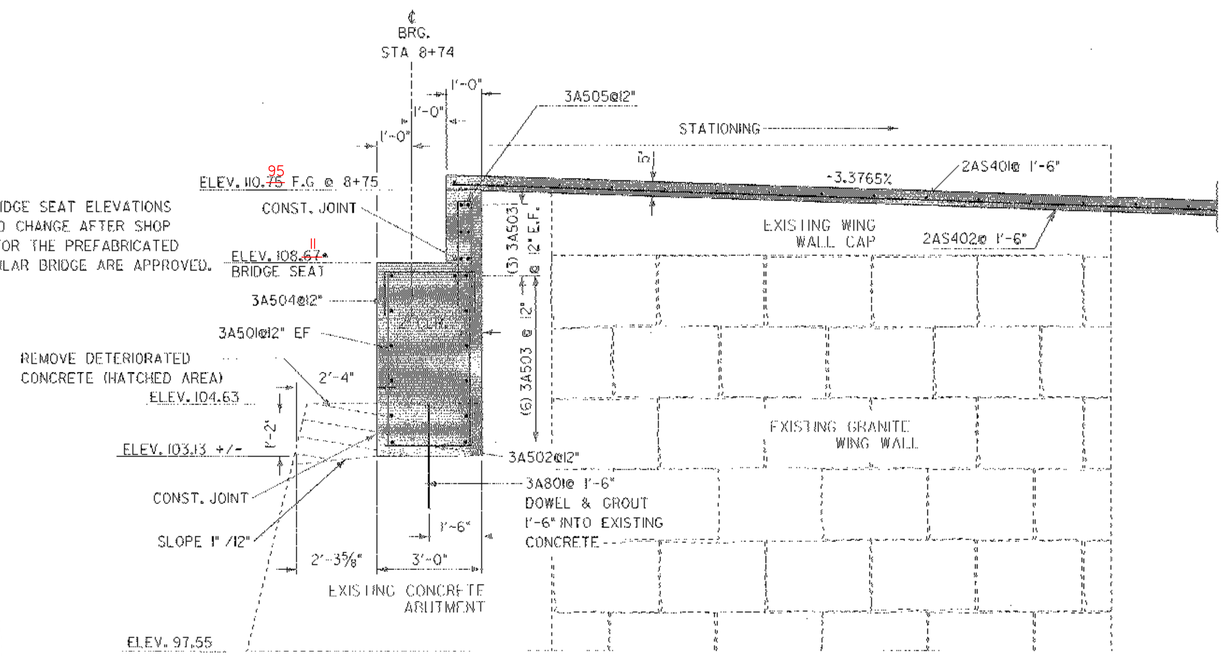

SIDE VIEW

SCALE ½" = 1'-0

* NOTE: BRIDGE SEAT ELEVATIONS SUBJECT TO CHANGE AFTER SHOP DRAWINGS FOR THE PREFABRICATED MULTI-MODULAR BRIDGE ARE APPROVED.

NOTE:

NF = NEAR FACE
FF = FAR FACE
EF = EACH FACE
▲ = CUT TO FIT IN FIELD
3" CLR. UNLESS OTHERWISE SPECIFIED ON THE PLANS.

STATE OF VERMONT AGENCY OF TRANSPORTATION	
Town Of BURLINGTON-COLCH.	Bridge No. 8 - 75
Highway No. BIKE PATH	Log Sta. Surv. Sta.
ABUTMENT 3 (STA.8+75)	
DETAILS	
Designed By M.EVANS MONGEON	Drawn By J.GEORGE
Checked By Date	Bridge Design Supervisor C.S.KELLER Date
PROJECT BURLINGTON-COLCH.	PROJECT NO. STP BIKE (45)
\\G.C.\mdm_cadd\flingcabinet\01f132\structure\sf132bbir.dgn	sf132ab31
Bridge Sheet No.	Sheet 63 of 87