12+00

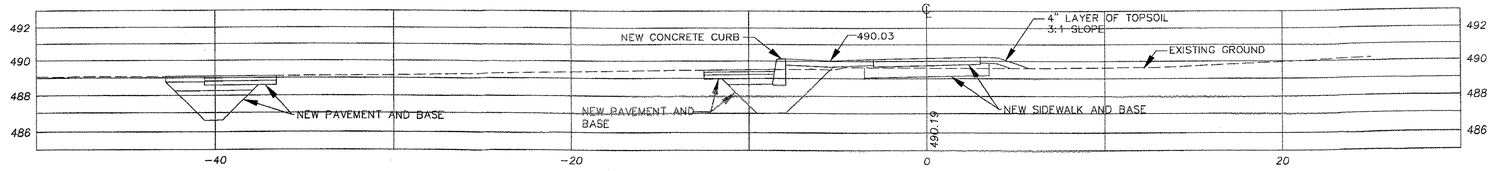

11+71

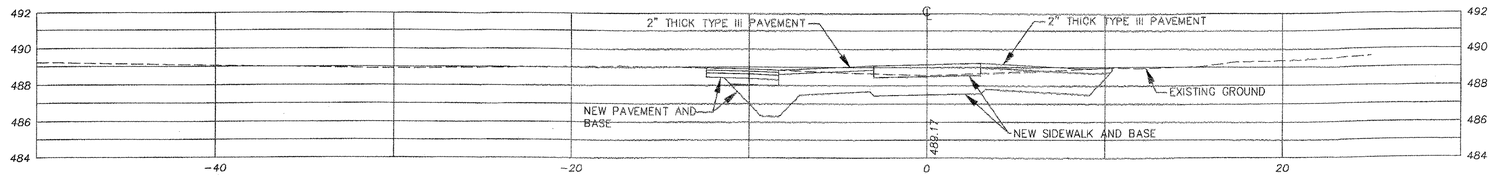

11+50

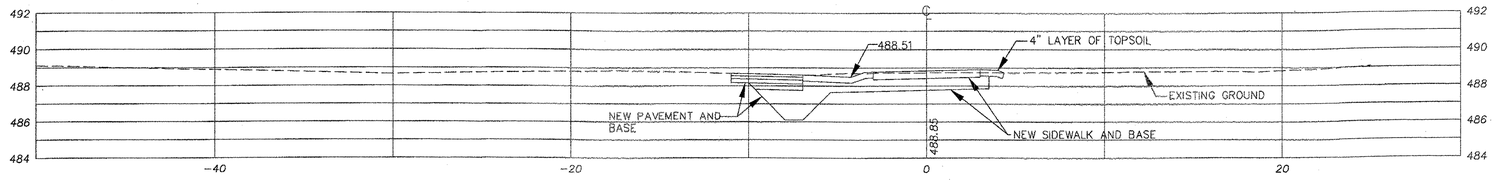

11+00

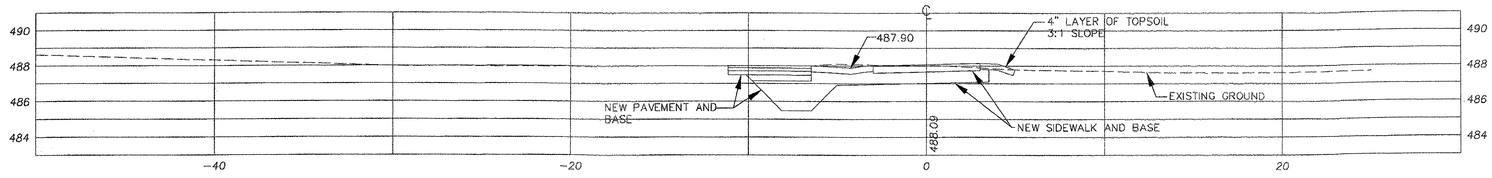

10+50

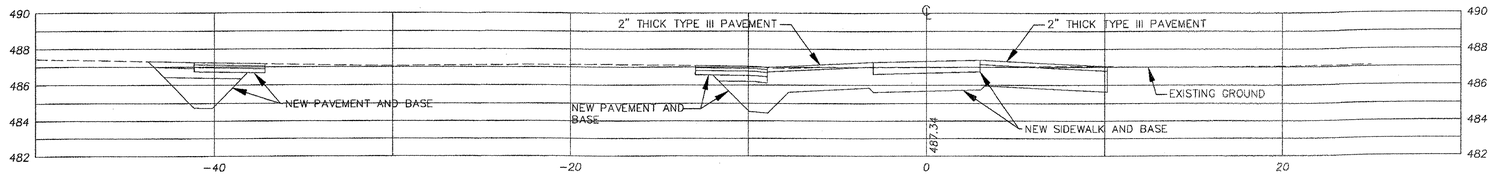

10+00

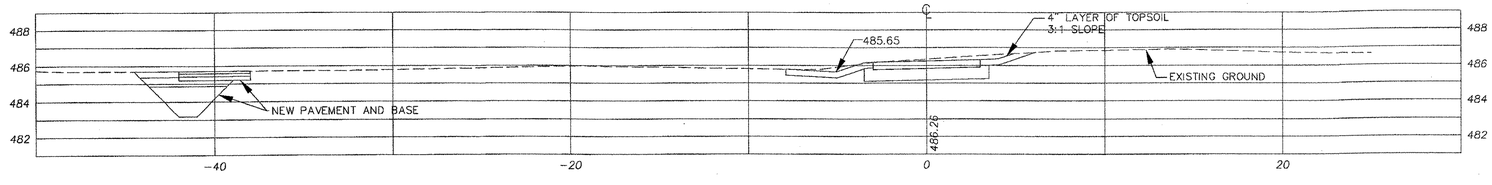

9+88

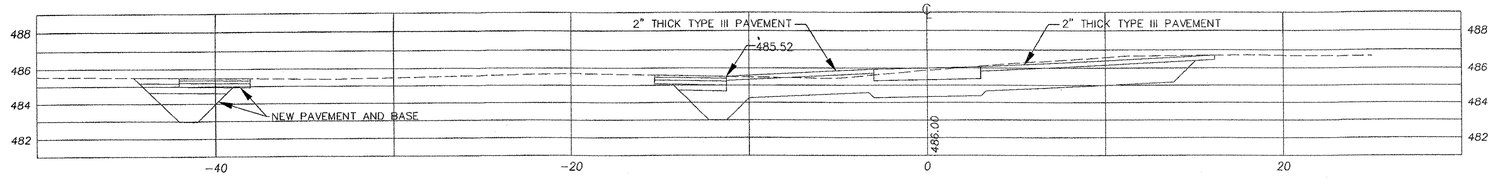

GRAPHIC SCALE

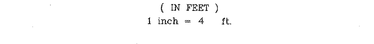

(IN FEET)
1 inch = 4 ft.

HORIZONTAL SCALE: 1"=4'
VERTICAL SCALE: 1"=4'

10-20-05	REVISED FOR CONTRACT PLANS	BH/DH
	REVISIONS	
	THESE PLANS WITH LATEST REVISIONS SHOULD ONLY BE USED FOR THE PURPOSE SHOWN BELOW:	# OF SHEETS
	STP WALK (9) TOWN OF ESSEX ROUTE 15 IN ESSEX CENTER, VT	proj. no. 02-132
		survey L&D/OTHERS
		design DLH/LAL
	CROSS SECTIONS STATION 9+88 TO 12+00	drawn DB
		checked LAL/DLH
		date 01-24-03
		scale 1" = 4'
	LAMOUREUX & DICKINSON Consulting Engineers, Inc. 14 Morse Drive Essex Junction, VT 05452 (802) 878-4450	sht. no. 15