RAILNG SYSTEM:

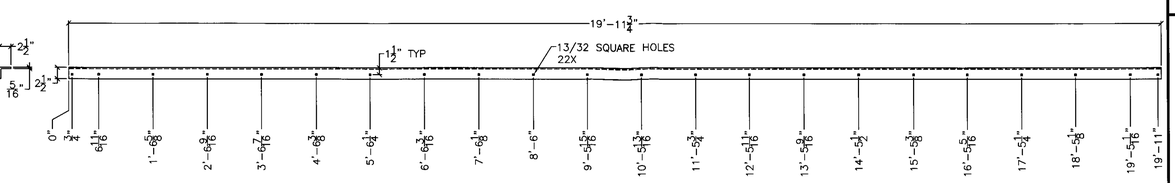

HR06, HR07: –ANGLE

1–1/2" = 1'–0" QTY. 24

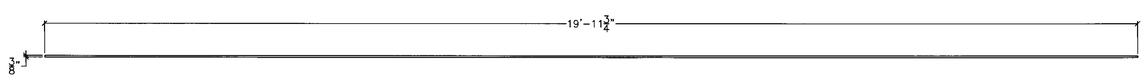

HR10: –3/8 ROUND STOCK

1–1/2" = 1'–0" QTY. 36

RECEIVED
CK'D BY_____ OK'D BY_____
JUL 3 1 2..
R... APPRO...
BY WYB. SD DATE 8/6/09

Remaud Bros. Construction
Hartford, Vermont 05004
(802) 257-7383

TITLE Wallingford Bridge Rehab
LOCATION Wallingford, VT
DRAWING TITLE Drawings Railing System Drawings
DRAWN BY JED JOB CONTACT Erick Foster State of VT
CHECKED BY JED/AD DATE 4 30 09
DRAWING NO. R–1
SHEET NO 6 OF 10