BOTTOM CHORD:

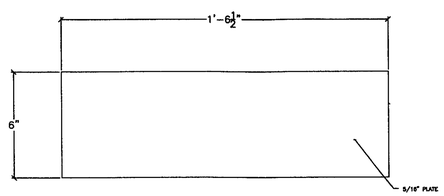

2BC01-PLATE

3" = 1'-0"

RECEIVED
CK'D BY Clm OK'D BY
MAY 11 2009
RESUBMIT APPROVED As Noted
BY WY DATE 5/19/09

Renaud Bros. Construction
Fall Bridges Road Vernon, VT 05354
((802) 257-7263

TITLE Wallingford Bridge Rehab
LOCATION Wallingford, VT
DRAWING TITLE Drawings Truss Type 2- Drawings
DRAWN BY JED JOB CONTACT Erick Foster State of VT
CHECKED BY JED/AD DATE 4 30 09

DRAWING NO. T-2