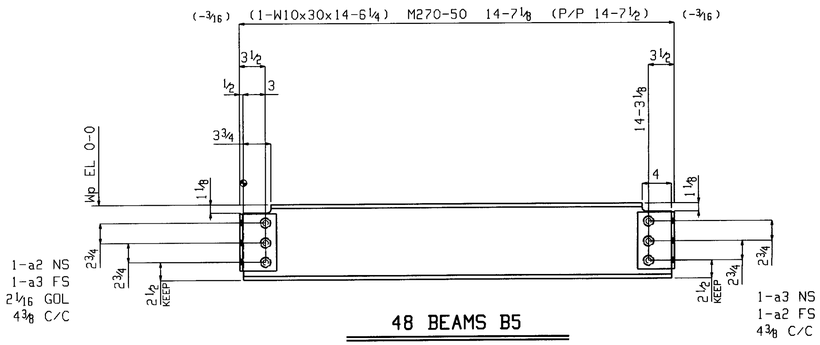

48 BEAMS B5

W	10 1/2 x 3/16
F	5 13/16 x 1/2
K	1 1/8 x 3/4

SHOP BOLTS
6-3/4 x 2 1/4 M164-I GALV

☒ NO EXCEPTION TAKEN ☐ MAKE CORRECTIONS NOTED
☐ REJECTED ☐ RESUBMIT RESUBMIT
☐ SUBMIT REVISED ITEM

DATE 6/17/09 BY

RECEIVED
CK'D BY_____ CK'D BY_____
MAY 2 6 2009
RESUBMIT_____ APPROVED_____
BY DATE

BILL OF MATERIAL

Qty Tot.	Piece Mark	Description	Length		Seq NO.	Seq Qty	Adv ABM #	Steel Grade	Remarks
48		BEAM			1	48			
48	B5	W10x30	14	6 1/4				M270-50	
96	a2	L5x3 1/2x3/8	0	8				M270-50	
96	a3	L5x3 1/2x3/8	0	8				M270-50	
288		3/4 Dia M164-I	0	2 1/4					IHD WASH,GALV

BILL OF MATERIAL

Qty Tot.	Piece Mark	Description	Length		Seq NO.	Seq Qty	Adv ABM #	Steel Grade	Remarks

BILL OF MATERIAL

Qty Tot.	Piece Mark	Description	Length		Seq NO.	Seq Qty	Adv ABM #	Steel Grade	Remarks

Total weight 22008

Renaud Bros. Inc.
283 Fort Bridgeman Rd. #2
Vernon, VT. 05354
Phone 1-802 257-7383

Holes:	13/16 UNO
BOLTS:	3/4" DIA M164-I GALV
Steel GR:	M270-50 UND
Paint:	PER SPECS
Surface Prep:	PER SPECS

Rev.No: Date:

Project:
WALLINGFORD BRIDGE
WALLINGFORD, VT

Date: 4-28-09 Job No.
DWN. BY: EG Checked: Sheet No. B5

May 15 2008 03:03:49 PM