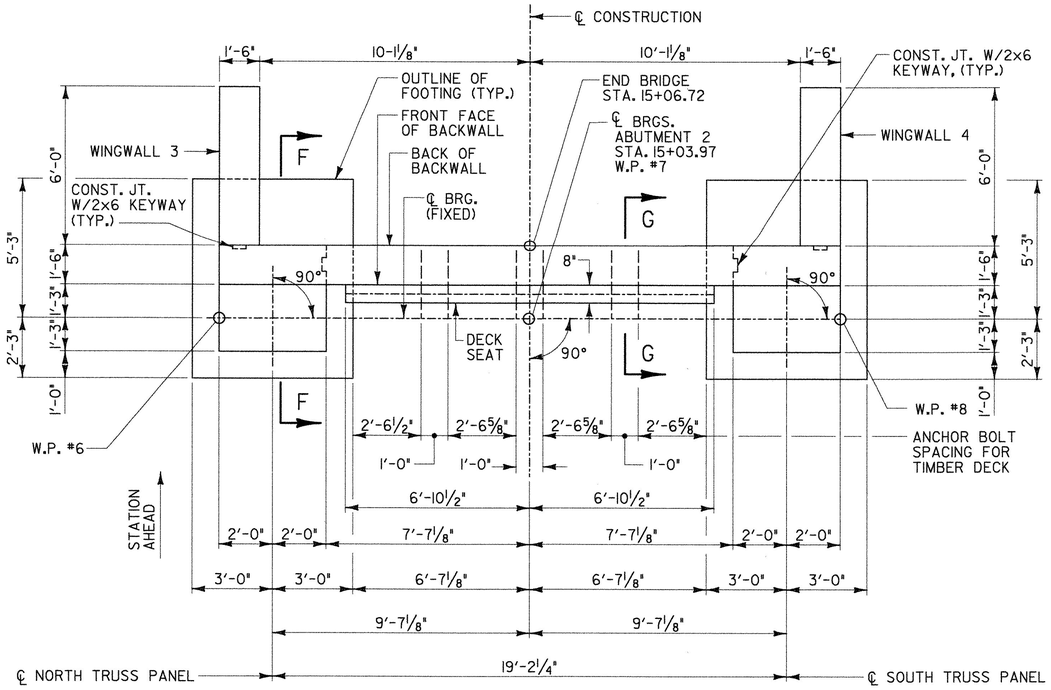

PLAN

ABUTMENT 2

SCALE 3/8" = 1'-0"

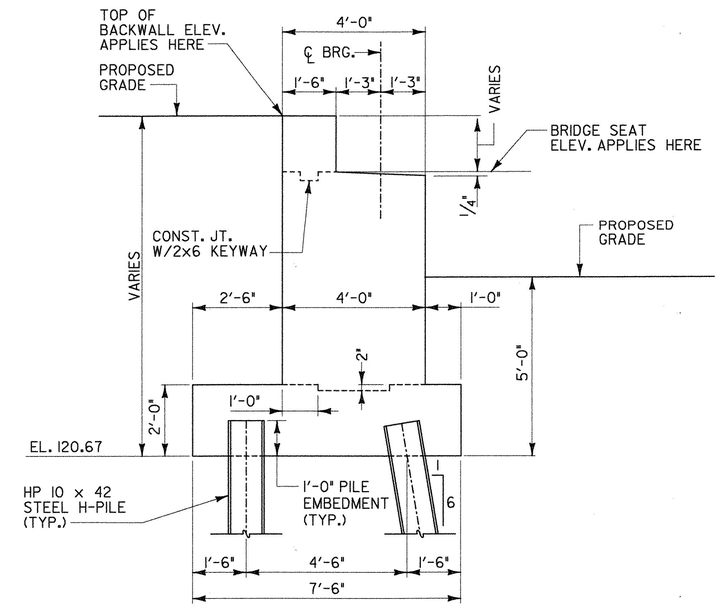

SECTION F-F

ABUTMENT 2

SCALE 1/2"=1'-0"

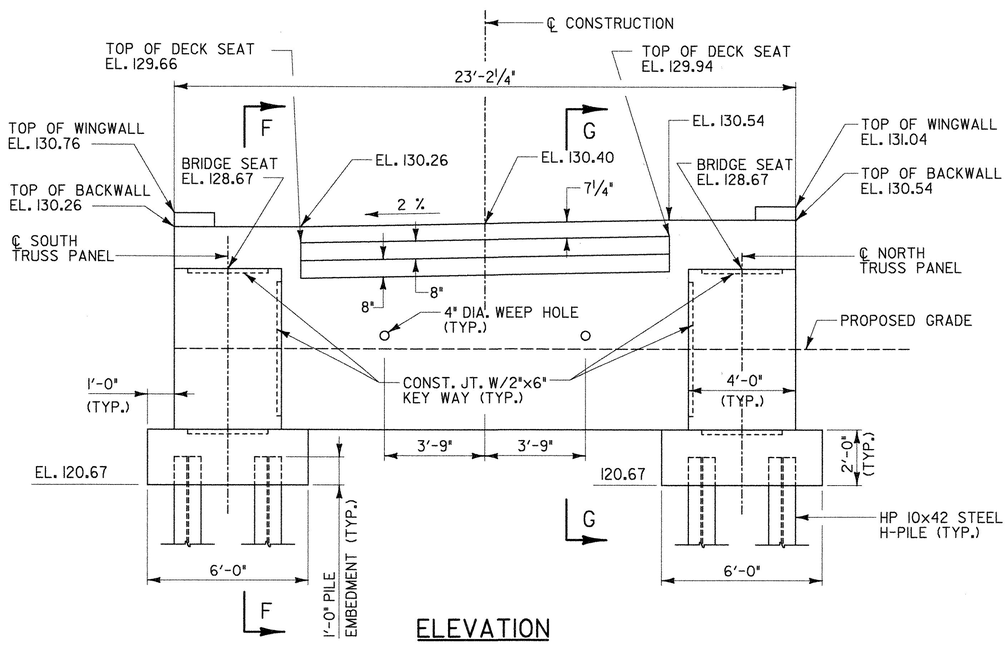

ELEVATION

ABUTMENT 2

SCALE 3/8" = 1'-0"

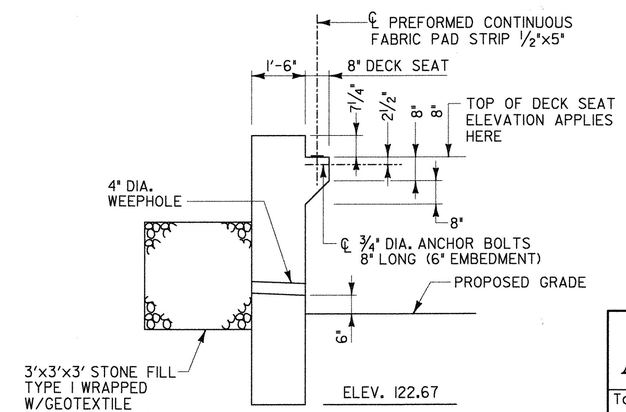

SECTION G-G

ABUTMENT 2

SCALE: 1/2"=1'-0"

NOTE:

1. PREFORMED FABRIC PAD WILL BE PAID FOR UNDER CONTRACT ITEM 522.40 "STRUCTURAL GLUED LAMINATED TIMBER".

STATE OF VERMONT
AGENCY OF TRANSPORTATION

Town Of SWANTON	Bridge No. 18
Highway No.	Log Sta. _____
	Surv. Sta. _____
RAIL TRAIL OVER MISSISQUOI RIVER	
ABUTMENT 2 - PLAN, ELEVATION AND SECTIONS	
Designed By R. SACCHI	Drawn By R. ROSS
Checked By H. BUI Date 1/23/08	Bridge Design Supervisor R. SACCHI Date 1/23/08
PROJECT SWANTON	PROJECT NO. STP ST MHTB(I)
I.G.C. Info. ZD024ABUT2-I.dgn	1/30/2008
Bridge Sheet No. BR3	Sheet 51 of 63

URS URS CORPORATION