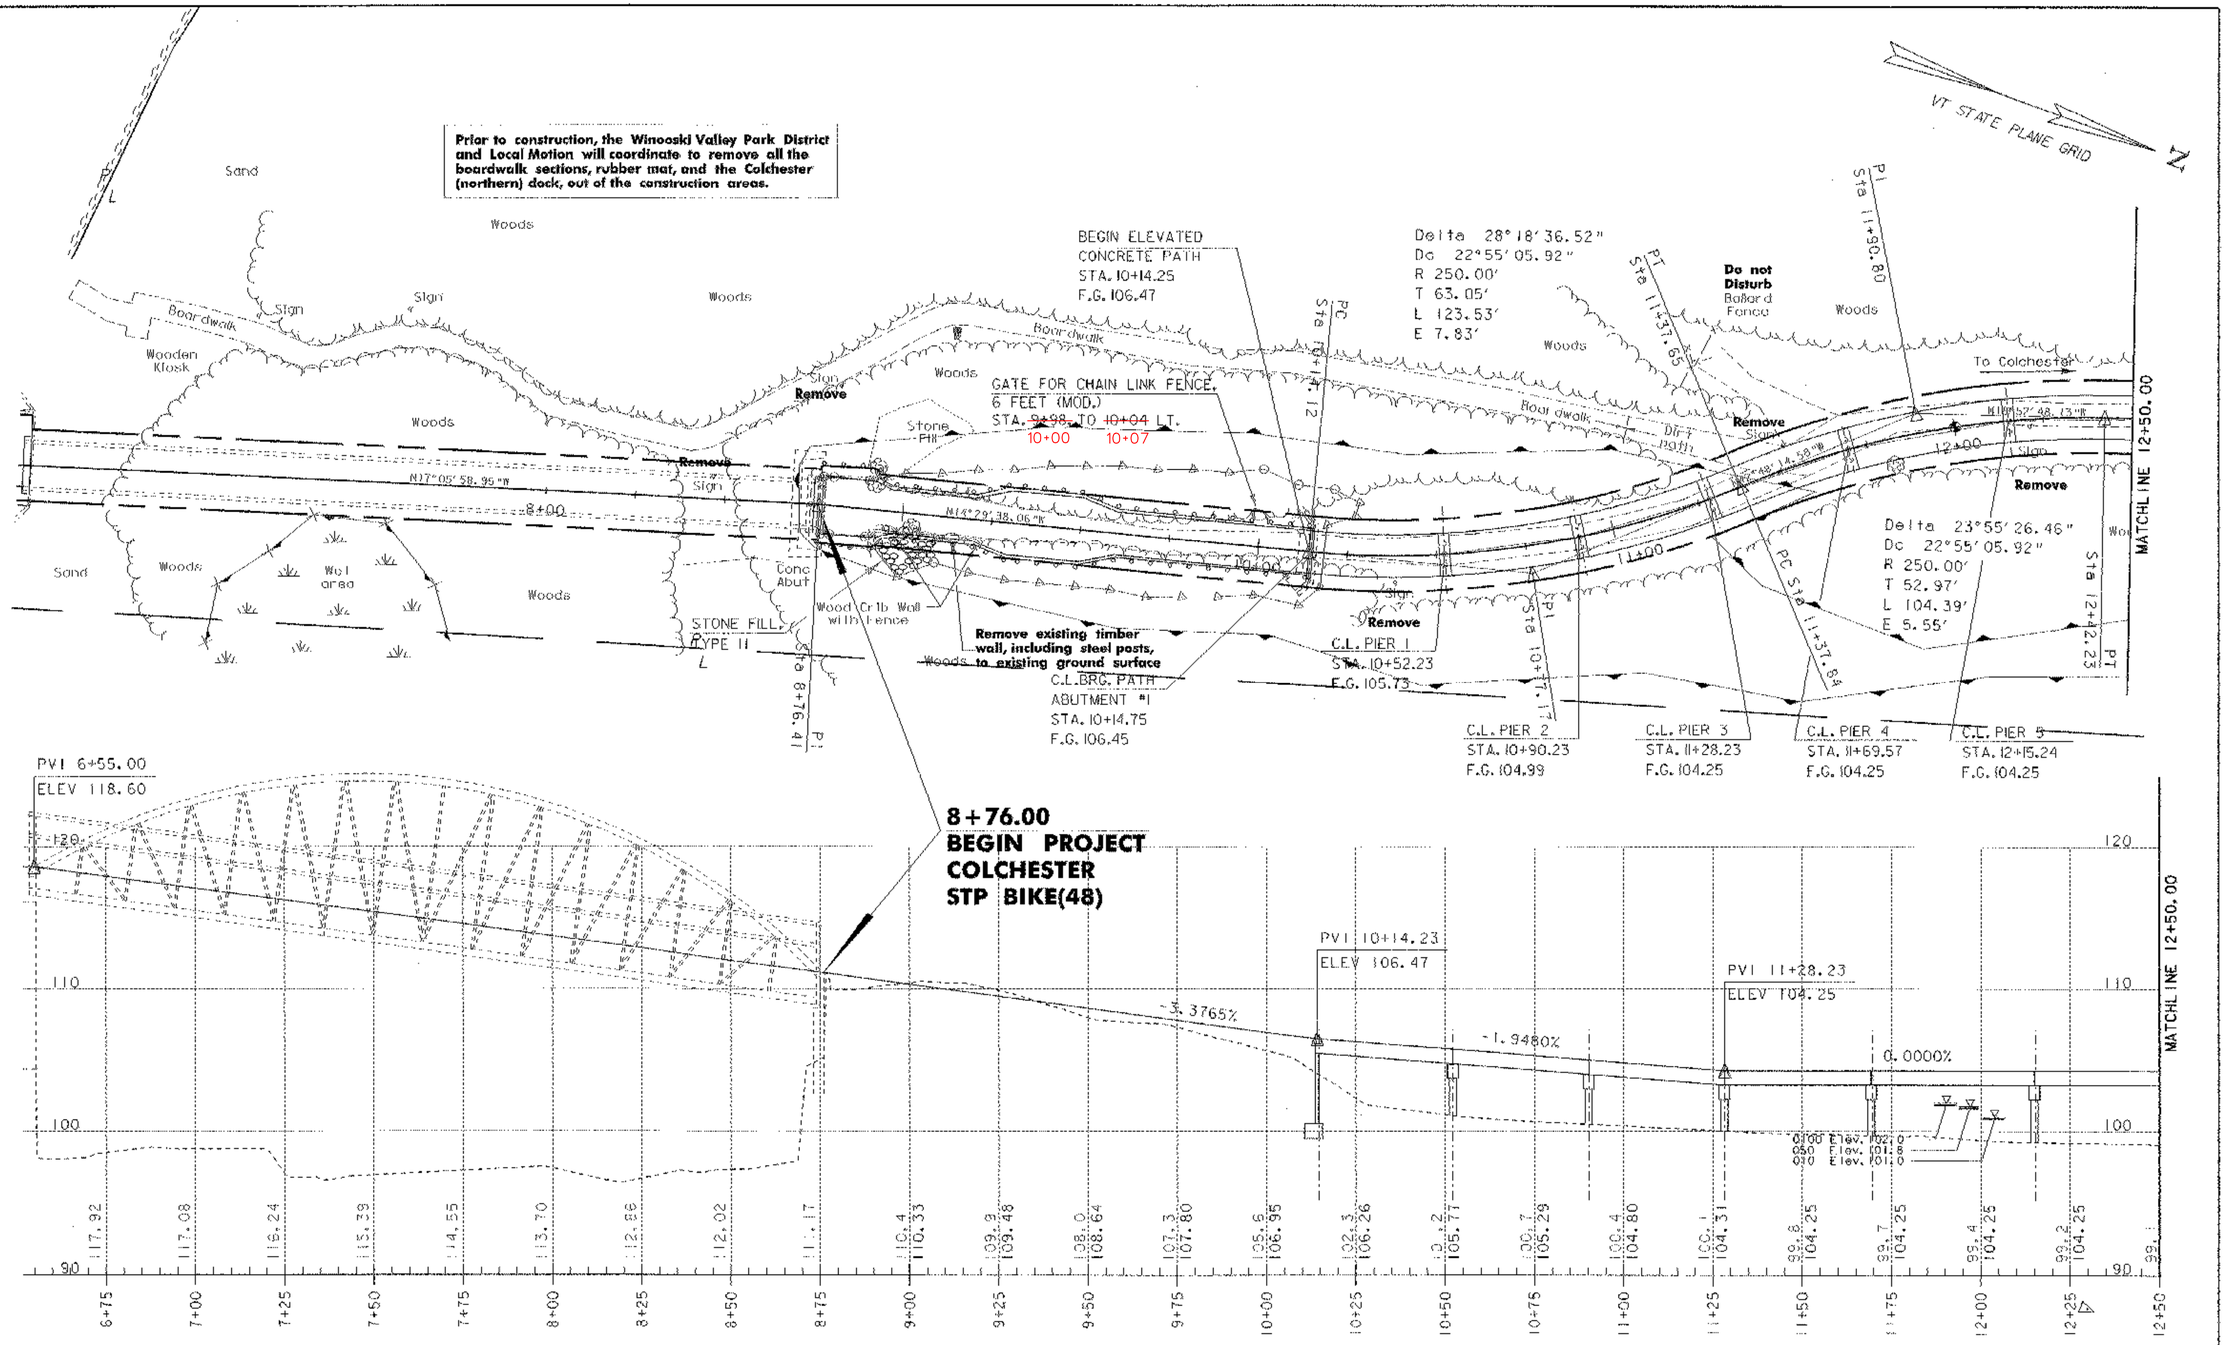

PROJECT NAME:	Colchester
PROJECT NUMBER:	STP Bike(48)

FILE NAME: /str5/03f038/sf038bdr.dgn
PLOT DATE: 06-AUG-2003
PROJECT LEADER: C. Keller
DRAWN BY: C. Shangraw
DESIGNED BY: M. Evans-Mongeon
CHECKED BY:
sf038LJ
SHEET 22 OF 87