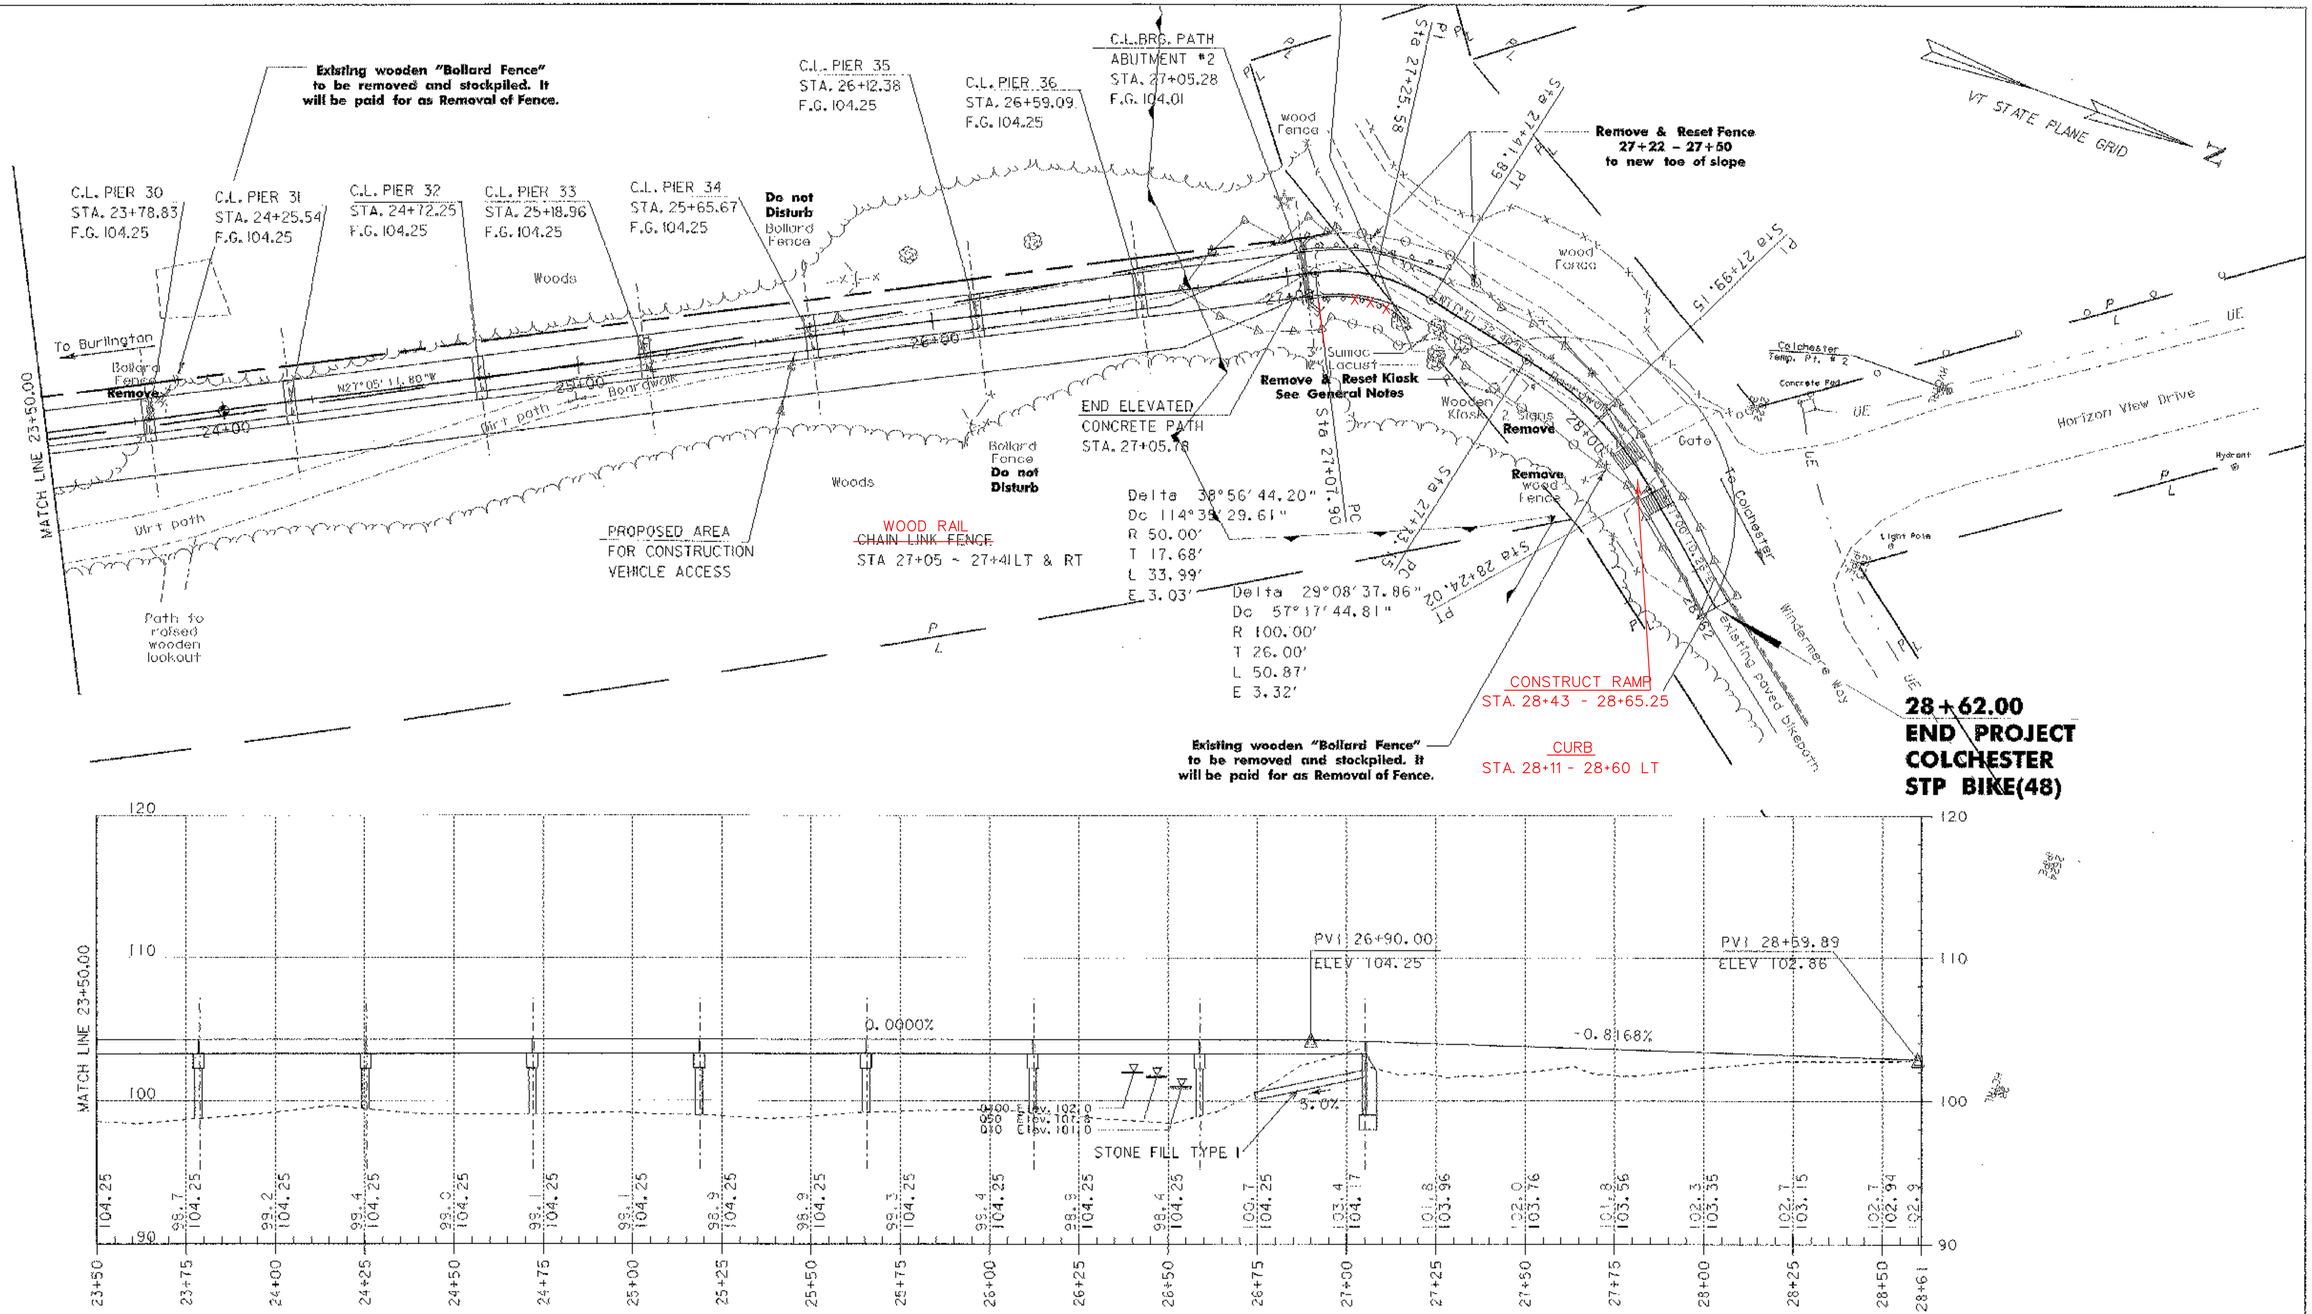

PROJECT NAME:	Colchester
PROJECT NUMBER:	STP Bike(48)

0 20 40
SCALE IN FEET

FILE NAME: /str5/03f038/sf038bdr.dgn PLOT DATE: 05-AUG-2003
PROJECT LEADER: C. Keller DRAWN BY: G. Shangraw
DESIGNED BY: M. Evans-Mongeon CHECKED BY:
sf038L4.i SHEET 25 OF 87