Keuffel & Esser Company PLATE 3 CROSS SECTION PAPER Made in U.S.A.

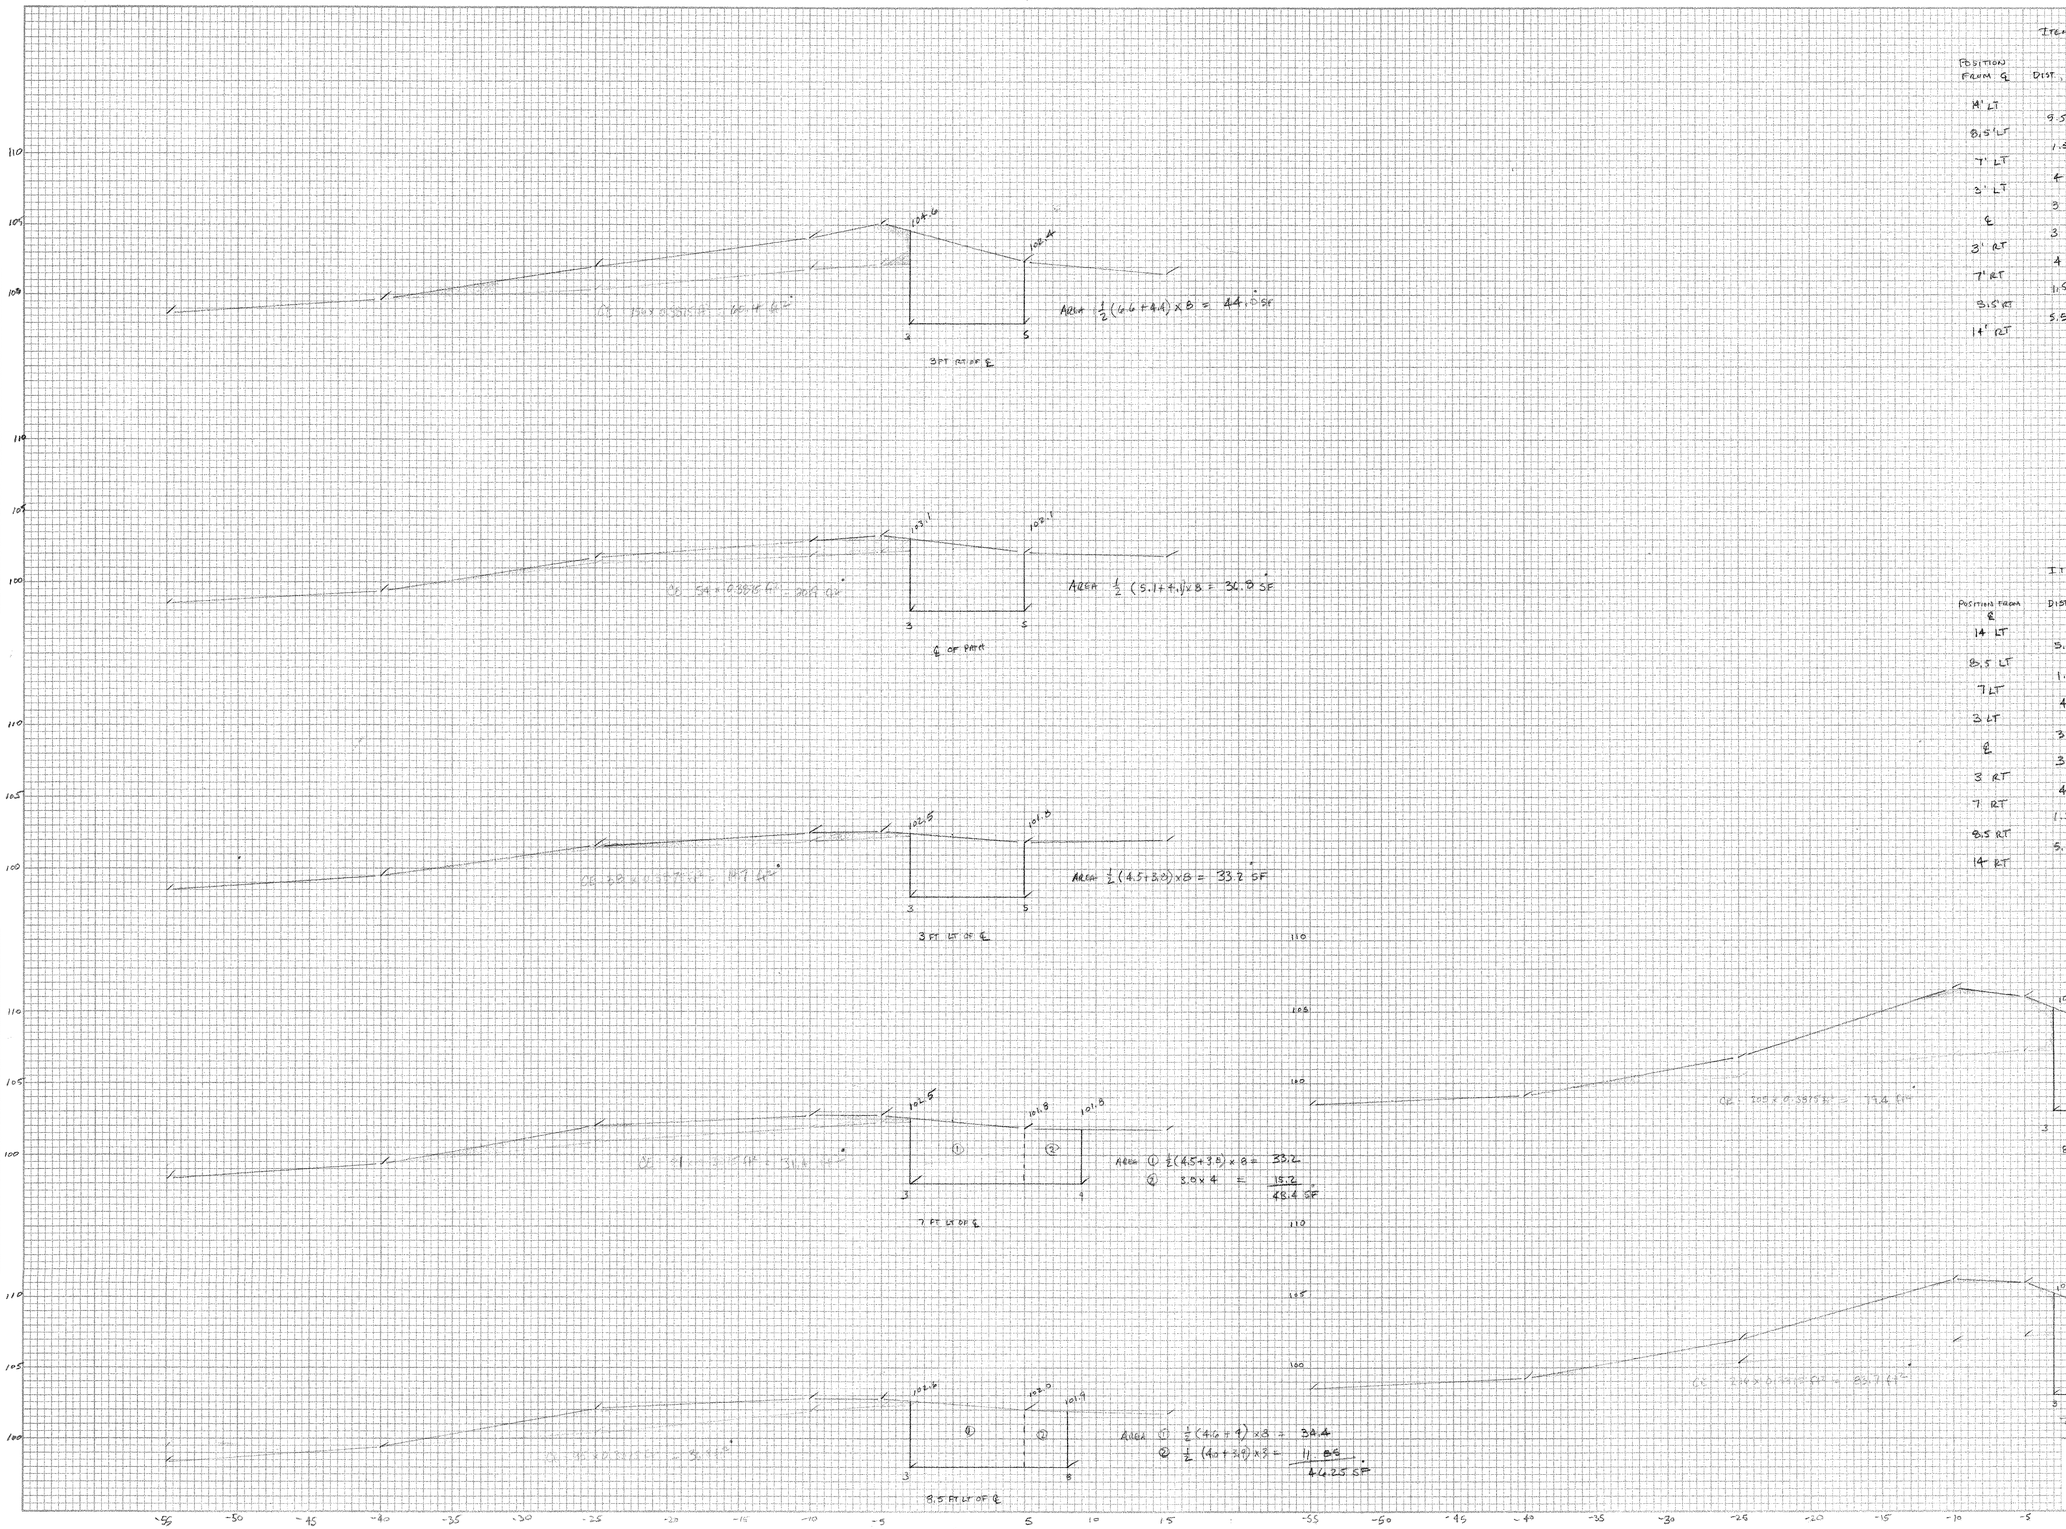

ITEM 203.15 COMMON EXCAVATION

POSITION FROM ℄	DIST, FT	AREA, SF	AVERAGE AREA, SF	VOLUME CF
14' LT		0		
	9.5		18.4	101.2
8.5' LT		36.8		
	1.5		34.1	51.2
7' LT		31.4		
	4		23.0	92.2
3' LT		14.7		
	3		17.8	53.4
℄		20.9		
	3		40.6	122.0
3' RT		60.4		
	4		72.0	288.2
7' RT		83.7		
	1.5		81.6	122.3
8.5' RT		79.4		
	5.5		39.7	218.4
14' RT		0		
			1,048.9	1,048.9 CF

÷27 = 38.8 CY

4-19-04 SEN

✓ 5-25-04 SEN

ITEM 204.25 STRUCTURE EXCAVATION

POSITION FROM ℄	DIST, FT	AREA, SF	AVERAGE AREA, SF	VOLUME, CF
14 LT		0		
	5.5		23.1	127.0
8.5 LT		46.25		
	1.5		47.3	71.0
7 LT		48.4		
	4		40.8	163.2
3 LT		33.2		
	3		35.0	105.0
℄		36.8		
	3		40.4	121.2
3 RT		44.0		
	4		52.8	211.2
7 RT		61.6		
	1.5		59.2	88.8
8.5 RT		56.9		
	5.5		28.4	156.2
14 RT		0		
			1,044.0 CF	

÷27 = 38.7 CY

4-19-04

✓ 5-25-04 SEN

COLCHESTER STP DIER (48)
STRUCTURE SECTIONS
PATH ABUTMENT No 2

SHT 2 of 2

118

1" = 5'

DATE	BY	REVISED	REVISED	REVISED	REVISED	REVISED	REVISED	REVISED	REVISED

JANKO VENTURES LLC
SITE BOOK
PAGE