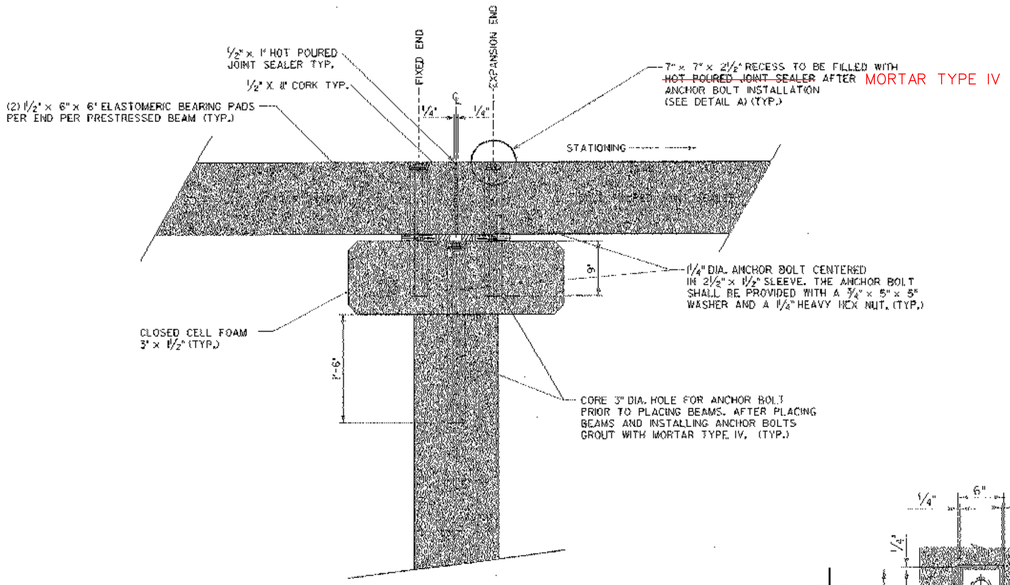

CONNECTION DETAIL
@ PILE (TYP.)
SCALE 1" = 1'-0

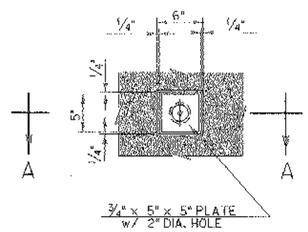

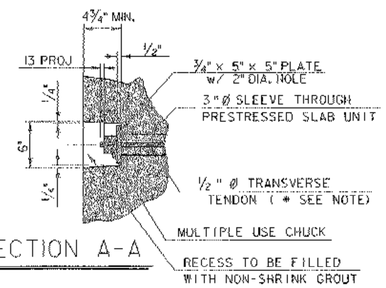

SECTION A-A

1/2" Ø TRANSVERSE TENDON DETAIL

NTS

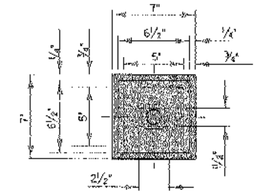

SECTION A-A

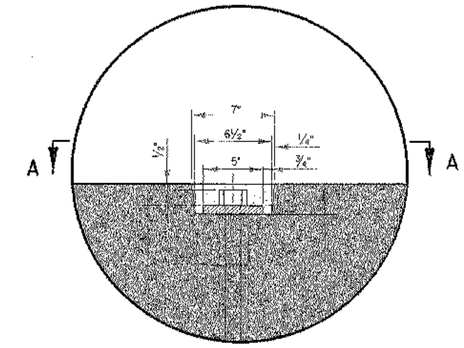

DETAIL "A"

SCALE 1/2" = 1'-0

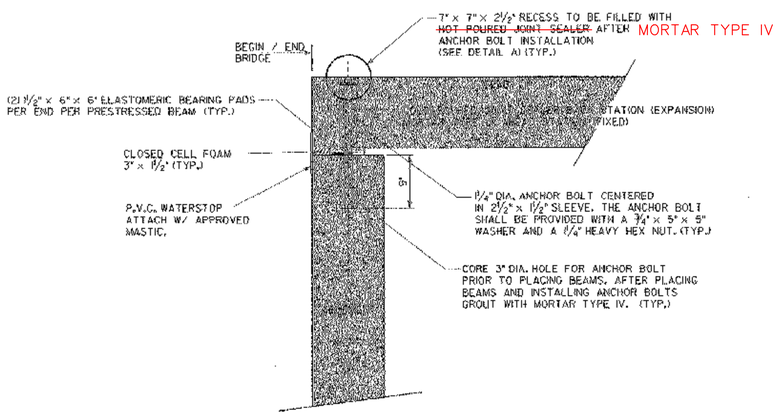

CONNECTION DETAIL
@ ABUTMENT (TYP.)
SCALE 1" = 1'-0

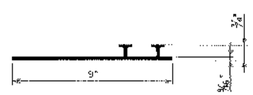

P.V.C. WATERSTOP

THE COSTS FOR P.V.C. WATERSTOP SHALL BE INCLUDED IN THE UNIT BID PRICE FOR CONCRETE. OTHER CONFIGURATIONS MAY BE USED UPON APPROVAL OF THE STRUCTURES ENGINEER.

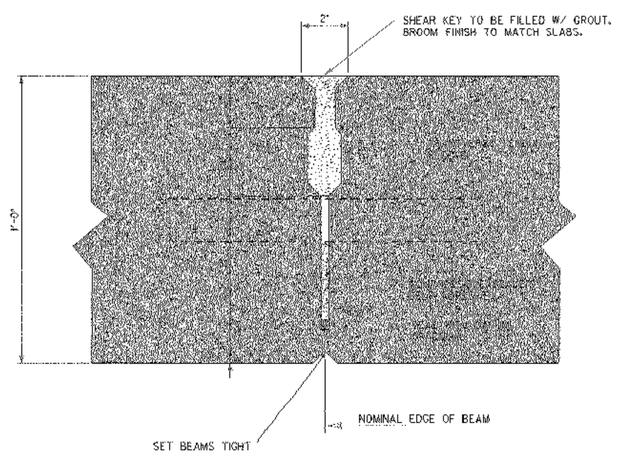

SHEAR KEY DETAIL
N.T.S.

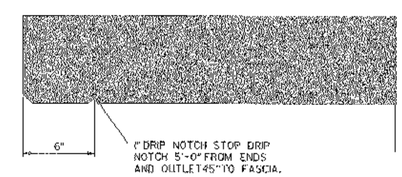

DRIP NOTCH DETAIL

SCALE 1/2" = 1'-0

FIELD CONNECTION DETAILS

PROJECT NAME: COLCHESTER	
PROJECT NUMBER: STP Bike(48)	
FILE NAME: /str5/03f038/sf038pstdet.dgn	PLOT DATE: 05-AUG-2003
PROJECT LEADER: C. KELLER	DRAWN BY: J. GEORGE
DESIGNED BY: J. GEORGE	CHECKED BY: M.E.M.
sf038pstdet4.r	SHEET 42 OF 87