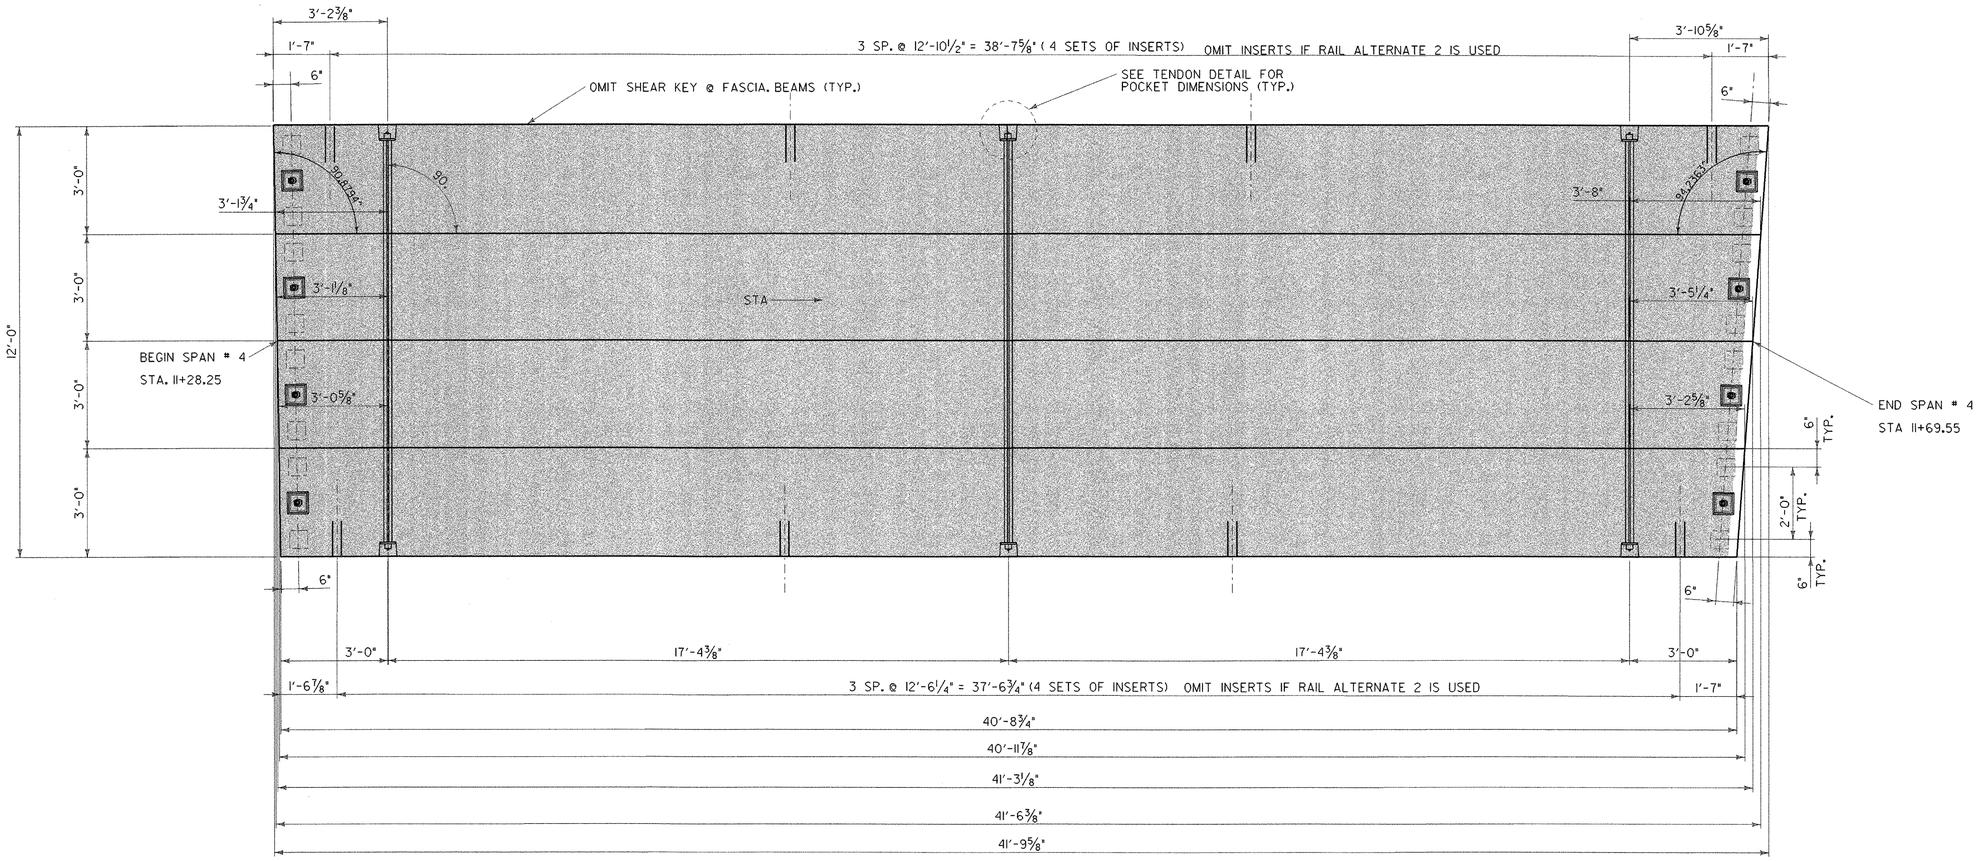

PRESTRESSED SLAB LAYOUT
SPAN 4

SCALE 1/2" = 1'-0

THE TOPS OF THE PRESTRESSED SLABS SHALL BE SCREEDED AND GIVEN A BROOMED OR WIRE BROOM FINSH.
THE GROOVES SHALL BE IN THE TRANSVERSE DIRECTION AND PENETRATE THE SURFACE APPROXIMATELY 1/4 "

SLAB DETAILS
SPAN 4

PROJECT NAME: COLCHESTER	
PROJECT NUMBER: STP Bike(48)	
FILE NAME: /str5/03f038/sf038pstdet.dgn	PLOT DATE: 05-AUG-2003
PROJECT LEADER: C. KELLER	DRAWN BY: J. GEORGE
DESIGNED BY: J. GEORGE	CHECKED BY: M.E.M.
sf038pstdet6.i	SHEET 44 OF 87