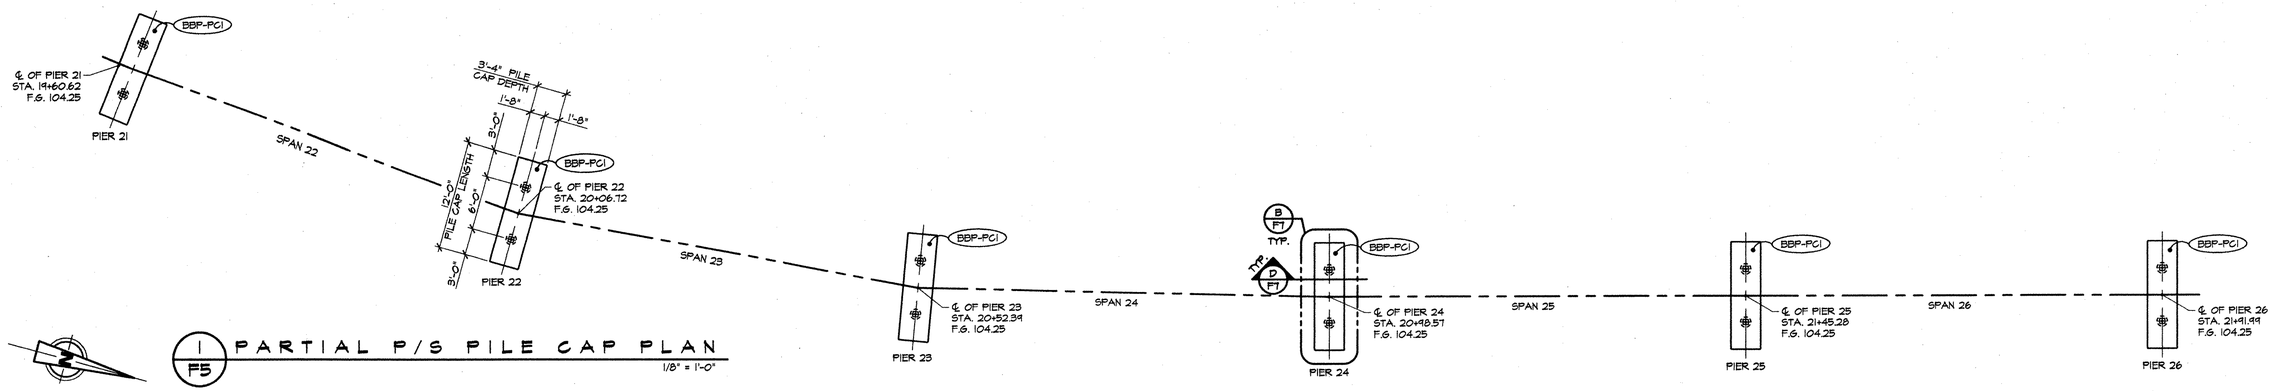

1 / F5 PARTIAL P/S PILE CAP PLAN

1/8" = 1'-0"

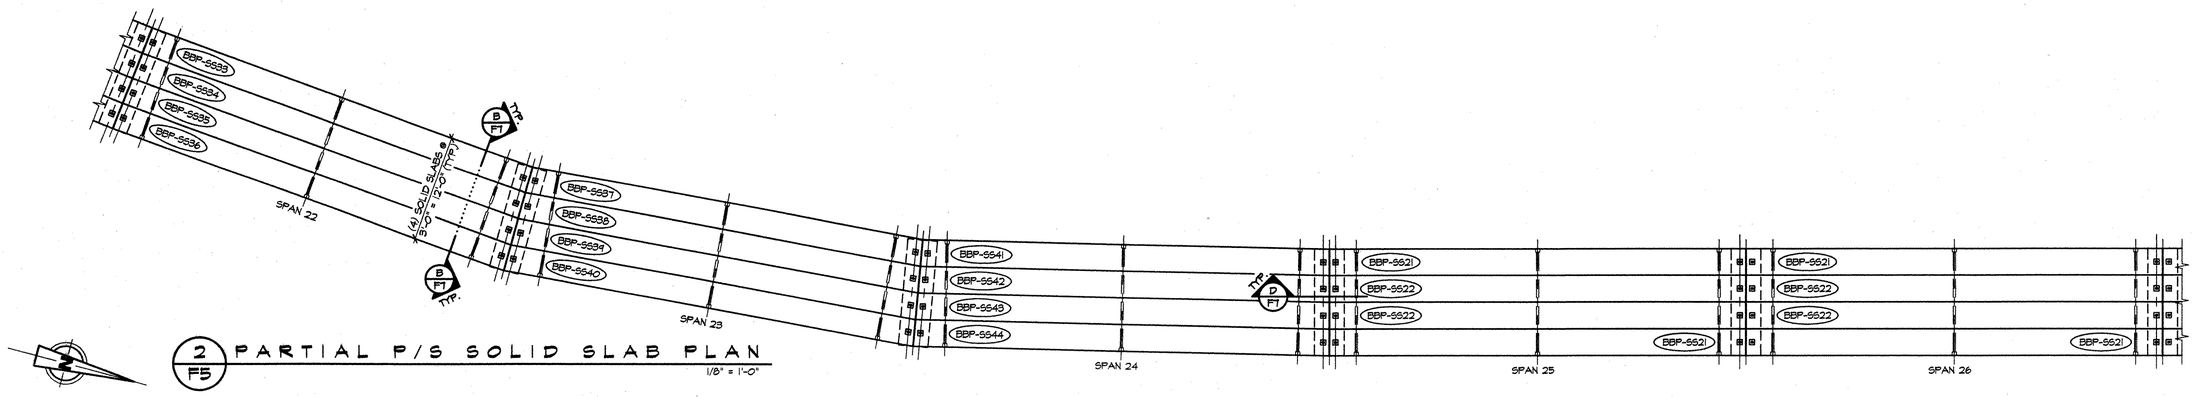

2 / F5 PARTIAL P/S SOLID SLAB PLAN

1/8" = 1'-0"

J.P. CARRARA & SONS, INC.

NOV 12 2003

ISSUED FOR PRODUCTION

APPROVAL STAMP:

RECEIVED
CK'D BY MGM OK'D BY
NOV 14 2003
RESUBMIT APPROVED ✓
BY DATE 12/3/03

J.P. CARRARA & SONS INC. Precast & Prestress Manufacturer 2464 CASE STR., MIDDLEBURY, VERMONT 05753 Phone:(802)388-6361 Fax:(802)388-9010	KUBRICKY CONSTRUCTION CORP. CONTRACTOR GLENS FALLS, NEW YORK
STATE OF VERMONT AGENCY OF TRANSPORTATION	DATE: SEPT. 26, 2003 SCALE: NOTED
TOWN OF COLCHESTER PROJECT NUMBER: STP BIKE (48)	CHKD: DFTM: B.L. JOB NO: 23169-03
P/S PILE CAP & SOLID SLAB LAYOUTS (SPANS 22-26)	DWG. NO: F5 093

F:\VT-Bridges\23169-03 Burlington Bike Path\23169-F5.dwg, 10/09/2003 12:11:21 PM