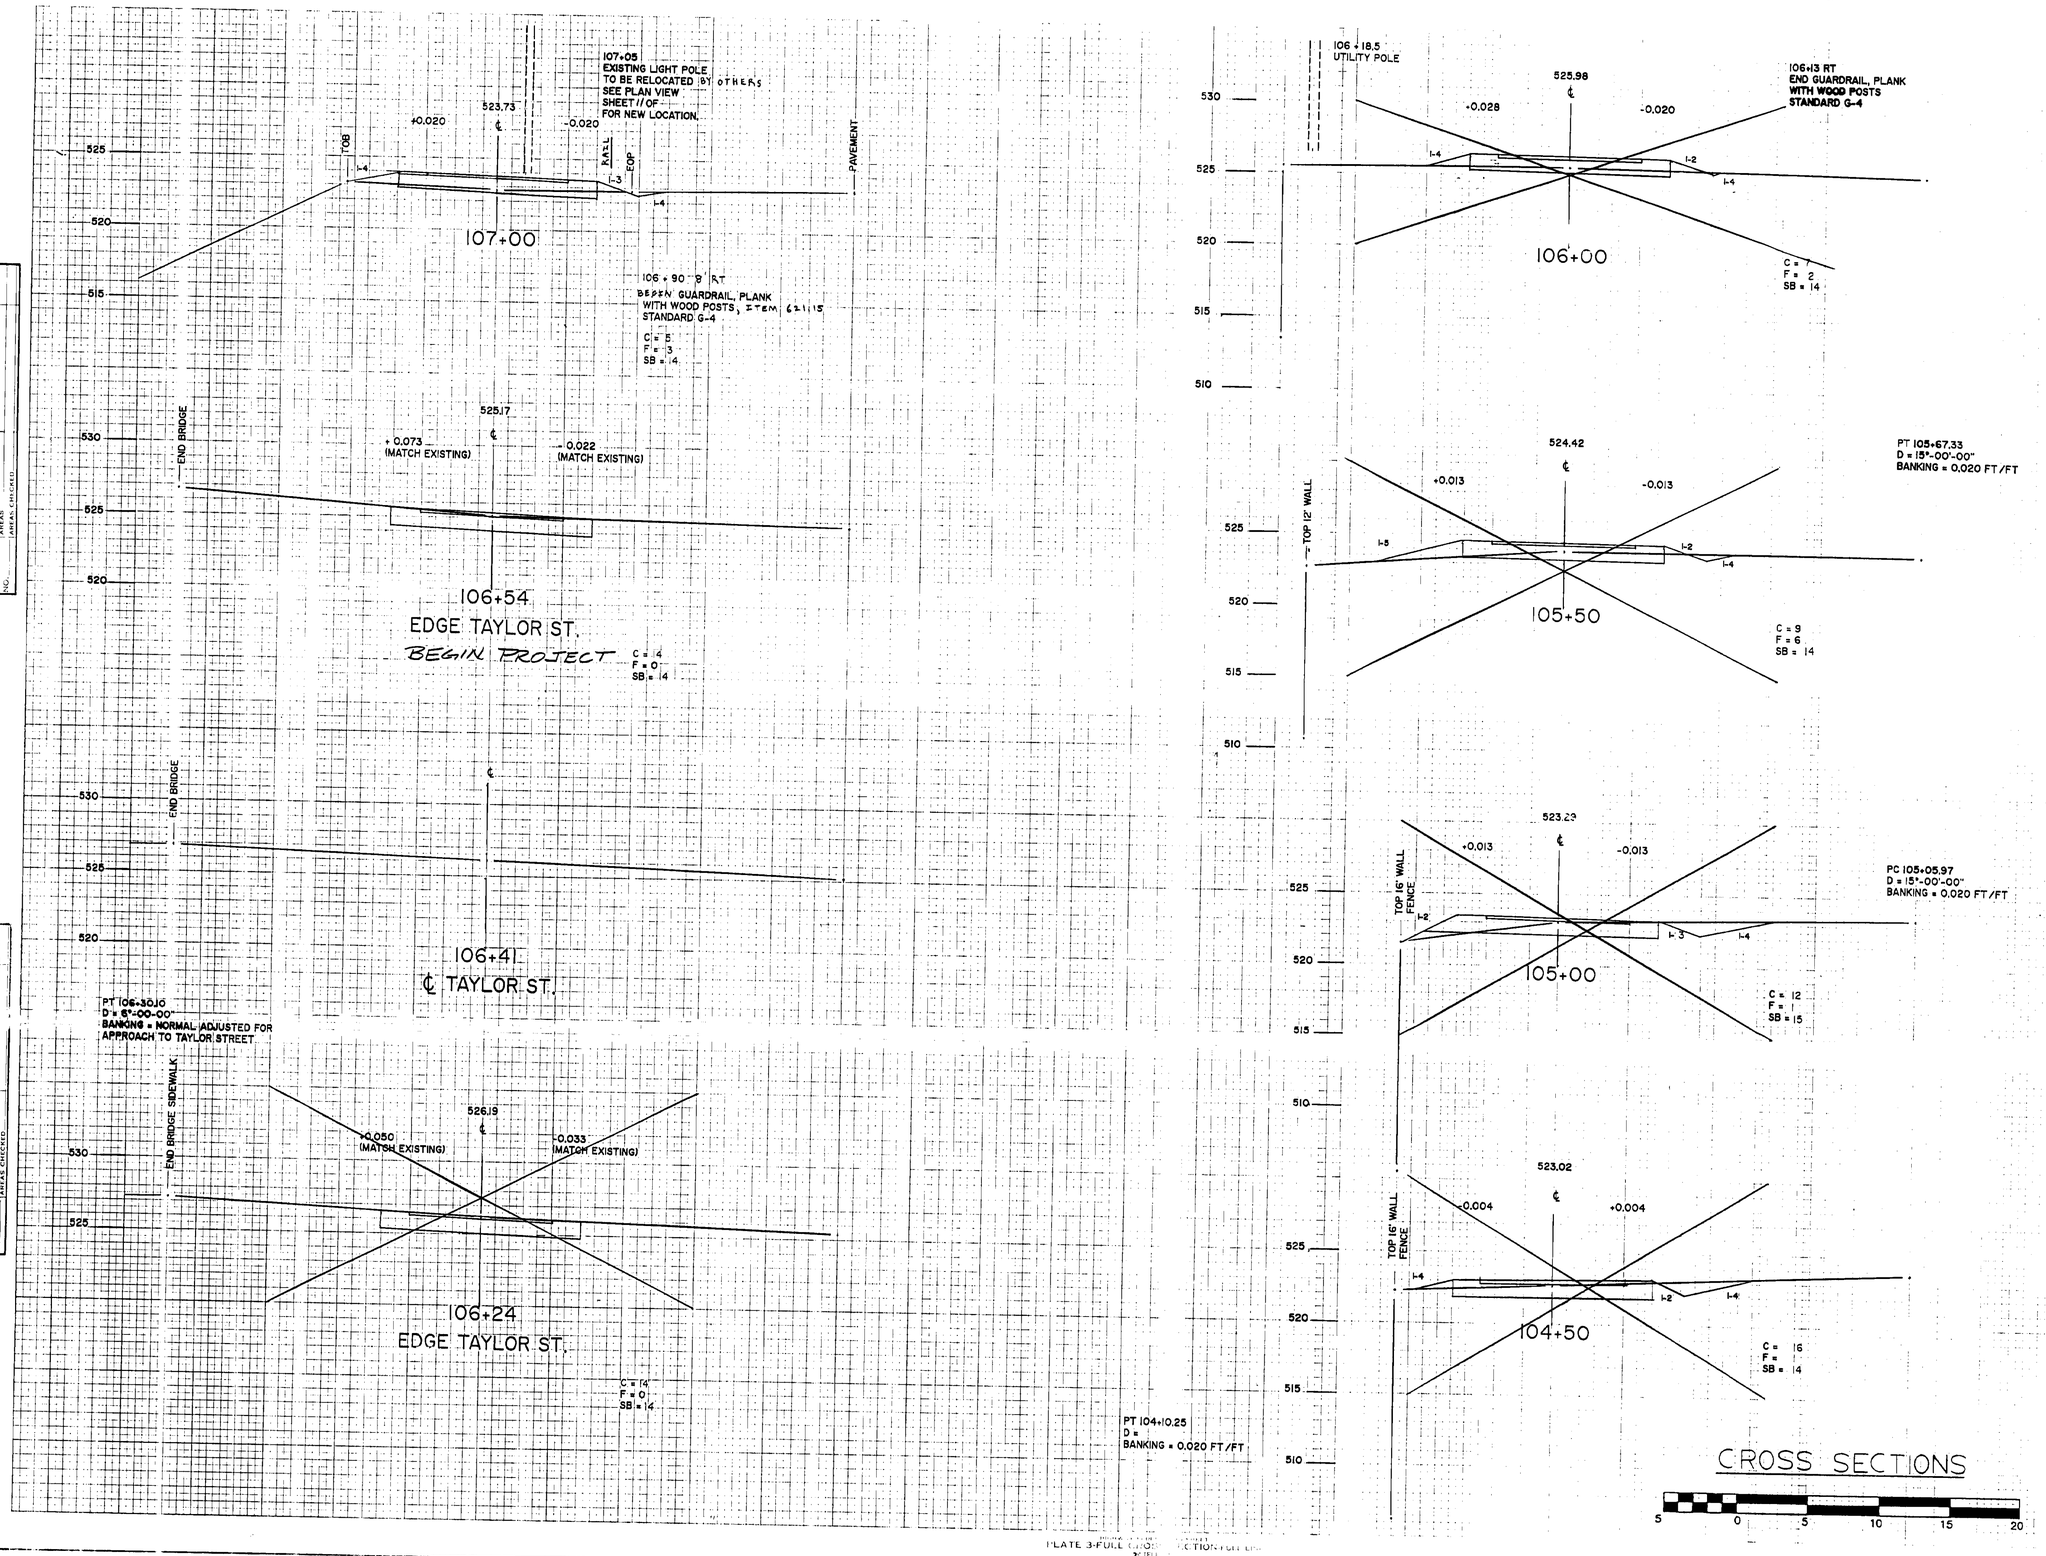

NOTE:
THE PROGRESSION OF CROSS SECTION STATIONING CONTINUES ON THE LEFT SIDE OF THE SHEET BEFORE CONTINUING ON THE FOLLOWING SHEET.

CROSS SECTIONS

5 0 5 10 15 20

FROM STA. 104+50 TO STA. 107+00

PROJECT NAME: WINOOSKI RIVER WEST BIKE PATH

NO. BWM-BIKE(4)S

PINKHAM ENGINEERING ASSOCIATES, INC.

SHEET 76 OF 132 SHEETS

FINAL
SURVEY
NOTE BOOK
NO.
DATE
PLOTTED
TEMPLATE
AREAS
AREAS CHECKED

ORIGINAL
SURVEY
NOTE BOOK
NO.
DATE
PLOTTED
TEMPLATE
AREAS
AREAS CHECKED

PLATE 3-FULL CROSS SECTIONS FOR LIN