FINAL SURVEY | SURVEYED | TEMPLATE | AREAS | AREAS CHECKED | NOTE BOOK NO.

ORIGINAL SURVEY | SURVEYED | TEMPLATE | AREAS | AREAS CHECKED | NOTE BOOK NO.

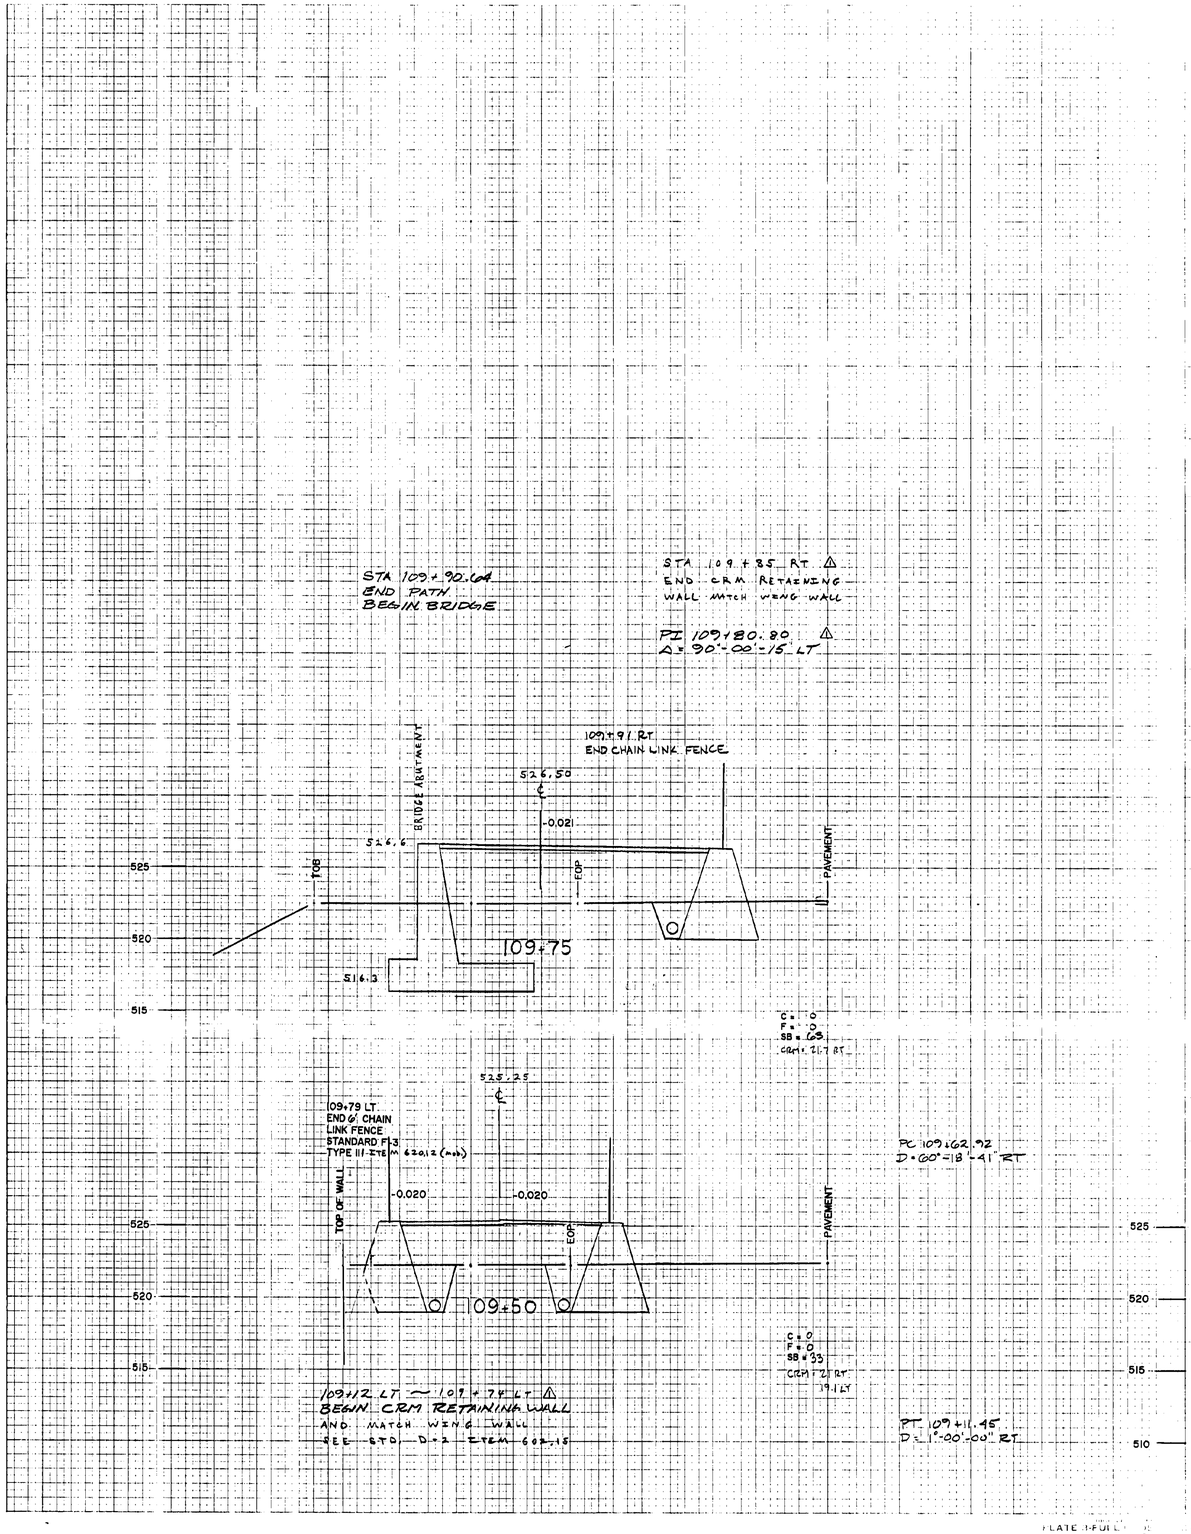

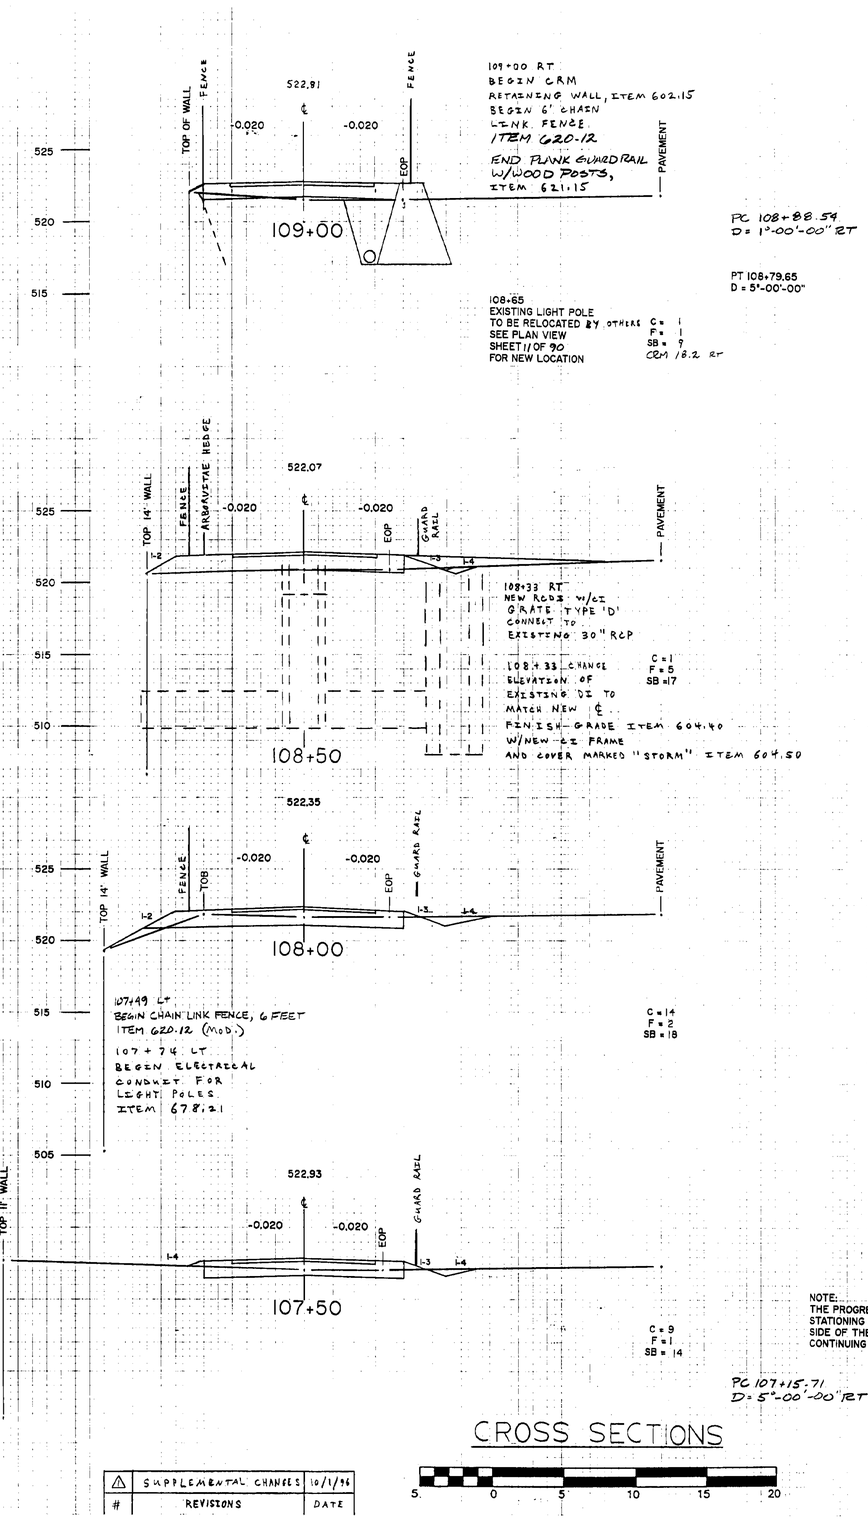

NOTE:
THE PROGRESSION OF CROSS SECTION STATIONING CONTINUES ON THE LEFT SIDE OF THE SHEET BEFORE CONTINUING ON THE FOLLOWING SHEET.

CROSS SECTIONS

#	REVISIONS	DATE
1	SUPPLEMENTAL CHANGES	10/1/96

5 0 5 10 15 20

FROM STA. 107+50 TO STA. 109+94.70

PROJECT NAME: WINOOSKI RIVER WEST BIKE PATH

NO. BWM-BIKE(4)S

PINKHAM ENGINEERING ASSOCIATES, INC.

SHEET 77 OF 132 SHEETS

PLATE 1-FULL