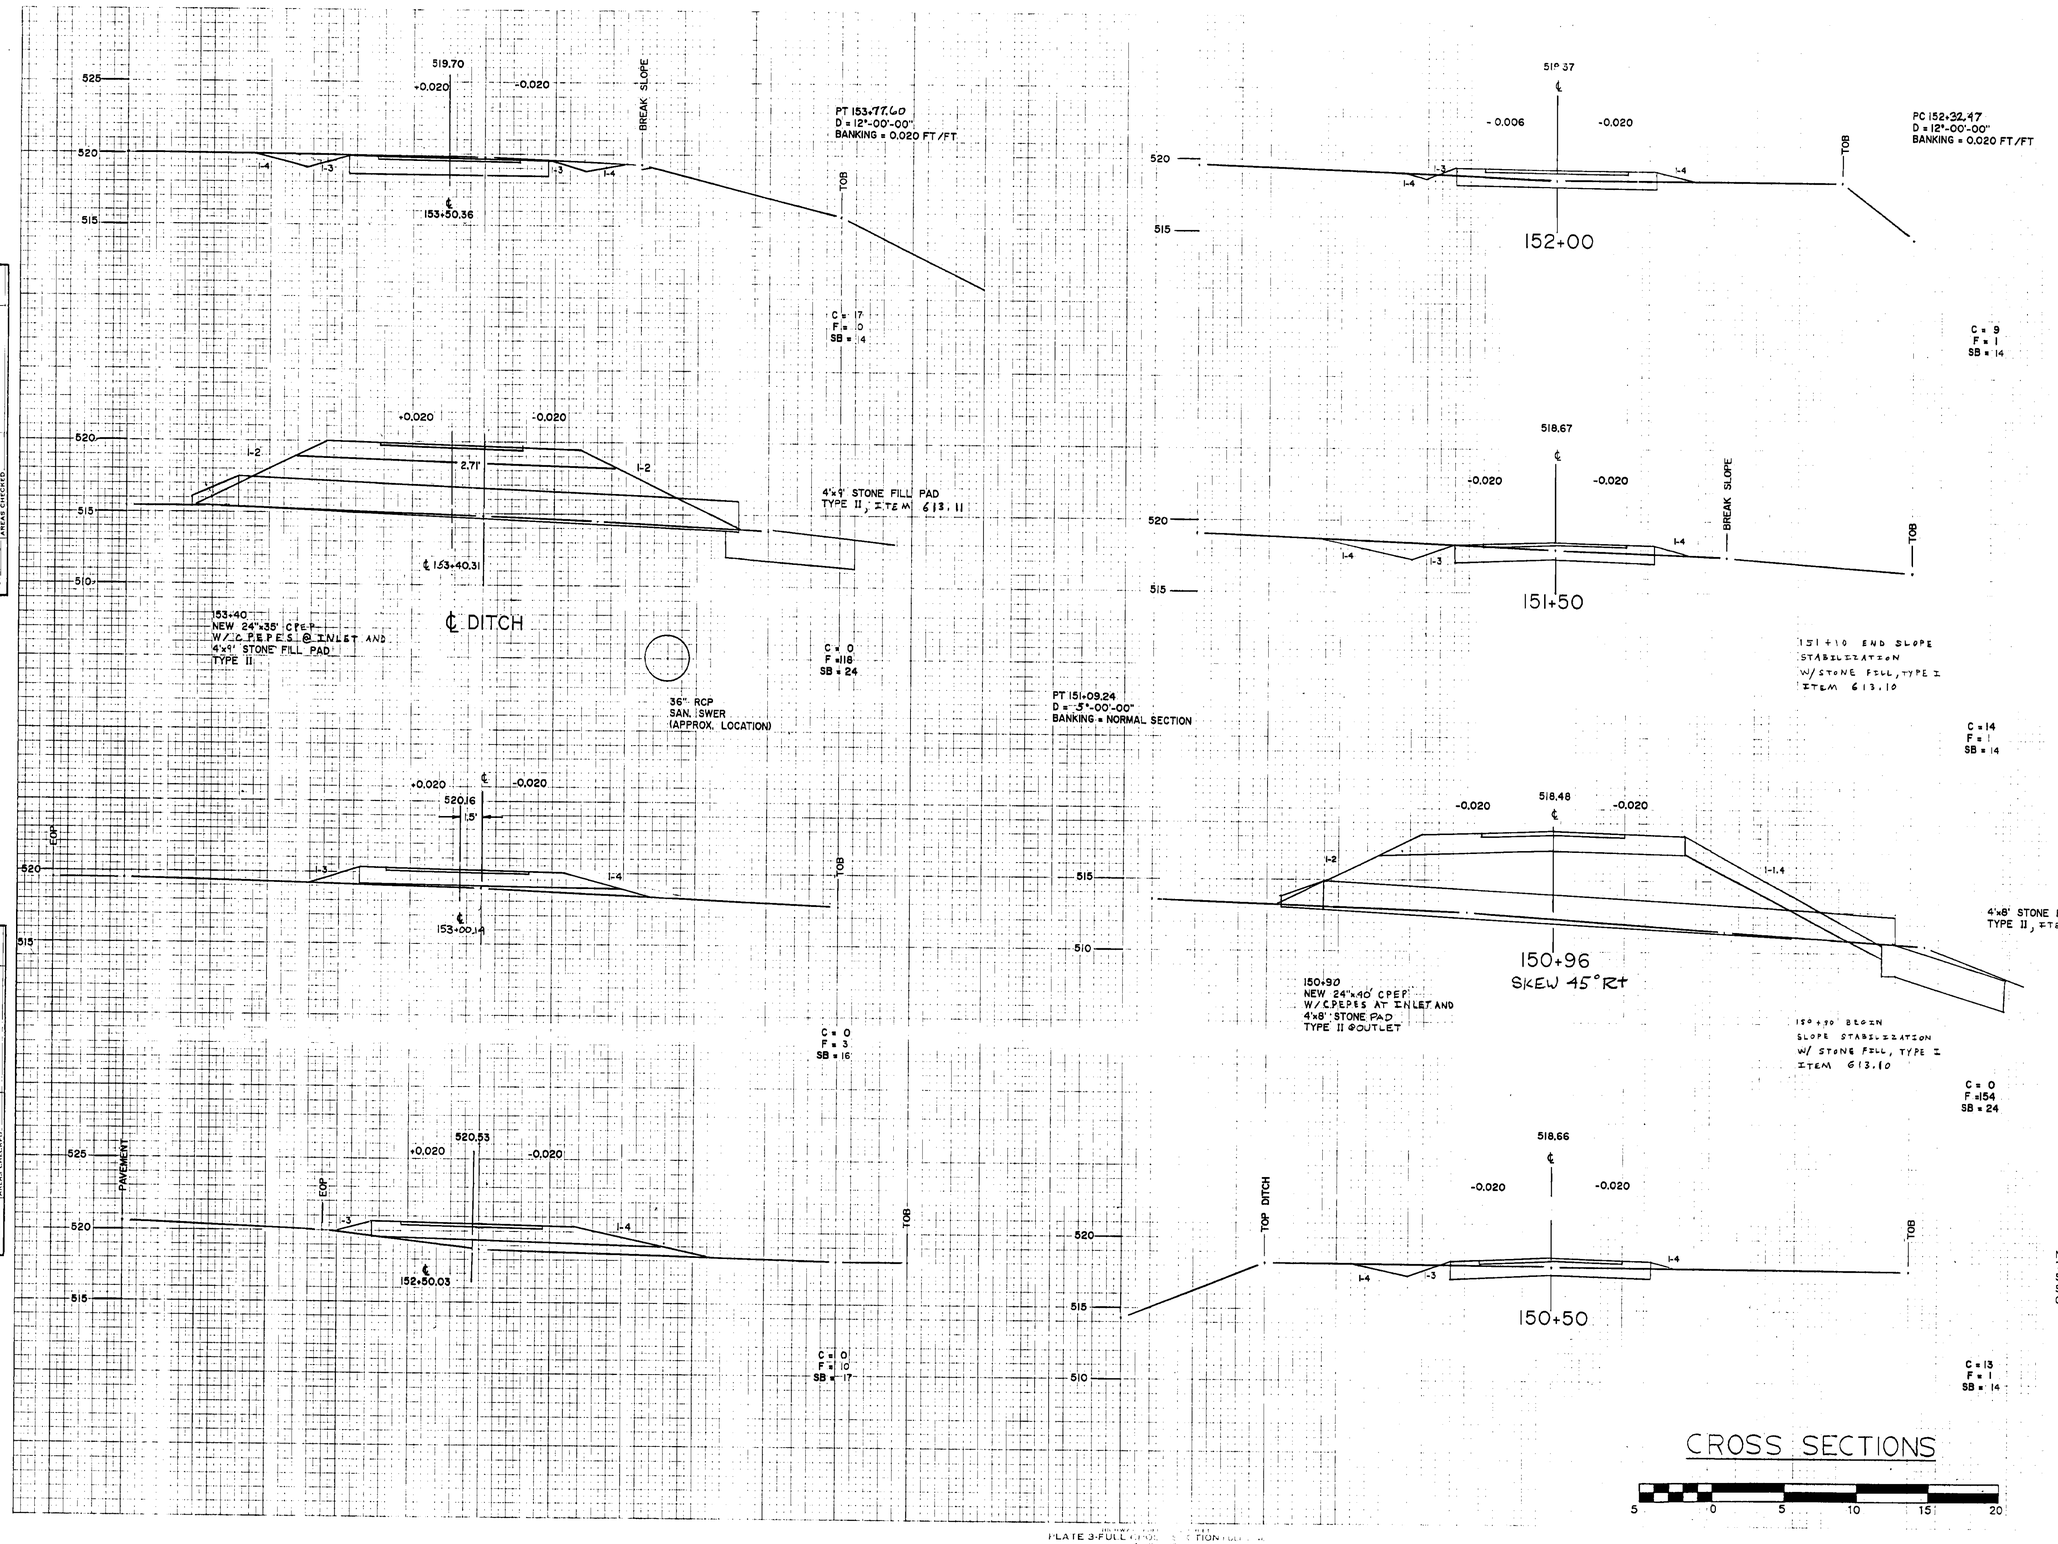

NOTE:
THE PROGRESSION OF CROSS SECTION STATIONING CONTINUES ON THE LEFT SIDE OF THE SHEET BEFORE CONTINUING ON THE FOLLOWING SHEET.

FROM STA. 150+50 TO STA. 153+50

PROJECT NAME: WINOOSKI RIVER WEST BIKE PATH

NO. BWM-BIKE(4)S

PINKHAM ENGINEERING ASSOCIATES, INC.

SHEET 90 OF 132 SHEETS

FINAL SURVEY — FIELDWORK, PLOTTED, NOTE BOOK, TEMPLATE, AREAS, AREAS CHECKED, NO.

ORIGINAL SURVEY — FIELDWORK, PLOTTED, NOTE BOOK, TEMPLATE, AREAS, AREAS CHECKED, NO.

PLATE 3-FULL CROSS SECTION