



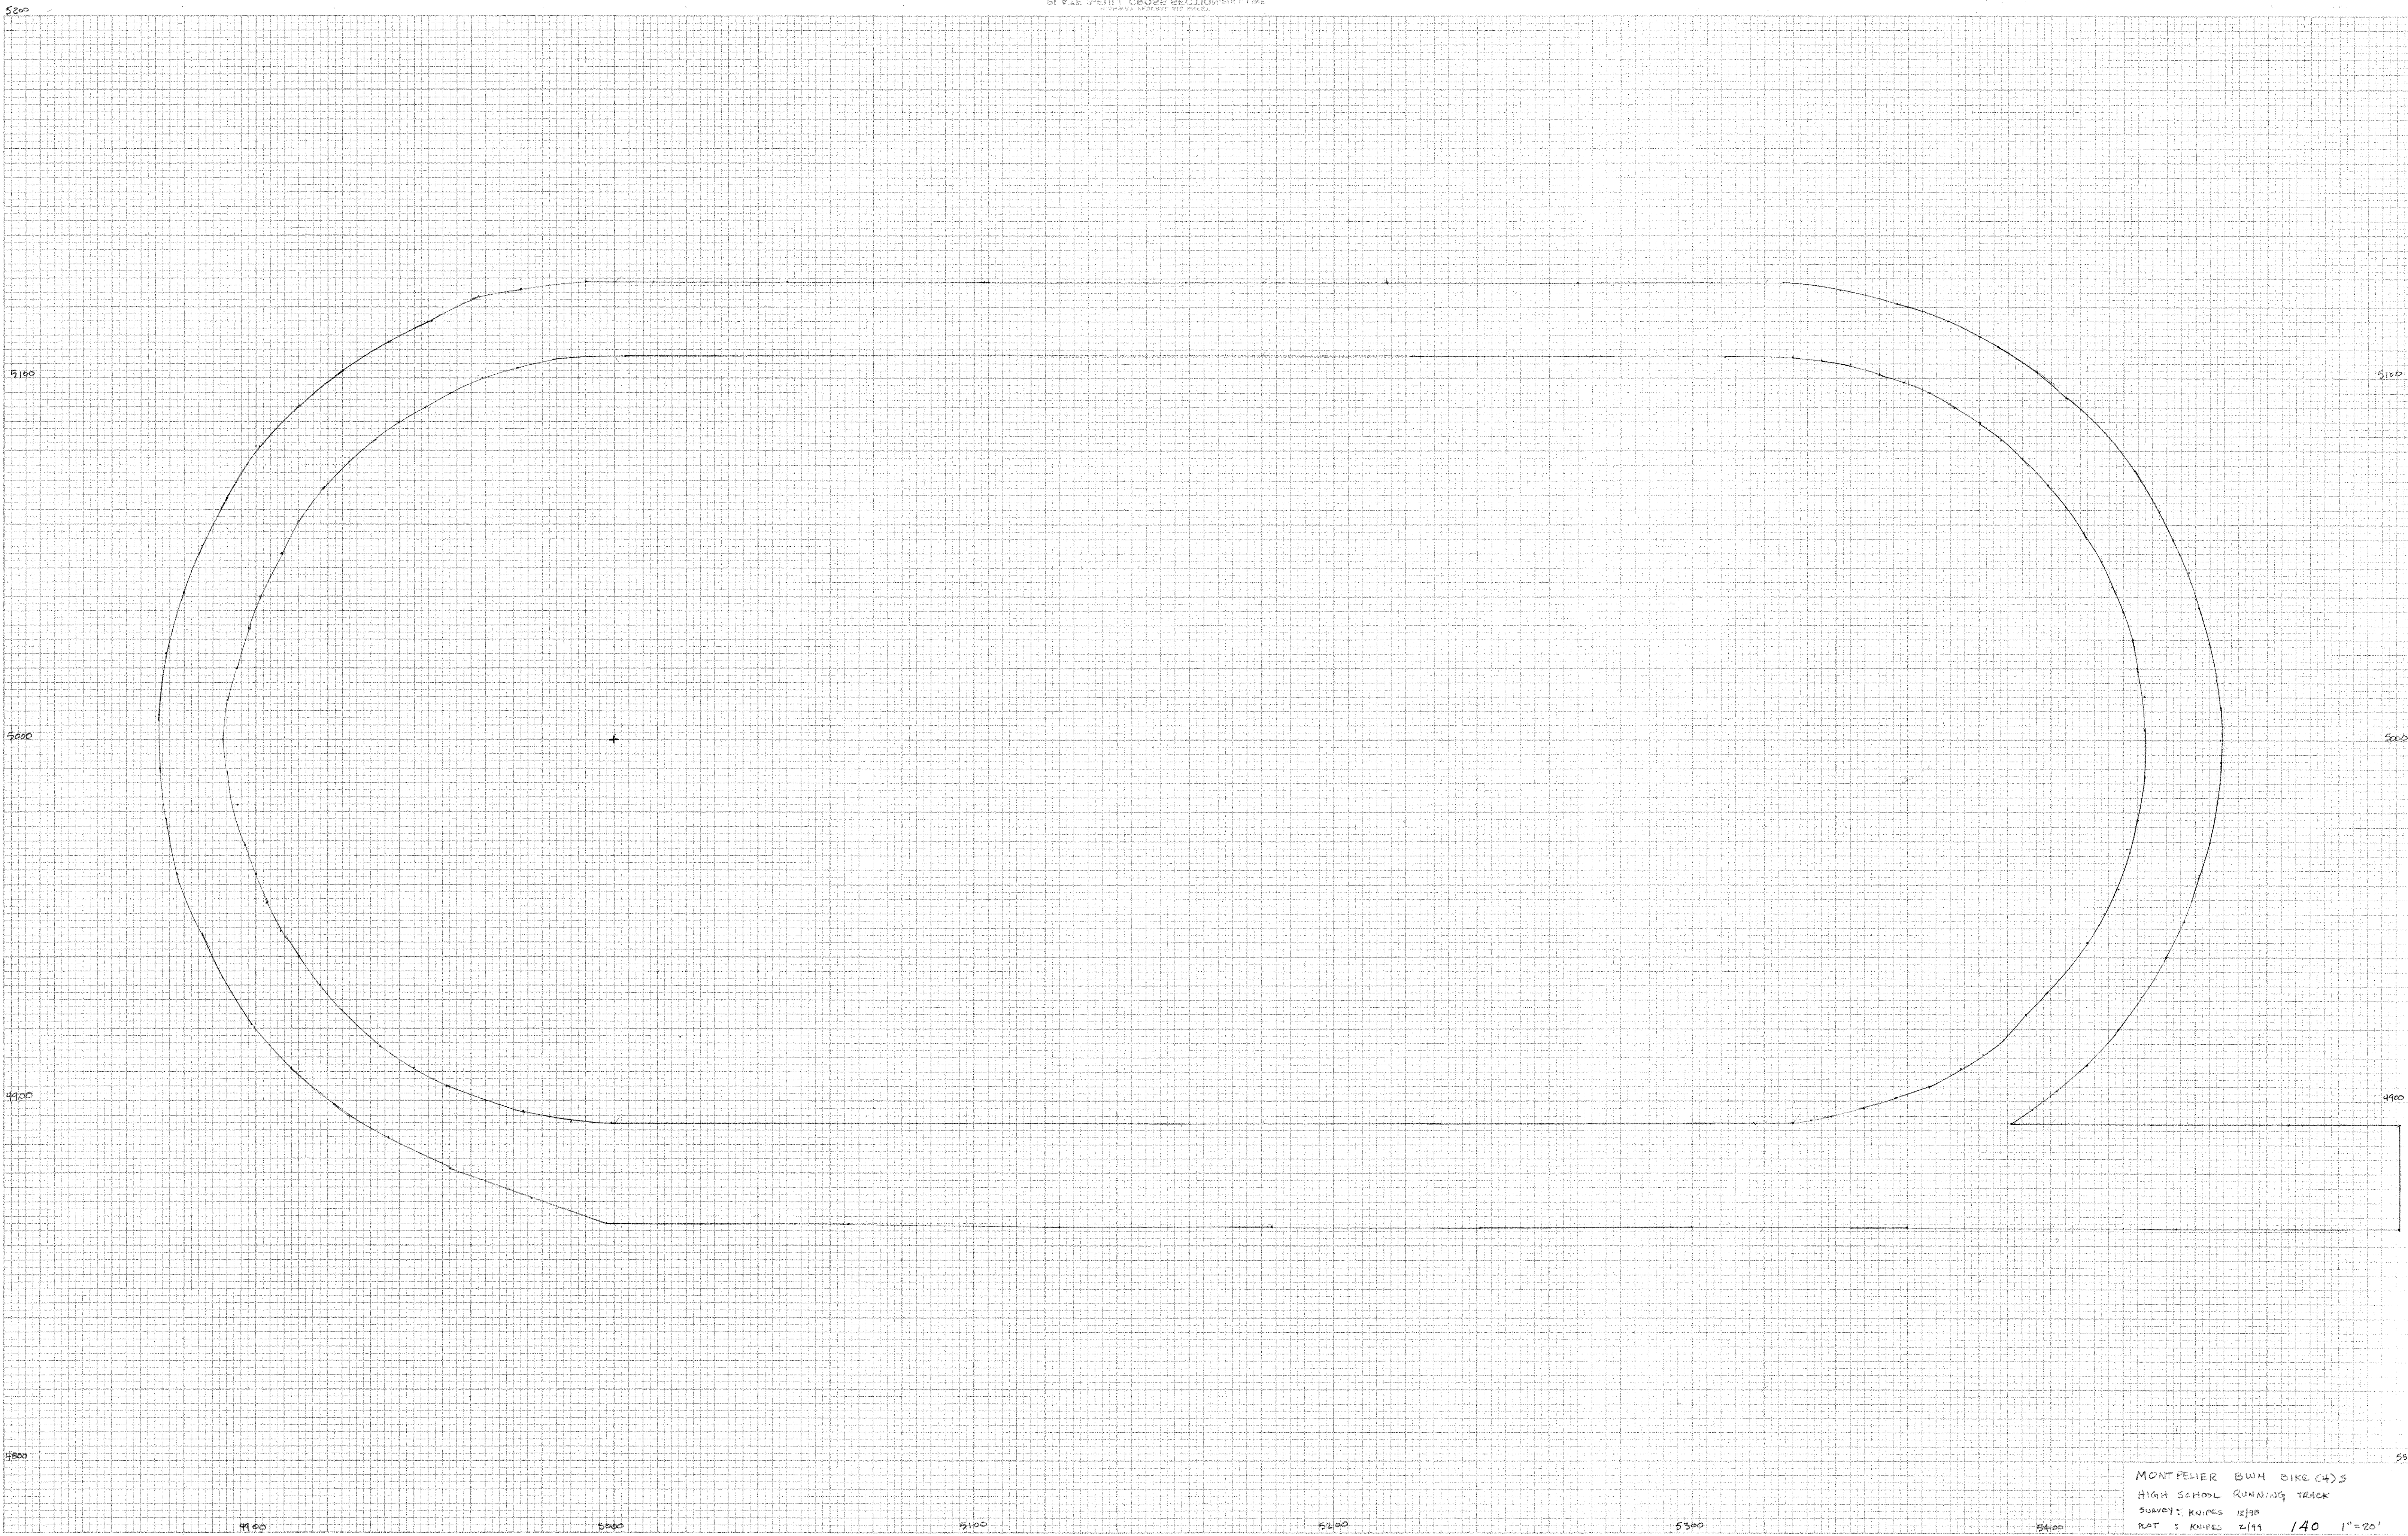




MONTPELIER BWM BIKE (4)S  
HIGH SCHOOL RUNNING TRACK  
SURVEY: KNIPES 12/98  
