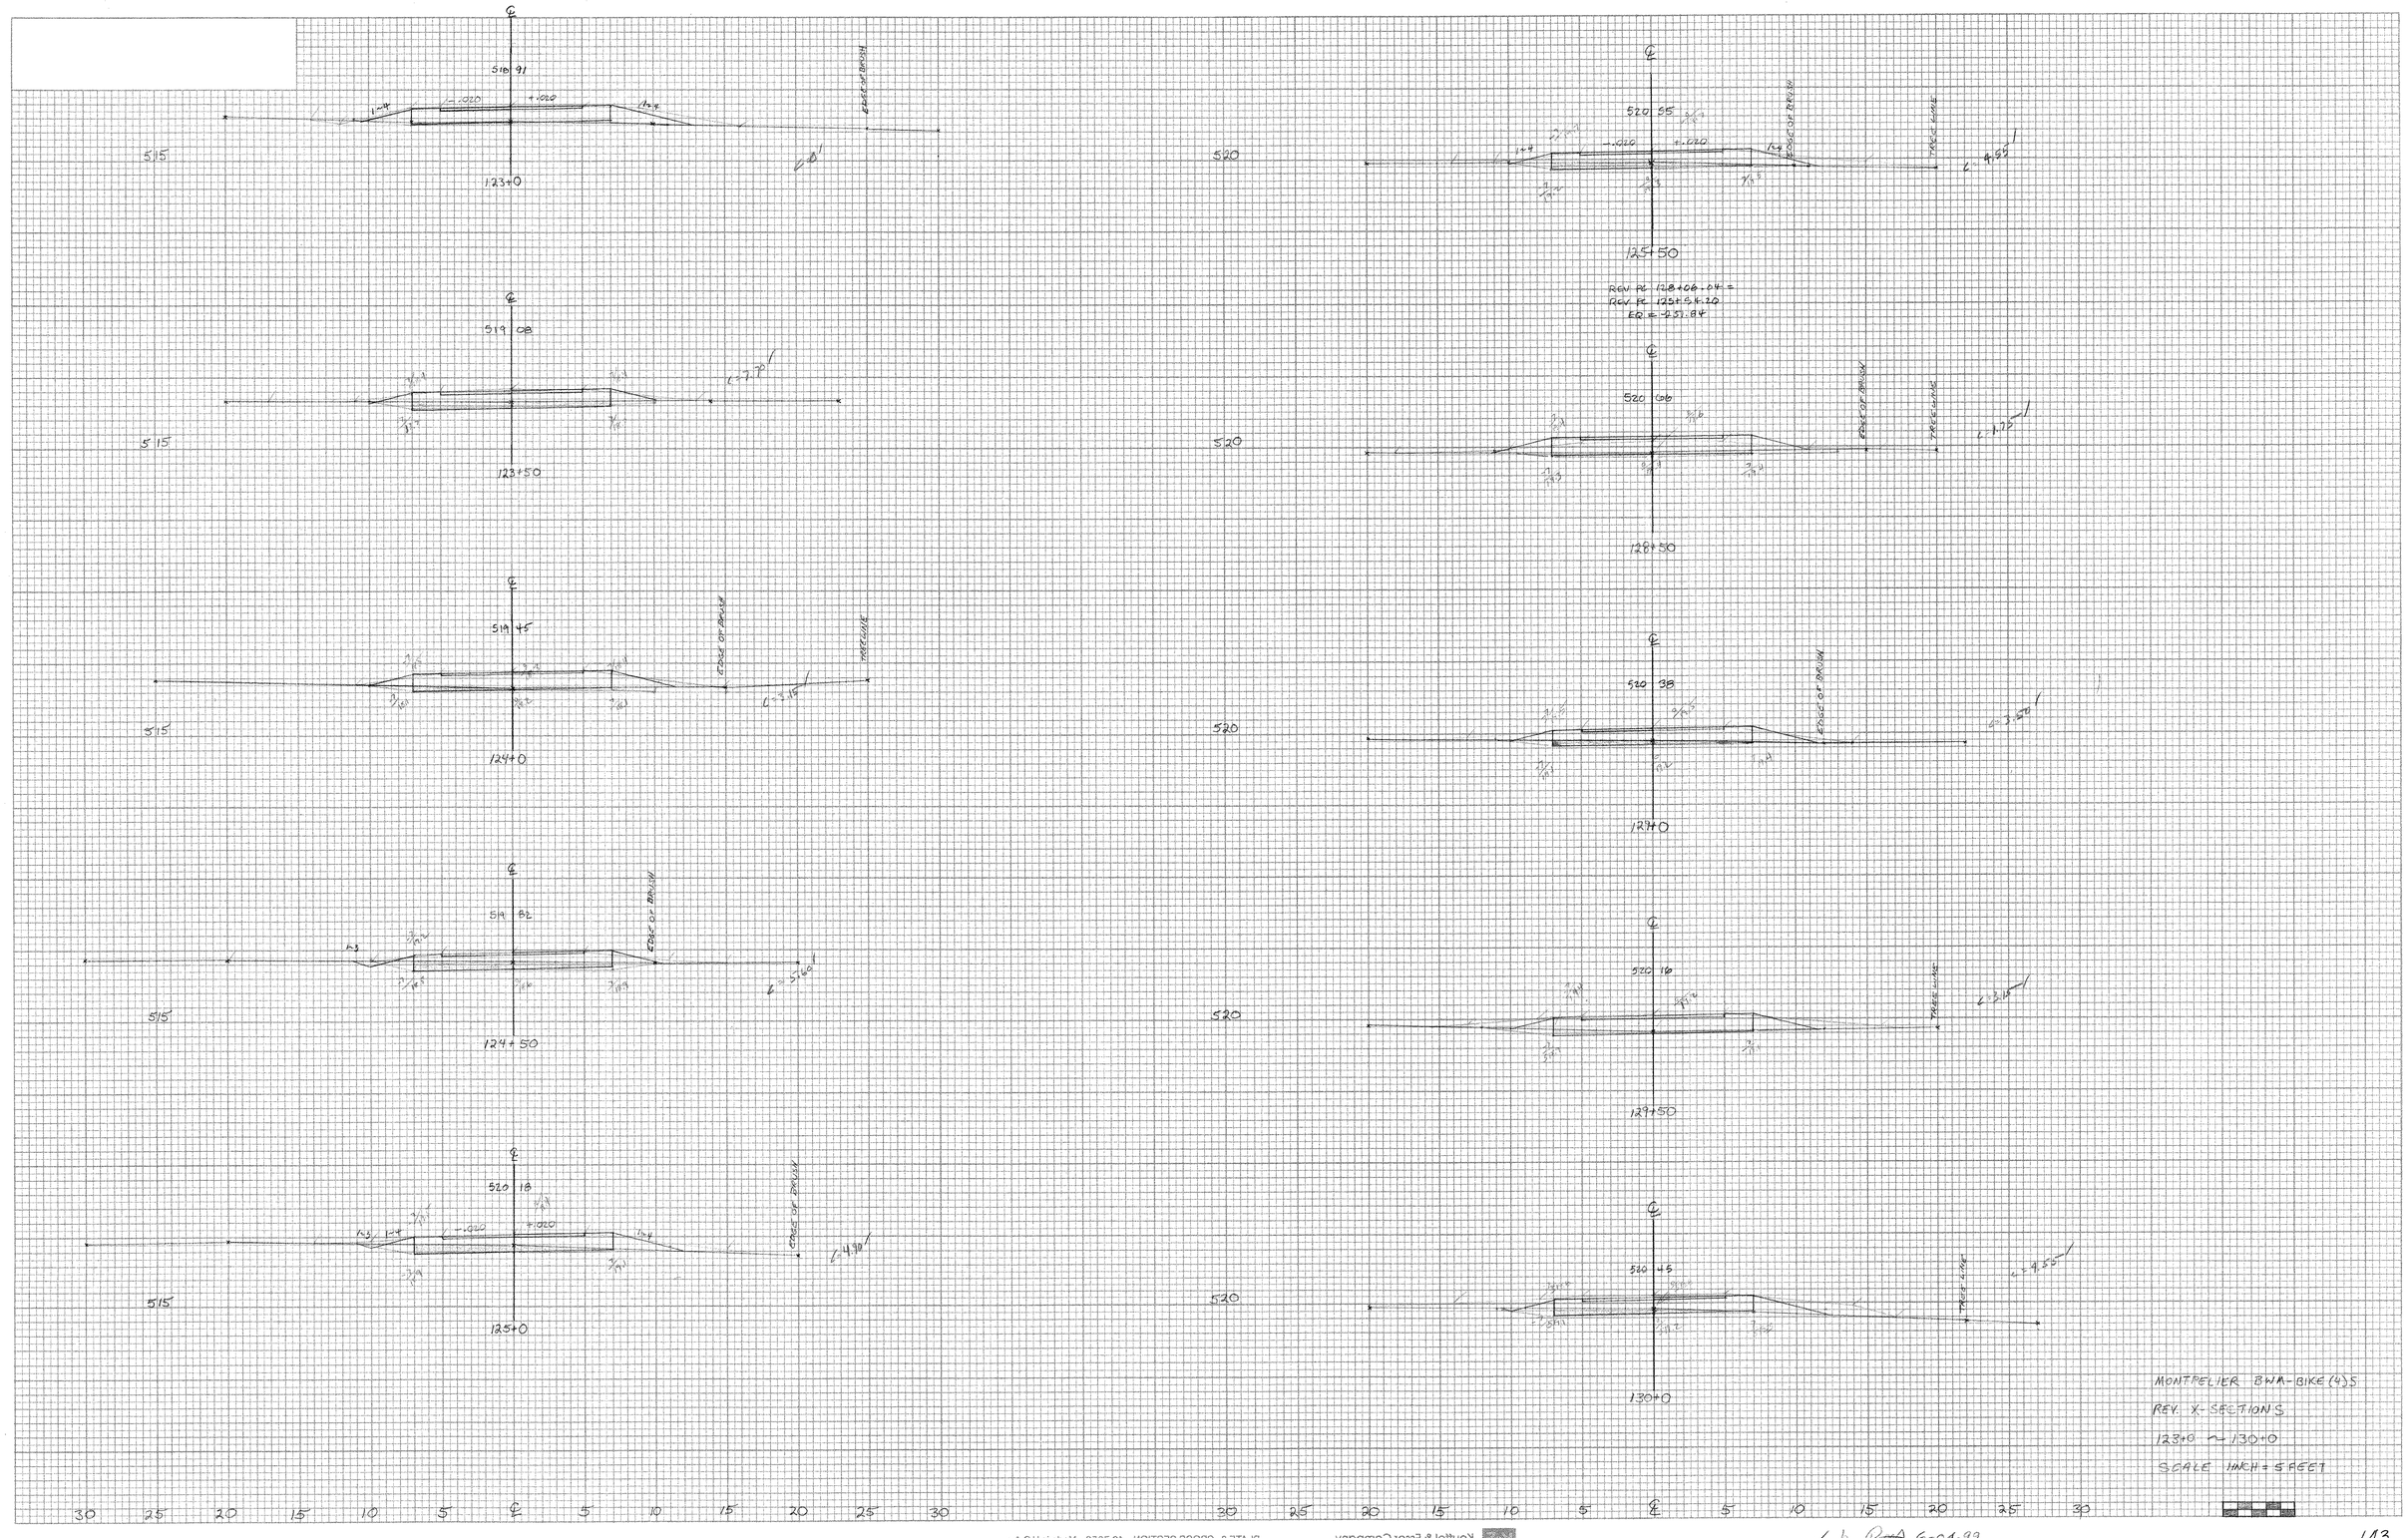
515
519.91
123+0
EDGE OF BROW
515
519.08
123+50
515
519.45
124+0
EDGE OF BROW
TREE LINE
515
518.82
124+50
EDGE OF BROW
515
518.18
125+0
EDGE OF BROW
520
520.55
125+50
EDGE OF BROW
TREE LINE
REV PE 128+06.04 =
REV PE 125+54.20
EQ = -51.84
520
520.66
126+50
EDGE OF BROW
TREE LINE
520
520.38
127+0
EDGE OF BROW
520
520.16
127+50
TREE LINE
520
520.45
130+0
TREE LINE
MONTPELIER BWA-BIKE(4)S
REV. X-SECTIONS
123+0 ~ 130+0
SCALE 1INCH = 5FEET
30 25 20 15 10 5 ℄ 5 10 15 20 25 30
Kuttel & Esser Company
PLATE 3, CROSS SECTION 48 7058 Made in U.S.A.
✓ by 6-04-99
143