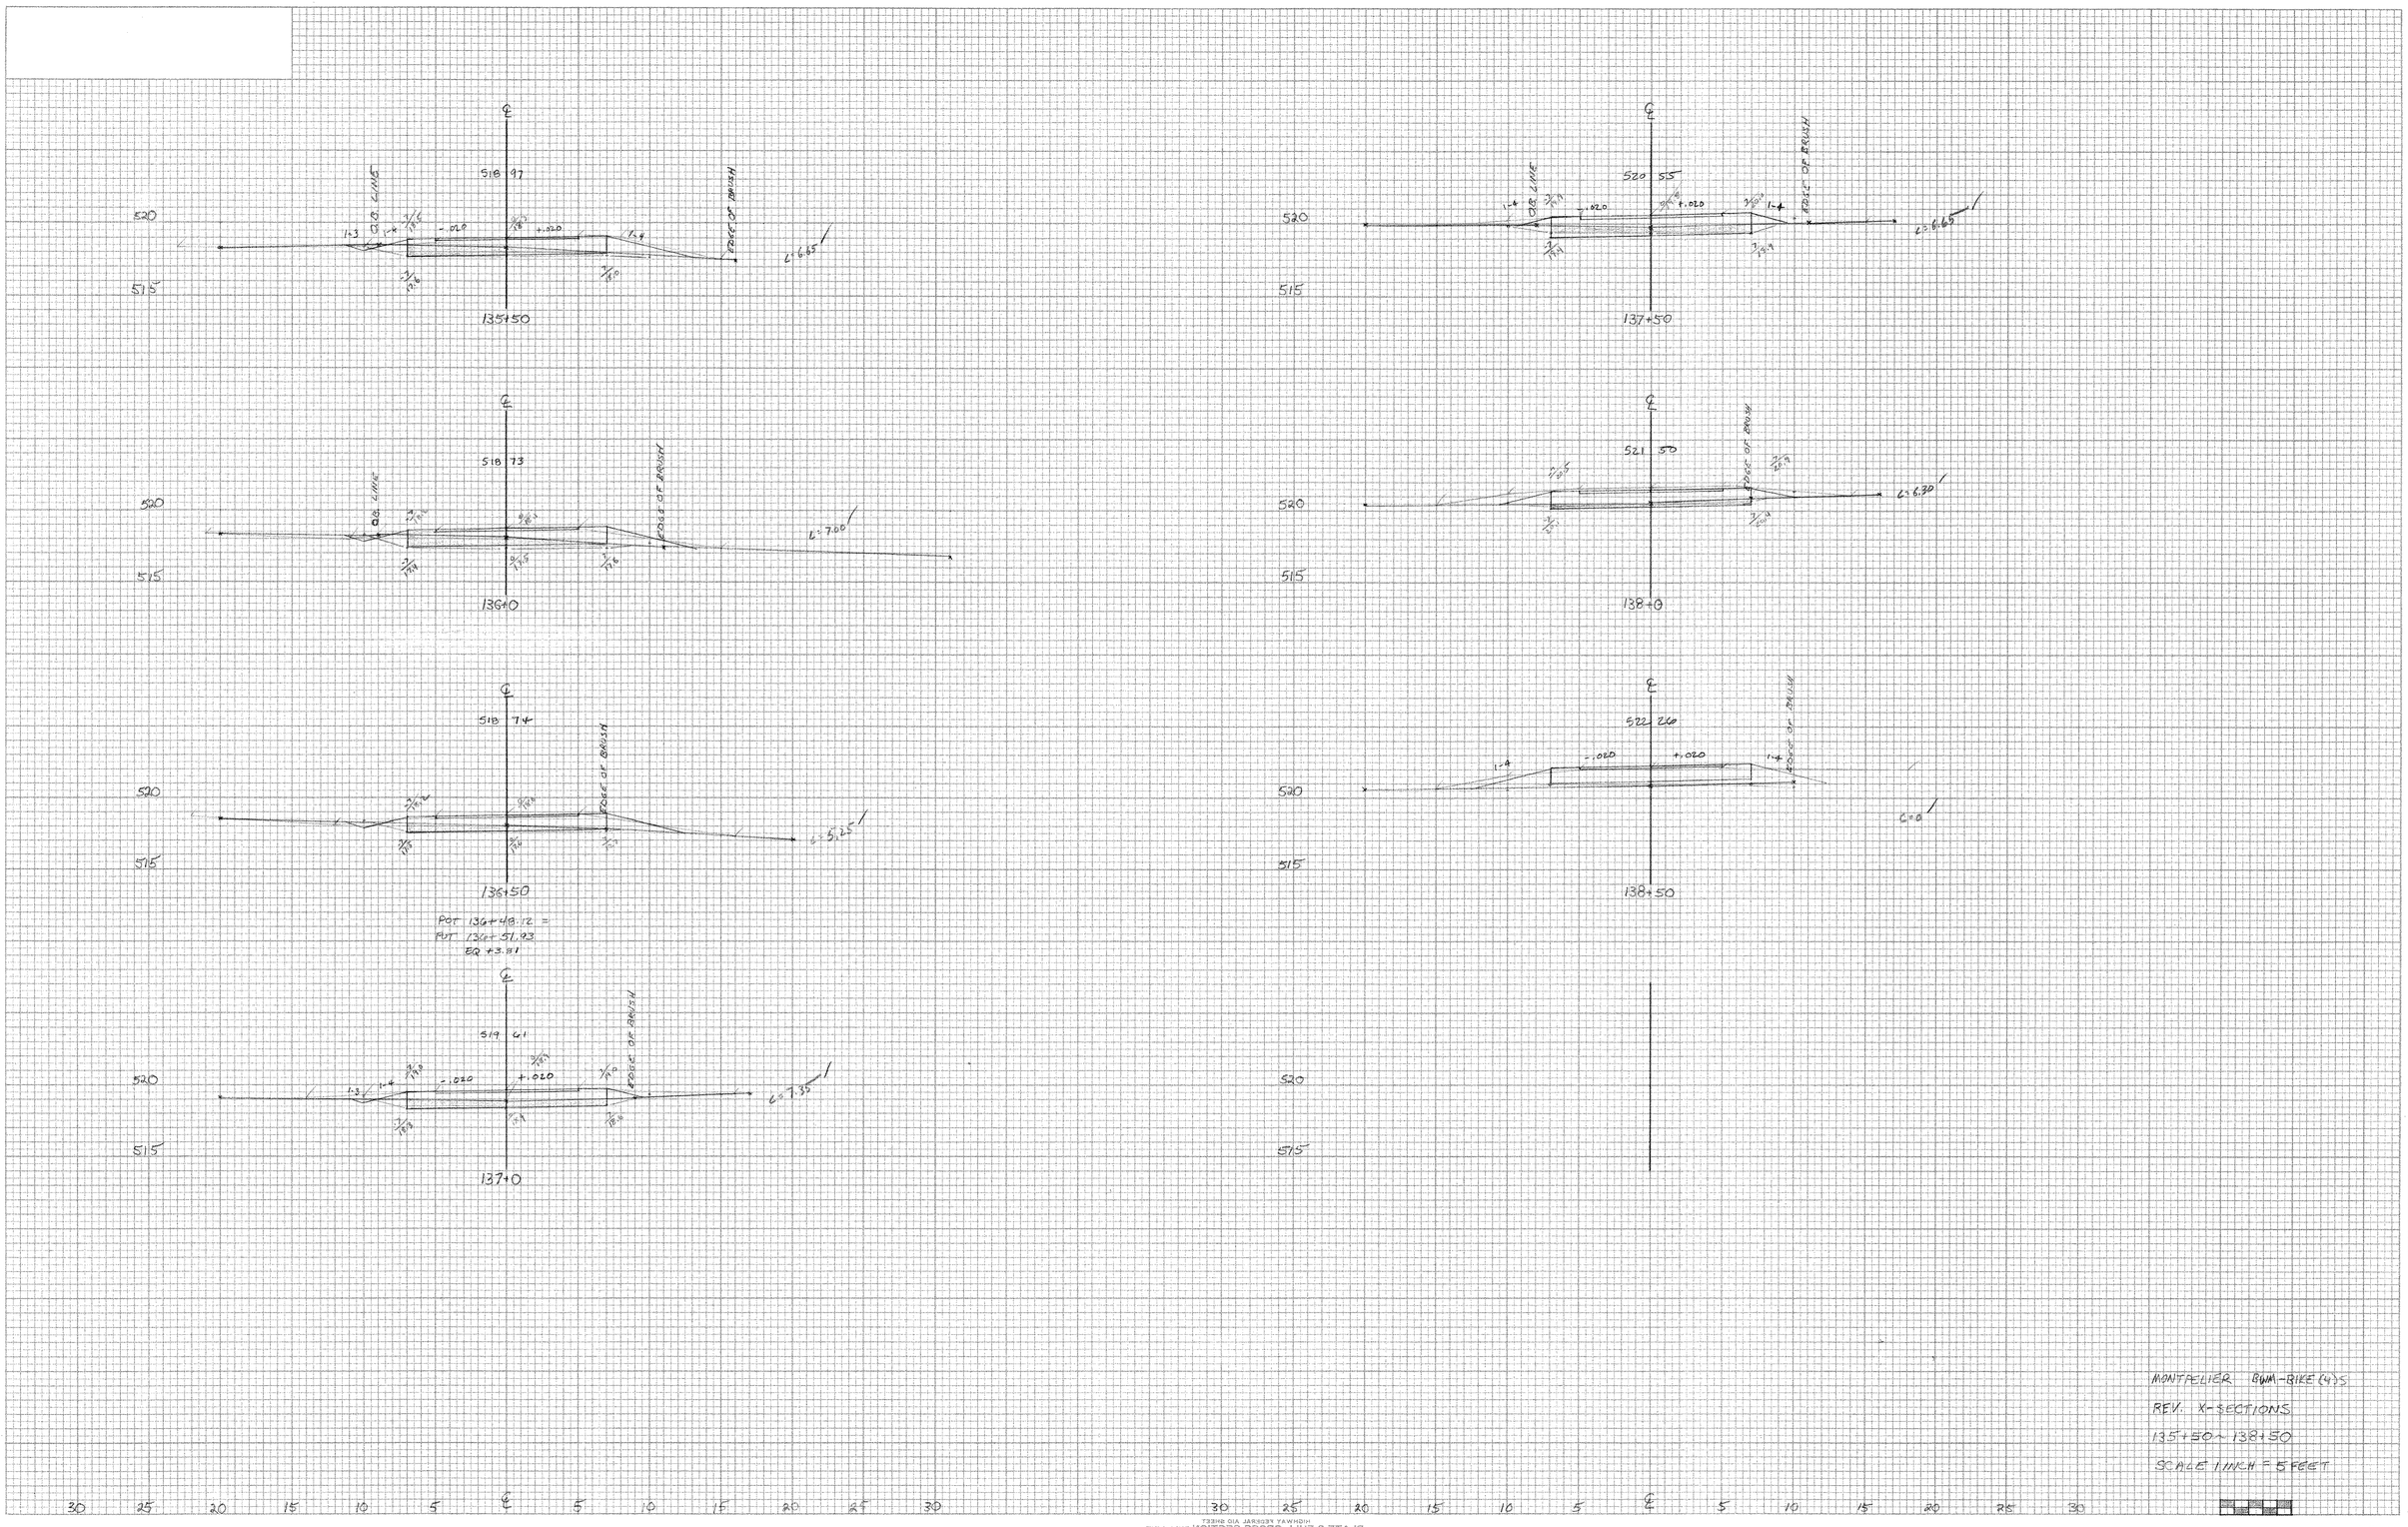


MONTPELIER BWM-BIKE (4)S

REV. X-SECTIONS

135+50 ~ 138+50

SCALE 1 INCH = 5 FEET

| NO | DATE | REVISION | BY |
|---|---|---|---|
| | | | |

NO. ____ DATE ____
NOTE BOOK ____ VERIFIED ____
SURVEY ____ DRAWN ____
PLOTTED ____ CHECKED ____
DESIGNED ____ VERIFIED ____

ORIGINAL SURVEY
DATE ____
SURVEYED ____
PLOTTED ____
DRAWN ____
CHECKED ____



HIGHWAY FEDERAL AID SHEET
PLATE 3-FULL CROSS SECTION-FULL LINE
NATIONAL PRINTERS
PRINTED IN U.S.A.

J by [illegible] 6-07-99