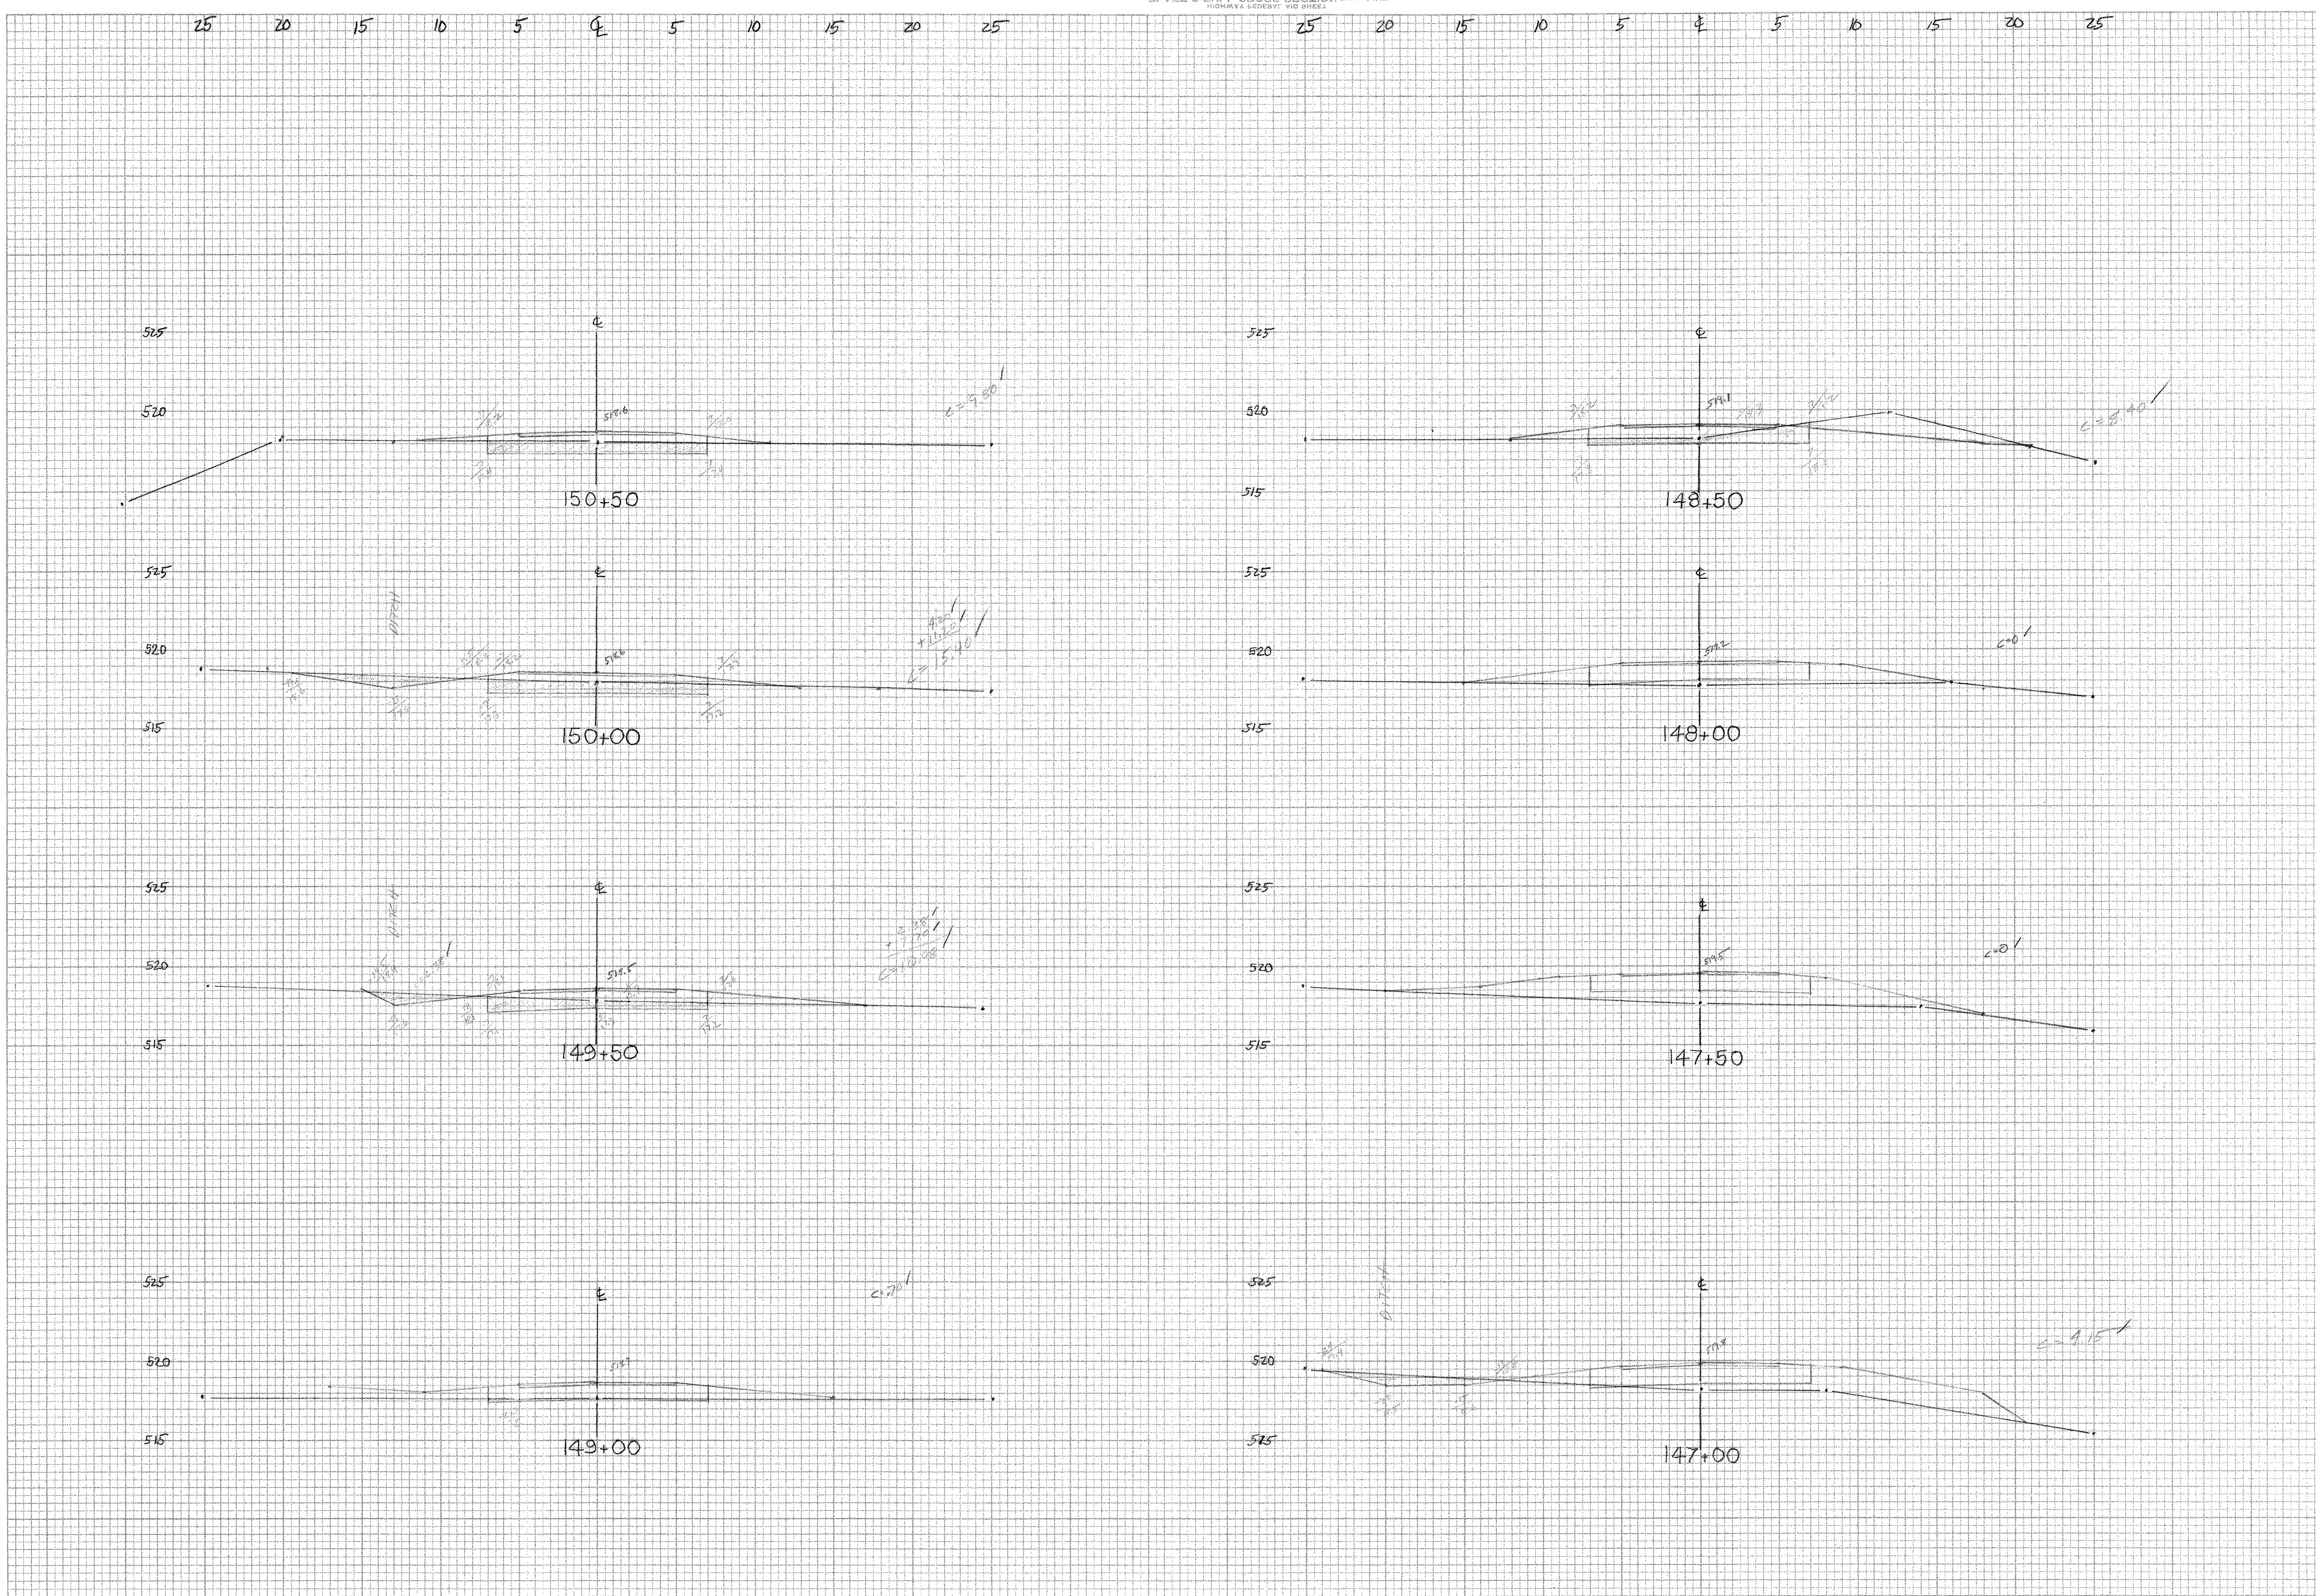

MONTPELIER BWM-BIKE(4)S
SCALE 1" = 5'
147+00 ~ 150+50

148

/ by [illegible] 6-07-99