STEEL BEAM GUARD RAIL
ML STA. 38+00 ~ 39+50 RT.
TWISTED END SECTION (FLARED)
ML STA. 39+50 ~ 39+75 RT.

EROSION MATTING

LT.	RT.
STA. 42+00 ~ 43+00	STA. 39+90 ~ 41+00
STA. 51+50 ~ 54+50	STA. 50+50 ~ 51+50
BKWY STA. 9+96 ~ 11+58	BKWY STA. 5+82 ~ 6+84
BKWY STA. 14+33 ~ 19+18	BKWY STA. 14+87 ~ 20+73

CONSTRUCT VISUAL BARRIER
BKWY STA. 15+35 ~ 26+00 RT.

SPECIAL R.O.W. FENCE
STA. 37+32,71' LT. - STA. 39+30,70' LT.
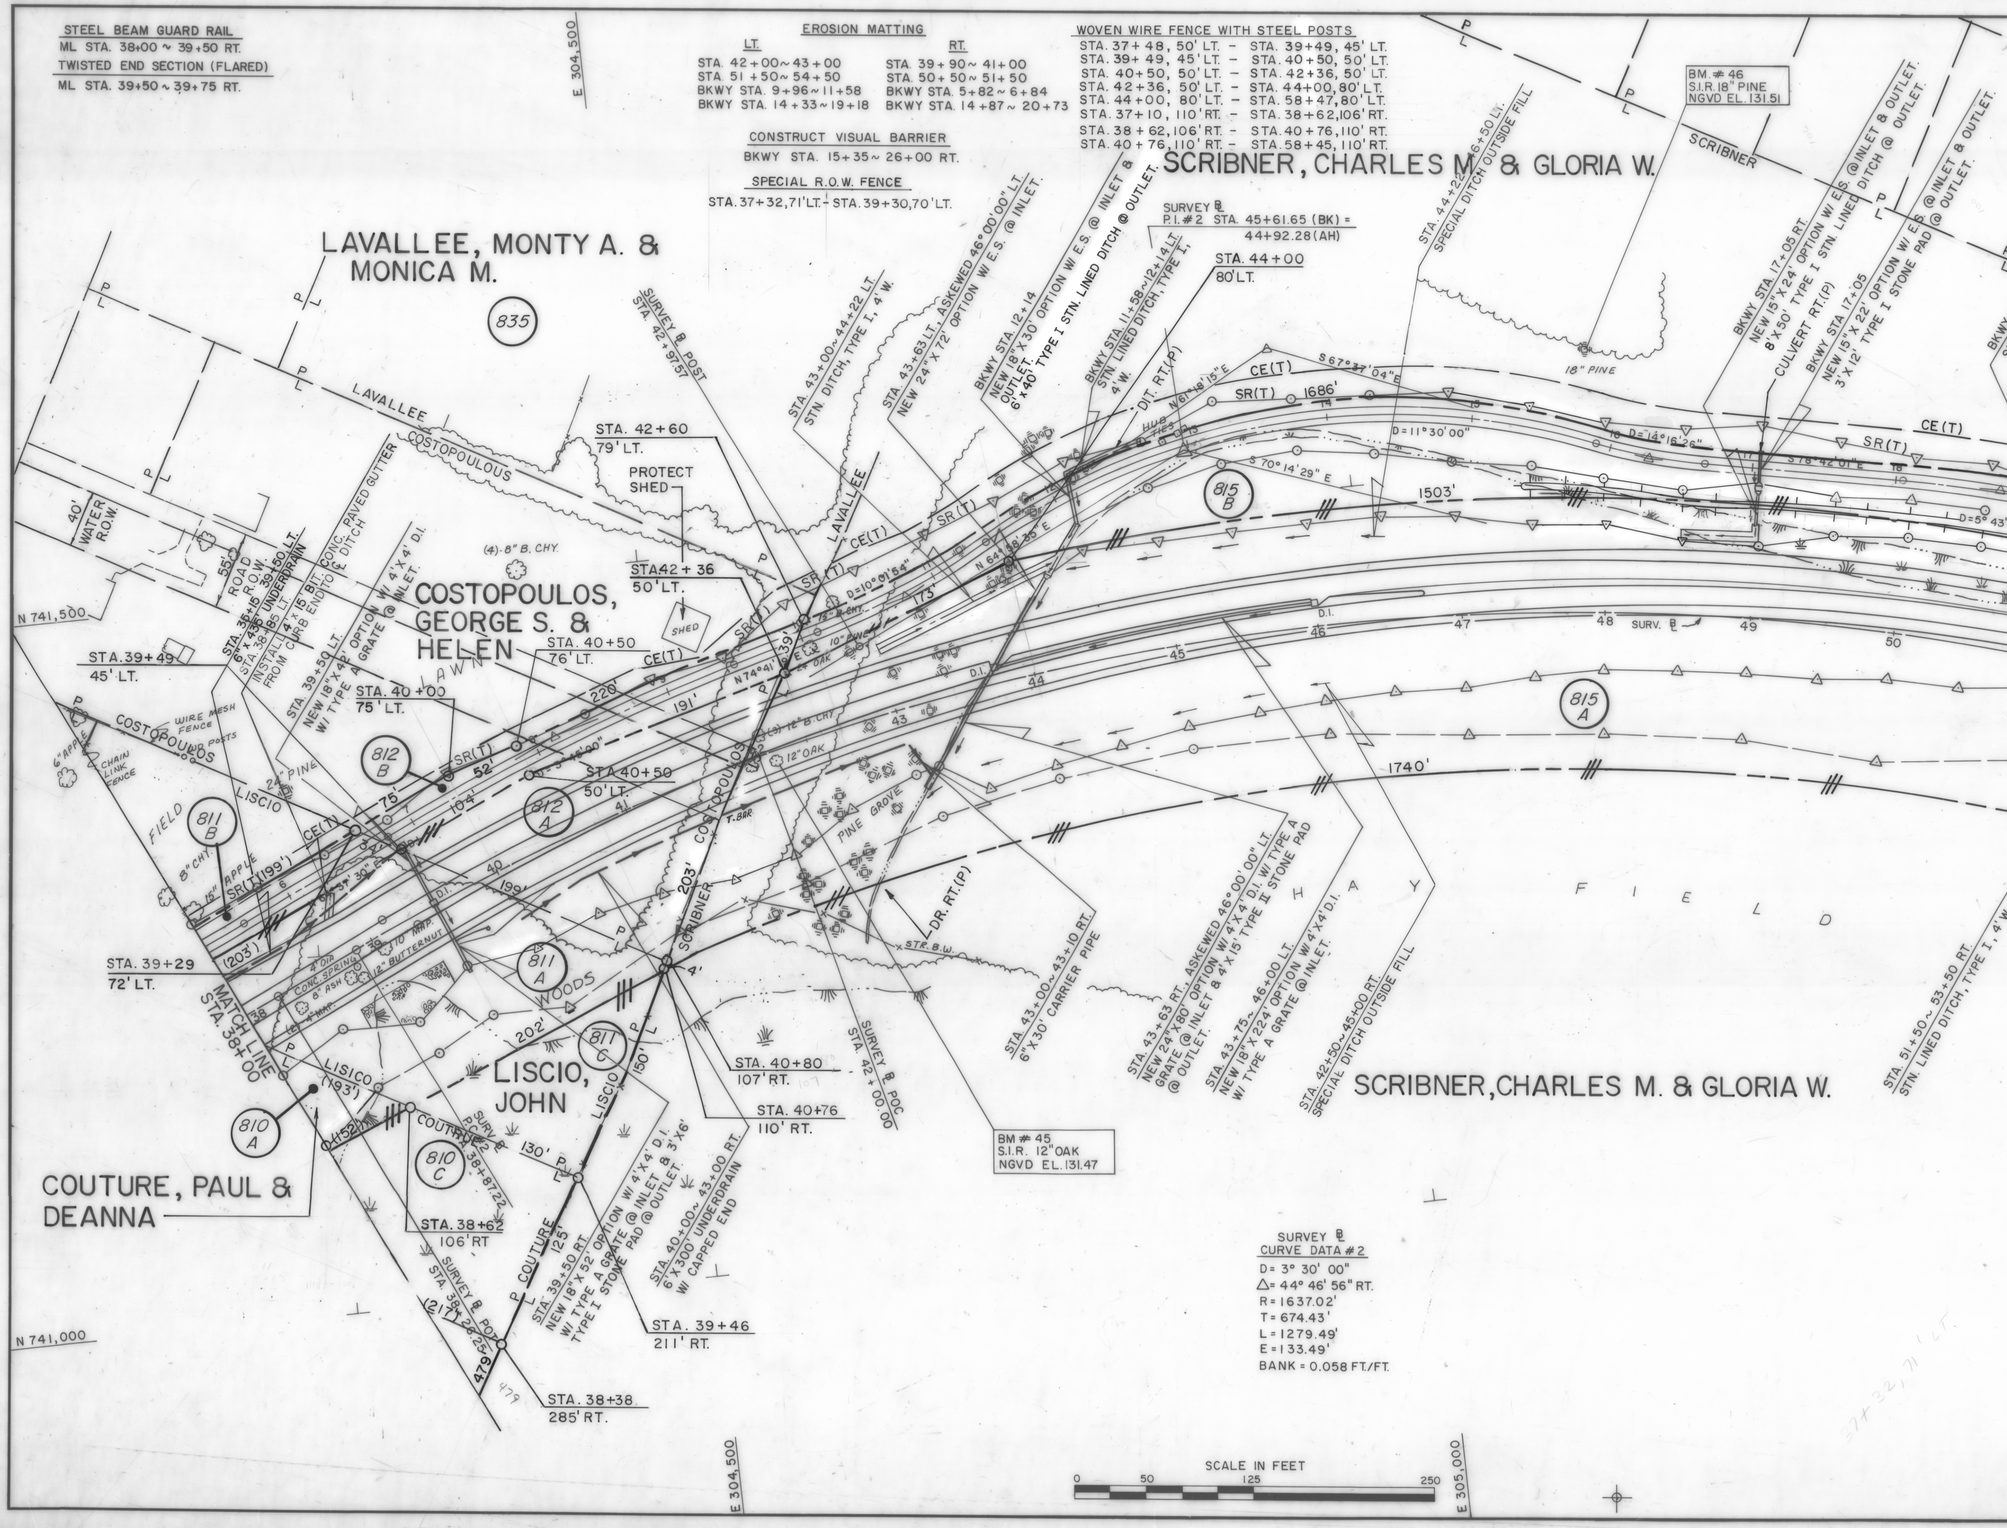
WOVEN WIRE FENCE WITH STEEL POSTS
STA. 37+48, 50' LT. - STA. 39+49, 45' LT.
STA. 39+49, 45' LT. - STA. 40+50, 50' LT.
STA. 40+50, 50' LT. - STA. 42+36, 50' LT.
STA. 42+36, 50' LT. - STA. 44+00, 80' LT.
STA. 44+00, 80' LT. - STA. 58+47, 80' LT.
STA. 37+10, 110' RT. - STA. 38+62, 106' RT.
STA. 38+62, 106' RT. - STA. 40+76, 110' RT.
STA. 40+76, 110' RT. - STA. 58+45, 110' RT.