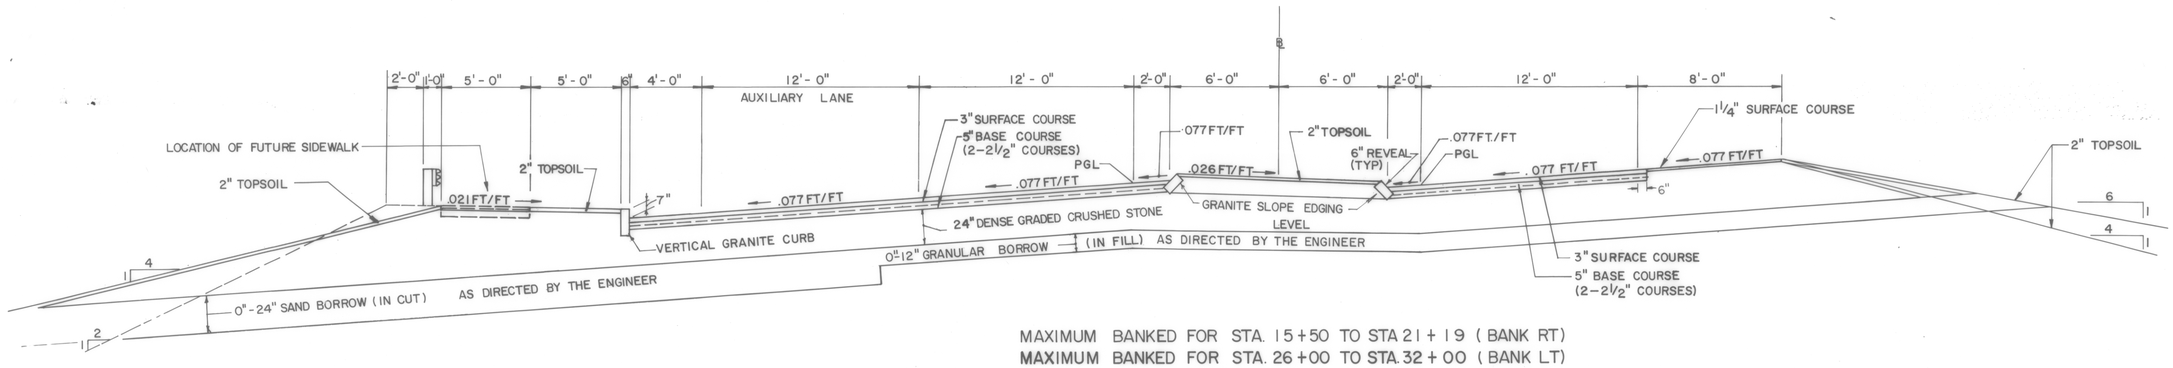

MAXIMUM BANKED FOR STA. 15+50 TO STA 21+19 (BANK RT)
MAXIMUM BANKED FOR STA. 26+00 TO STA. 32+00 (BANK LT)
ROUTE 117

SCALE : 1/4" = 1'-0" VERT.
1/4" = 1'-0" HORIZ.

DATUM
VERTICAL _____
HORIZONTAL _____

SURVEYED BY PINKHAM ENG. DATE 6/86
DRAWN BY S.K.O DATE 1/87
TRACED BY N.P.D DATE 2/87
VERMONT ROUTE 289 (F.A.P.)
TOWN OF ESSEX
PROJ. WILLISTON-COLCHESTER NO. PB 033-1(1)
SHEET 6 OF 31